
#57-68

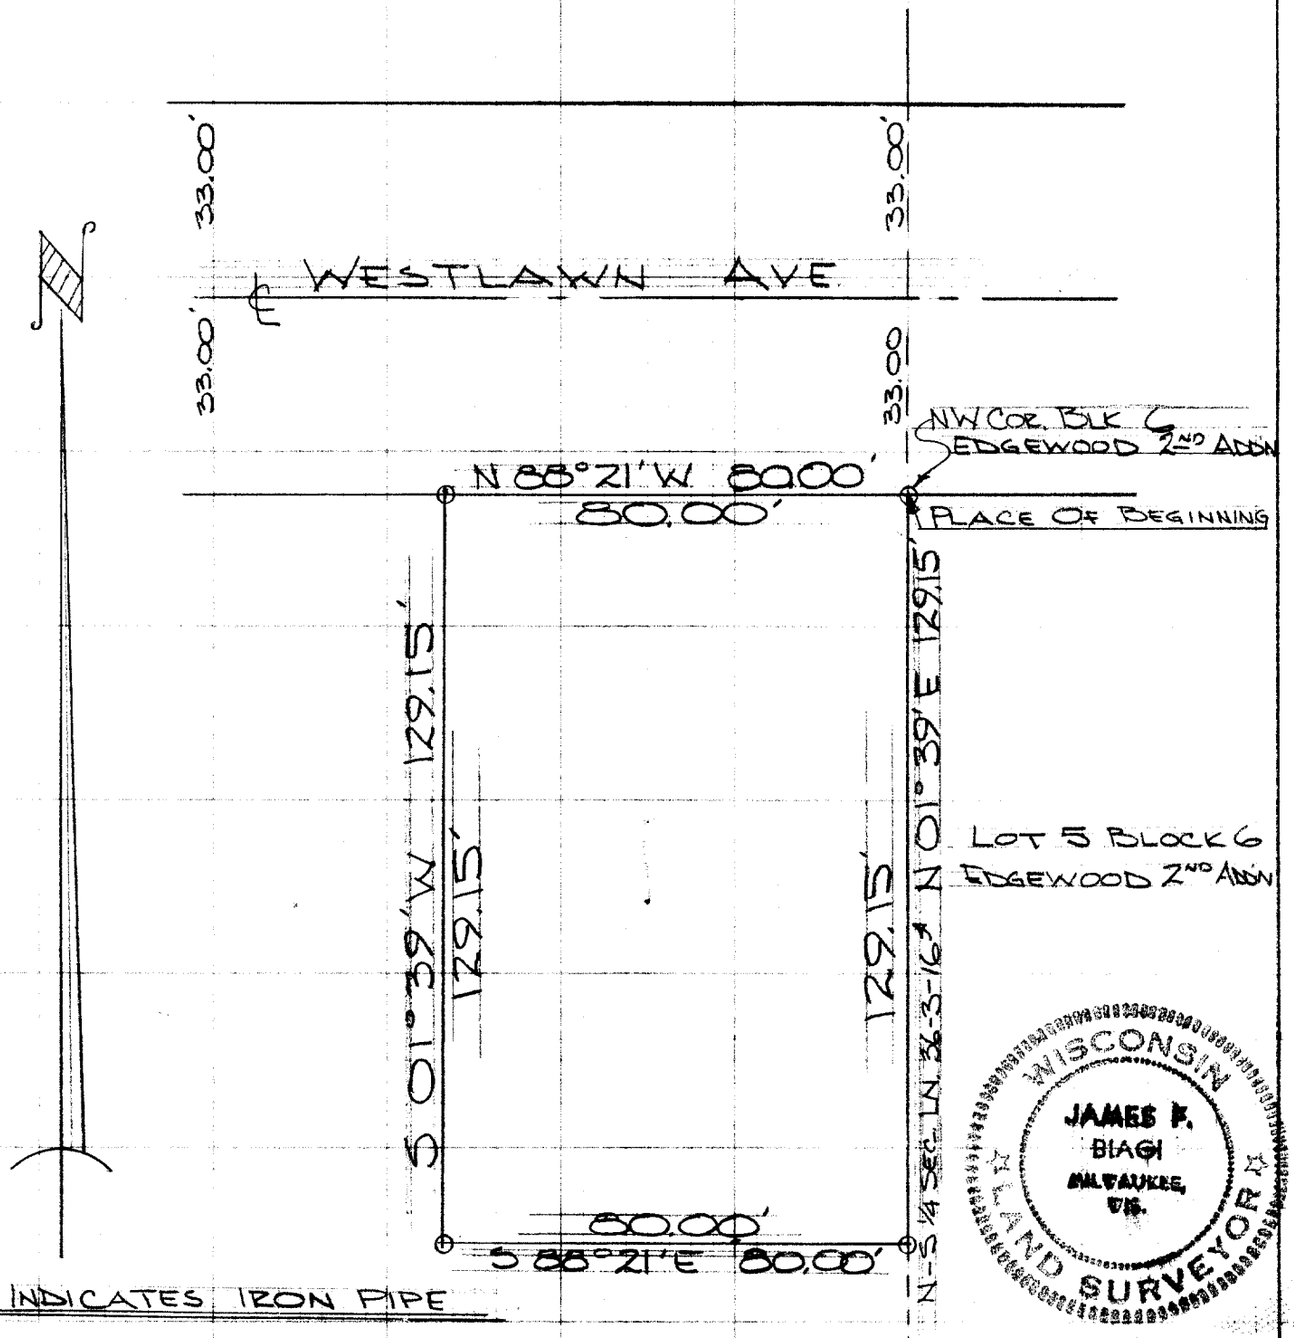

DESCRIPTION: Commencing at the NW corner of Block 6 of Edgewood 2nd. Addition, in the City of Elkhorn, Walworth County, Wisconsin; thence N. 88° 21' W. 80.00 feet, thence S. 01° 39' W. 129.15 feet, thence S. 88° 21' E. 80.00 feet, thence N. 01°39' E. 129.15 feet to the place of beginning.

CERTIFICATE: I, James F. Biagi, surveyor, do hereby certify that I have surveyed the property hereon described.

June 5, 1968.

James F. Biagi, RLS 272

UNW-55

4-326 B