
KOLB LAND CONSULTING, INC.

LAND SURVEYING · SUBDIVIDING · LAND PLANNING

LAKE GENEVA, WISCONSIN 53147 WHITEWATER, WISCONSIN 53190

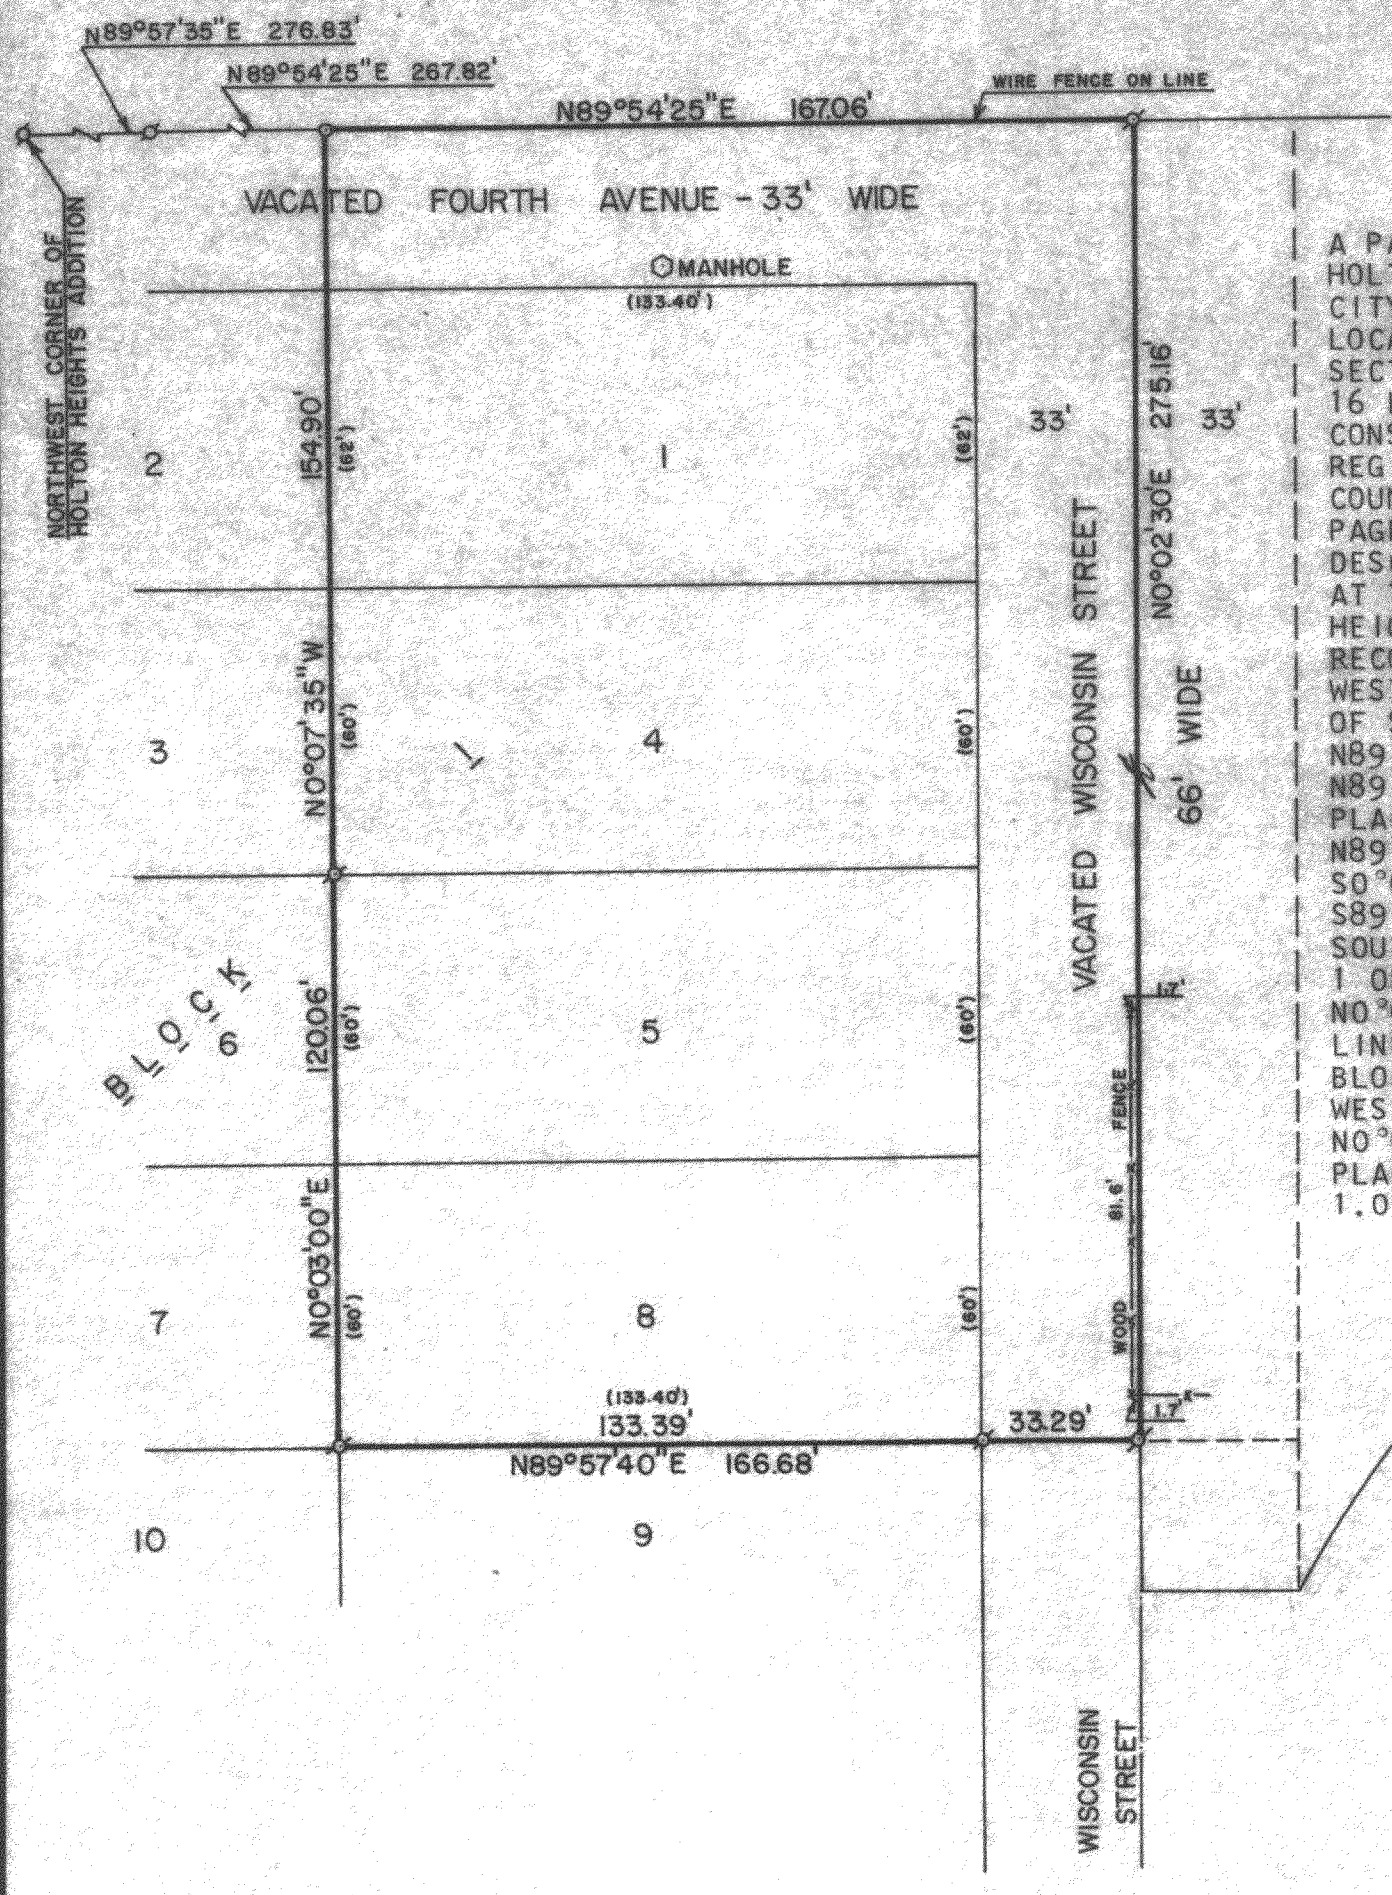

PLAT OF SURVEY OF

A PARCEL OF LAND LOCATED IN HOLTON HEIGHTS ADDITION TO THE CITY OF ELKHORN, A SUBDIVISION LOCATED IN THE NORTHEAST ¼ OF SECTION 36, TOWN 3 NORTH, RANGE 16 EAST, WALWORTH COUNTY, WISCONSIN AND RECORDED IN THE REGISTER OF DEEDS OFFICE OF SAID COUNTY IN VOLUME 7 OF PLATS, PAGE 24, DOCUMENT NO. 221420, AND DESCRIBED AS FOLLOWS: COMMENCING AT THE NORTHWEST CORNER OF HOLTON HEIGHTS ADDITION, SAID CORNER RECORDED AS BEING 1289.3 FEET WEST OF THE NORTHEAST ¼ CORNER OF SAID SECTION 36, THENCE N89°57'35"E 276.83 FEET; THENCE N89°54'25"E 267.82 FEET TO THE PLACE OF BEGINNING; THENCE N89°54'25"E 167.06 FEET; THENCE S0°02'30"W 275.16 FEET; THENCE S89°57'40"W 166.68 FEET TO THE SOUTHWEST CORNER OF LOT 8, BLOCK 1 OF SAID SUBDIVISION; THENCE N0°03'00"E ALONG THE WESTERLY LINE OF LOTS 5 AND 8 OF SAID BLOCK 1 120.06' TO THE NORTHWESTERLY CORNER OF LOT 5; THENCE N0°07'35"W 154.90 FEET TO THE PLACE OF BEGINNING. CONTAINING 1.05 ACRES OF LAND.

ORDERED BY: HAROLD WOODHOUSE

SCALE: 1"=40'

ø - IRON PIPE FOUND
o - IRON PIPE PLACED
( ) - RECORDED AS

WISCONSIN HAROLD H. KOLB S-187 LAKE GENEVA, WIS LAND SURVEYOR

I HEREBY CERTIFY THAT I HAVE SURVEYED THE ABOVE DESCRIBED PROPERTY AND THAT THE ABOVE MAP IS A TRUE REPRESENTATION THEREOF AND SHOWS THE SIZE AND LOCATION OF THE PROPERTY, ITS EXTERIOR BOUNDARIES, THE LOCATION OF ALL VISIBLE STRUCTURES AND DIMENSIONS OF ALL PRINCIPAL BUILDINGS THEREON, BOUNDARY FENCES, APPARENT EASEMENTS, ROADWAYS AND VISIBLE ENCROACHMENTS, IF ANY.

THIS SURVEY IS MADE FOR THE USE OF THE PRESENT OWNERS OF THE PROPERTY, AND ALSO THOSE WHO PURCHASE, MORTGAGE, OR GUARANTEE THE TITLE THERETO WITHIN ONE (1) YEAR FROM DATE HEREOF.

Harold H. Kolb

HAROLD H. KOLB
WISCONSIN REGISTERED LAND SURVEYOR, S- 187

DATE March 30, 1992

YHT-1

4-326-K