
59-37

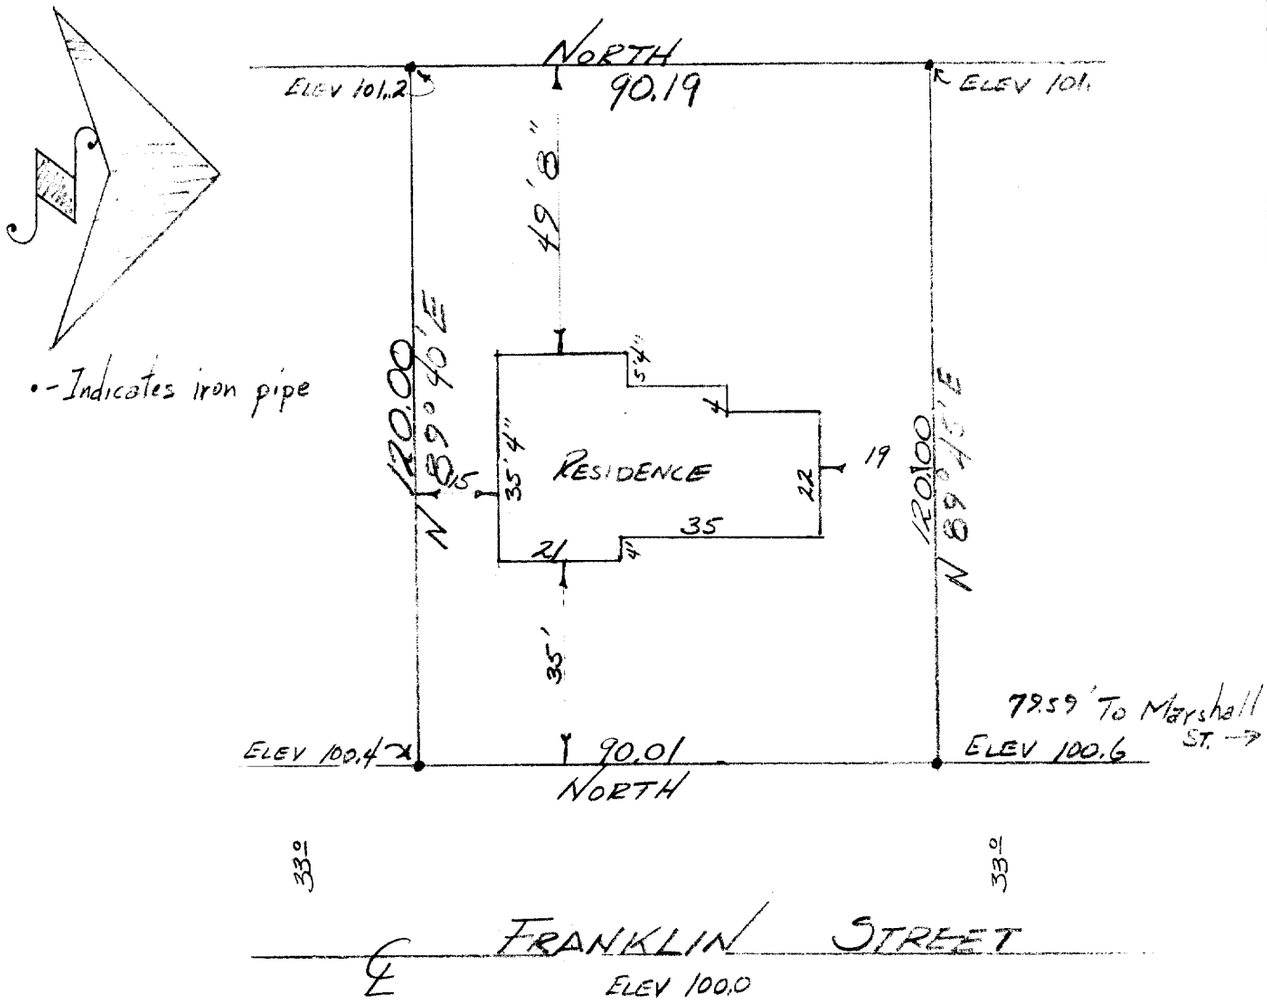

•-Indicates iron pipe

DESCRIPTION: Lot 2 and the North 10.42 feet of lot3 of Block 3 of James Jones 2nd addition to the City of Elkhorn, Walworth County, Wisconsin.

CERTIFICATE: I James F. Biagi, surveyor, do hereby certify that I have surveyed the property hereon described and that the measurements shown on the drawing above are true and accurate.

SIGNED AND SEALED THIS 3RD DAY OF JULY 1959

WISCONSIN JAMES F. BIAGI MILWAUKEE, WIS. LAND SURVEYOR

James F Biagi
(Surveyor 272)

4-32B

VJA 239