
SC-25-8H #93-68

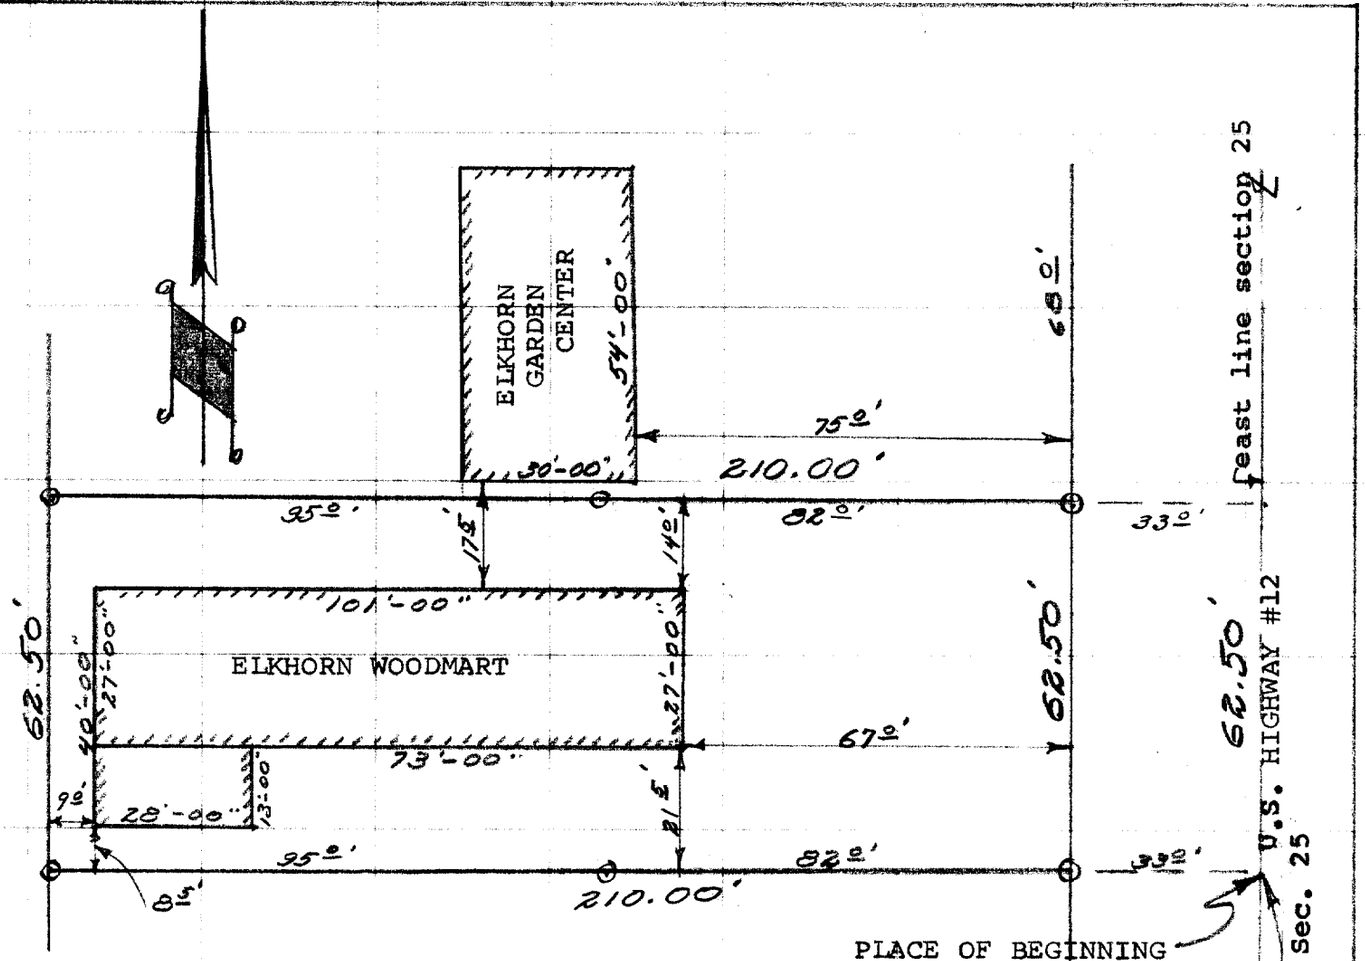

o Indicates, Iron Pipe

DESCRIPTION:

Commencing at a point in the east line of Section 25, Town 3 north, Range 16 east, which is 635.60 feet North of the ~~southeast corner of said section, thence~~ North 62.50 feet, thence West 210.00 feet, thence South 62.50 feet, thence 210.00 feet to the place of beginnibg.

CERTIFICATE:

I, James F. Biagi, surveyor do hereby certify that I ~~have surveyed the property hereon described~~ on this the 19th day of July, 1968.

James F. Biagi.
RLS. 272
Elkhorn, Wisconsin.

Dated July 22nd 1968.

4 ~~316~~ 335B

Part of SC-25-8H (now UNW.234)