
52-2

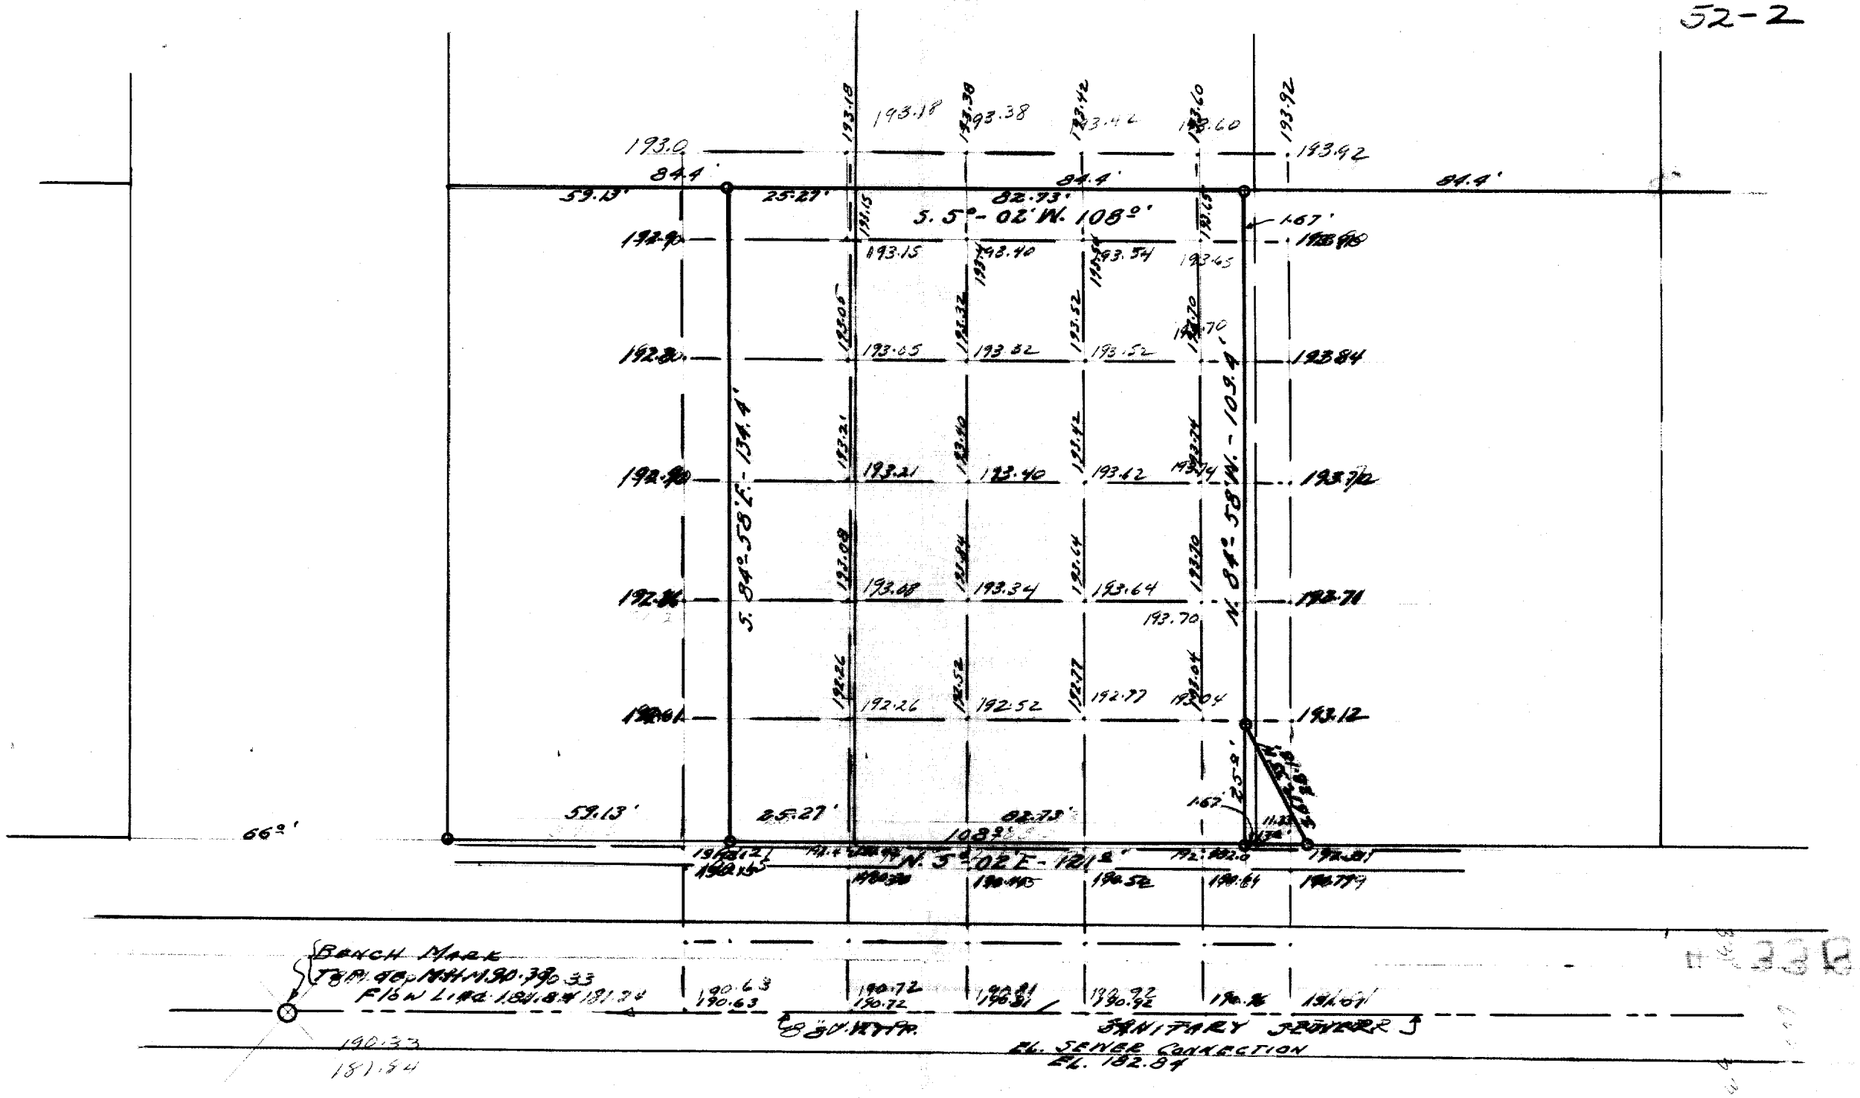

Y* MISC
YA-938-2

4-34 B