COOPER SURVEYING SERVICES
Rural - Residential - Commercial


DANIEL D. COOPER
Registered Land Surveyor

Route 3, Box 235 :: Elkhorn, Wisconsin 53121

Phone (414) 723-6365

SURVEYING & PLANNING
SUBDIVISIONS - LOT SURVEYS
CONSTRUCTION STAKING - MAPPING

JEFFERSON STREET

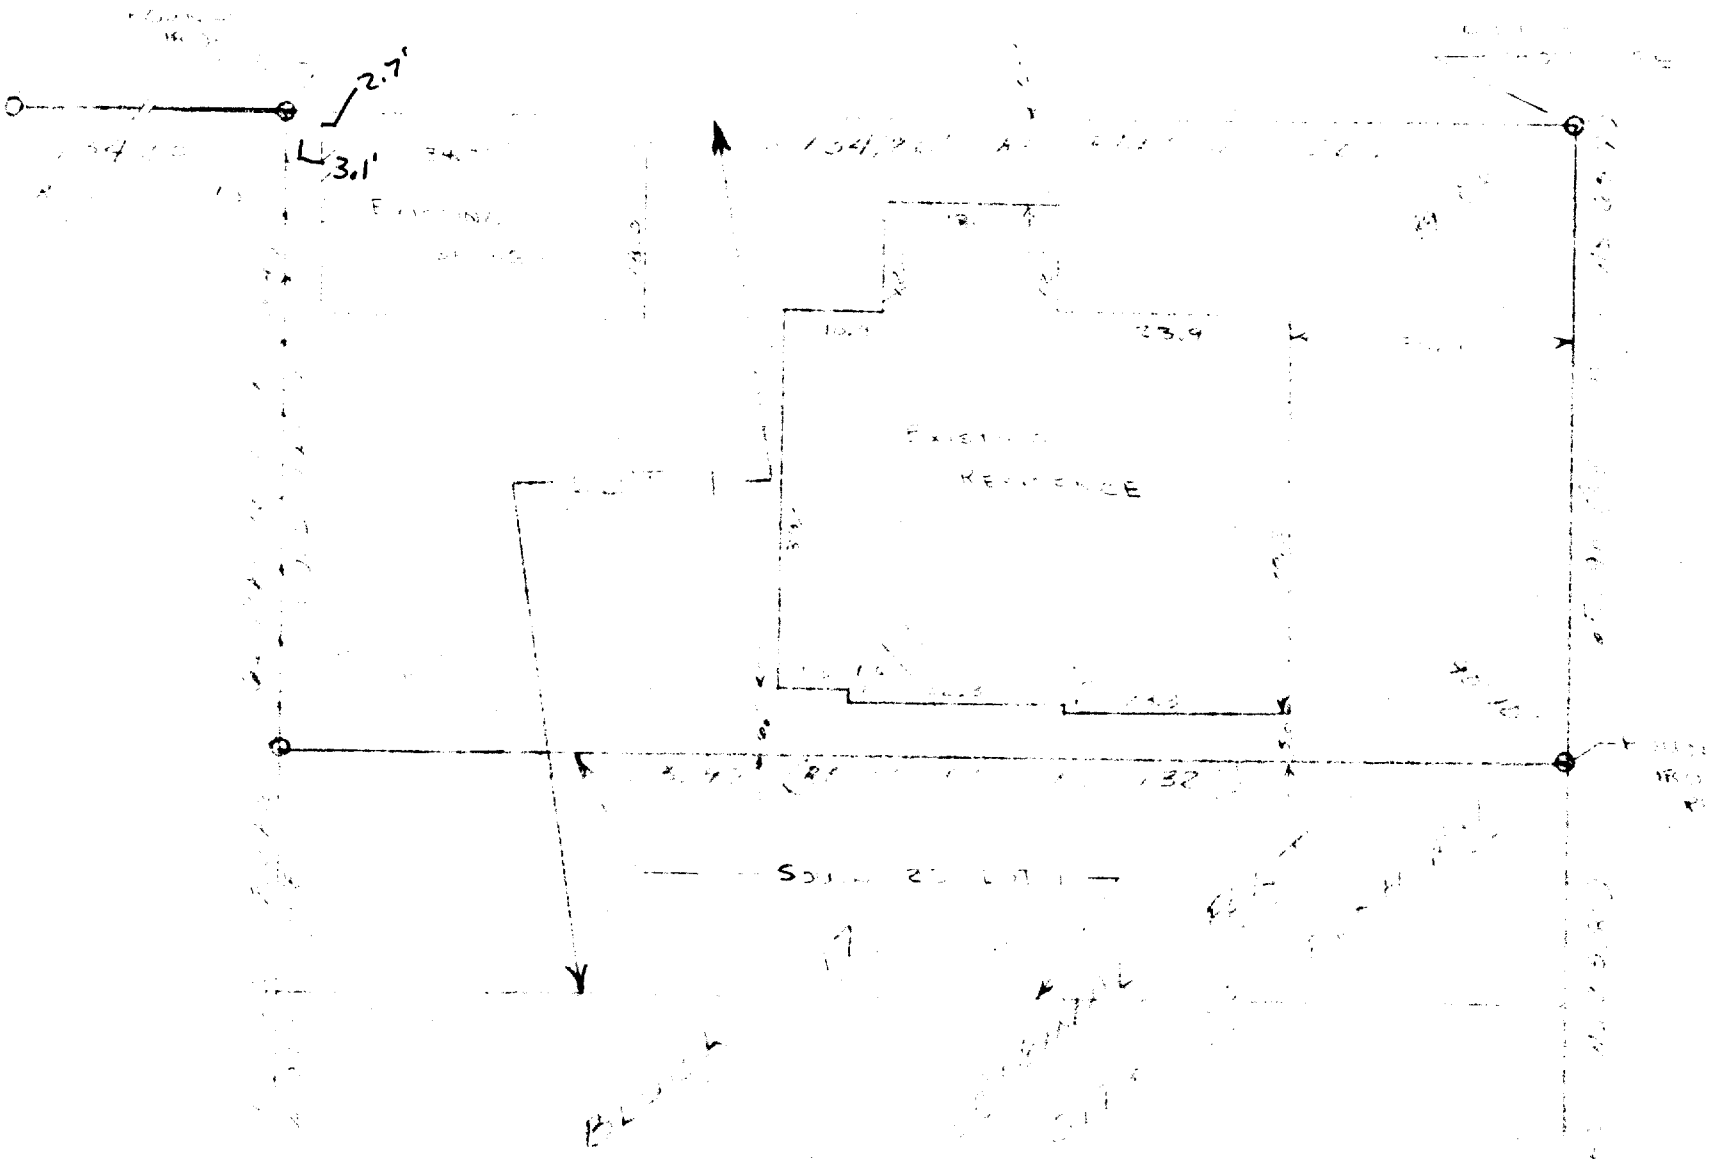

Plat of Survey of Lot 1 of Block 17 of the Original Plat of the City of Elkhorn, Walworth County Wisconsin. Excepting the Southerly 25 feet thereof.

Work ordered by Atty. Richard Howarth

I hereby certify that I have surveyed the property described hereon and that the above map is a true representation thereof and shows the size and location of the property as it was found to be monumented, the location of visible structures and all principal buildings thereon. This survey is made for the present owners of the property and also those who purchase, mortgage, or guarantee the title thereto within one year from the date thereof.

Dated this 26 day of Oct, 1982

Daniel D. Cooper

Daniel D. Cooper, RLS, No. S-1464

WISCONSIN
DANIEL D. COOPER
S-1464
ELKHORN, WI.
LAND SURVEYOR

Yop-112

4-342F