
# PLAT OF SURVEY OF
THE SOUTH 1 ROD OF LOT 4 AND THE NORTH 3 1/2 RODS OF LOT 5 IN BLOCK 28
OF THE ORIGINAL PLAT OF ELKHORN, WALWORTH CO., WIS.
FOR
JEAN BIELSKI

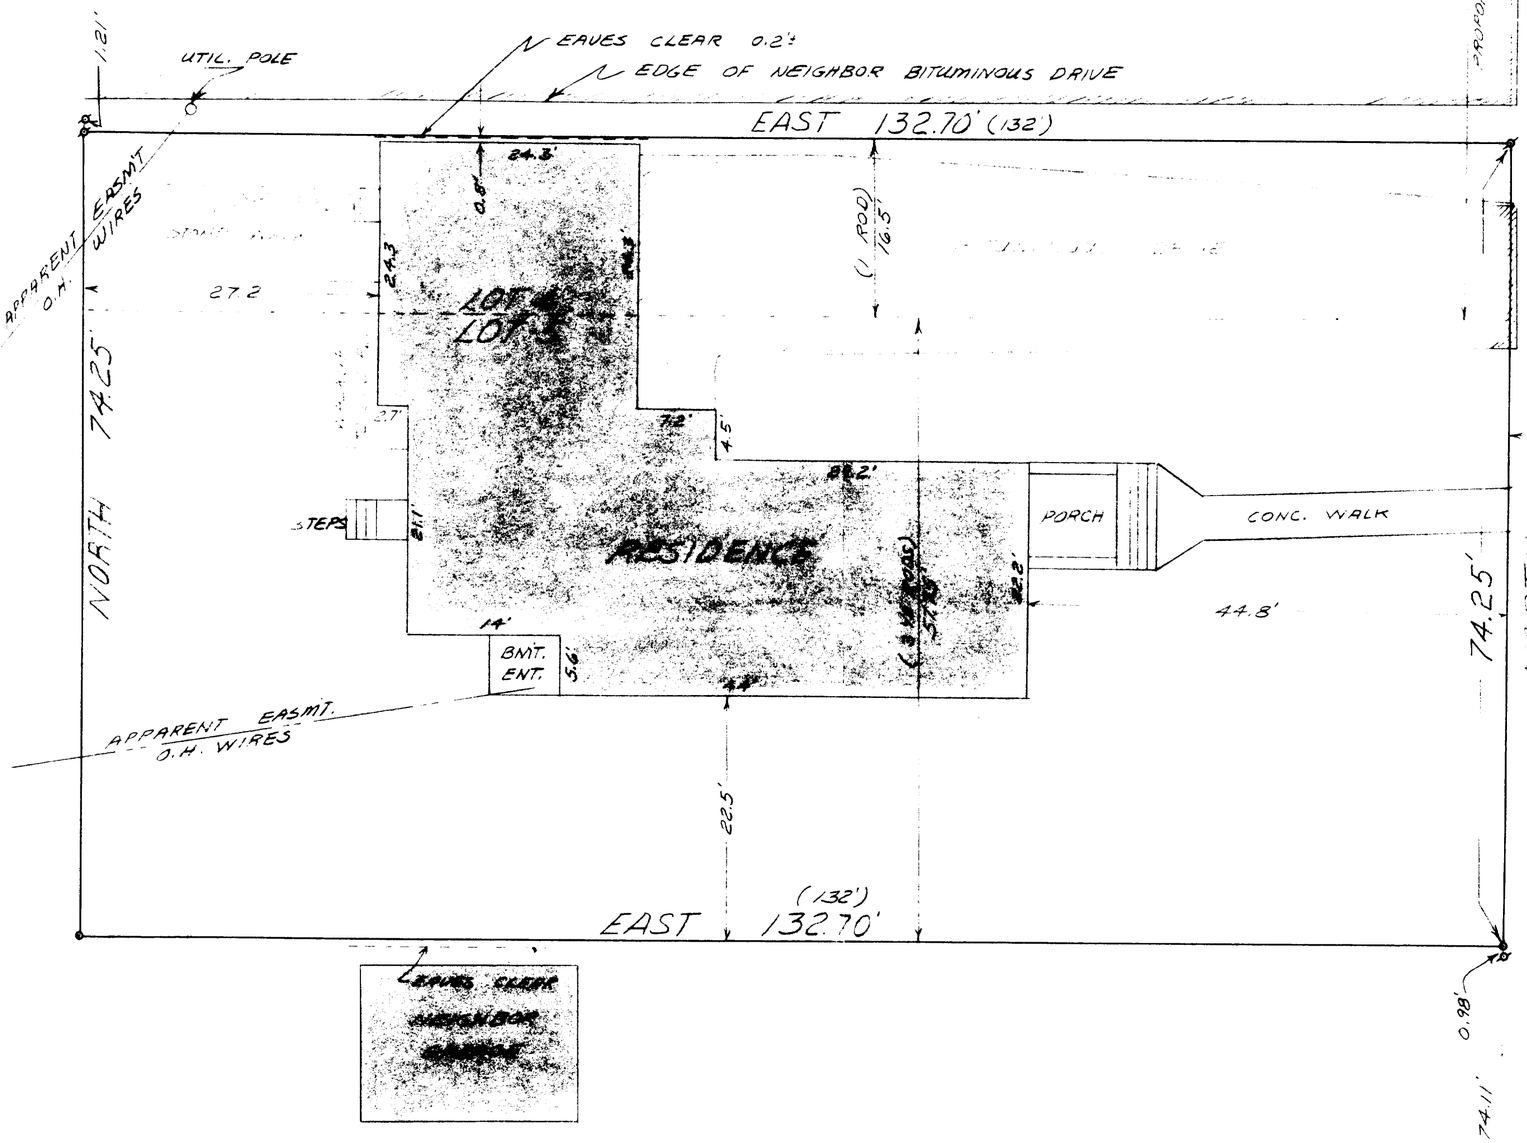


## LEGEND

ø = IRON PIPE SURVEY STAKE FOUND
⊙ = IRON PIPE SET 1"X24"X 1.13 lb/ft.
(XXXX) = RECORD DIMENSION

I hereby certify that I have surveyed the above described property and that the above map is a true representation thereof and shows the size and location of all buildings thereon, boundary fences, apparent easements, roadways and visible encroachments, if any.
This survey is made for the use of the present owners of the property, and also those who purchase, mortgage, or guarantee the title thereto within one (1) year from the date hereof.

Robert A. Farris
ROBERT A. FARRIS
5/23/84

WISCONSIN
ROBERT A FARRIS
S-1293
ELKHORN
WIS
LAND SURVEYOR


**Farris, Hansen & Associates, Inc.**
Engineering, Surveying & Land Planning
P.O. BOX 487
715 W. WALWORTH STREET
ELKHORN, WISCONSIN 53121


4-349
DATE: MAY 23, 1984
PROJECT NO. 2251

CP-255