
FARRIS HANSEN & ASSOCIATES INC.
7 RIDGEWAY COURT P.O. BOX 487, ELKHORN, WISCONSIN

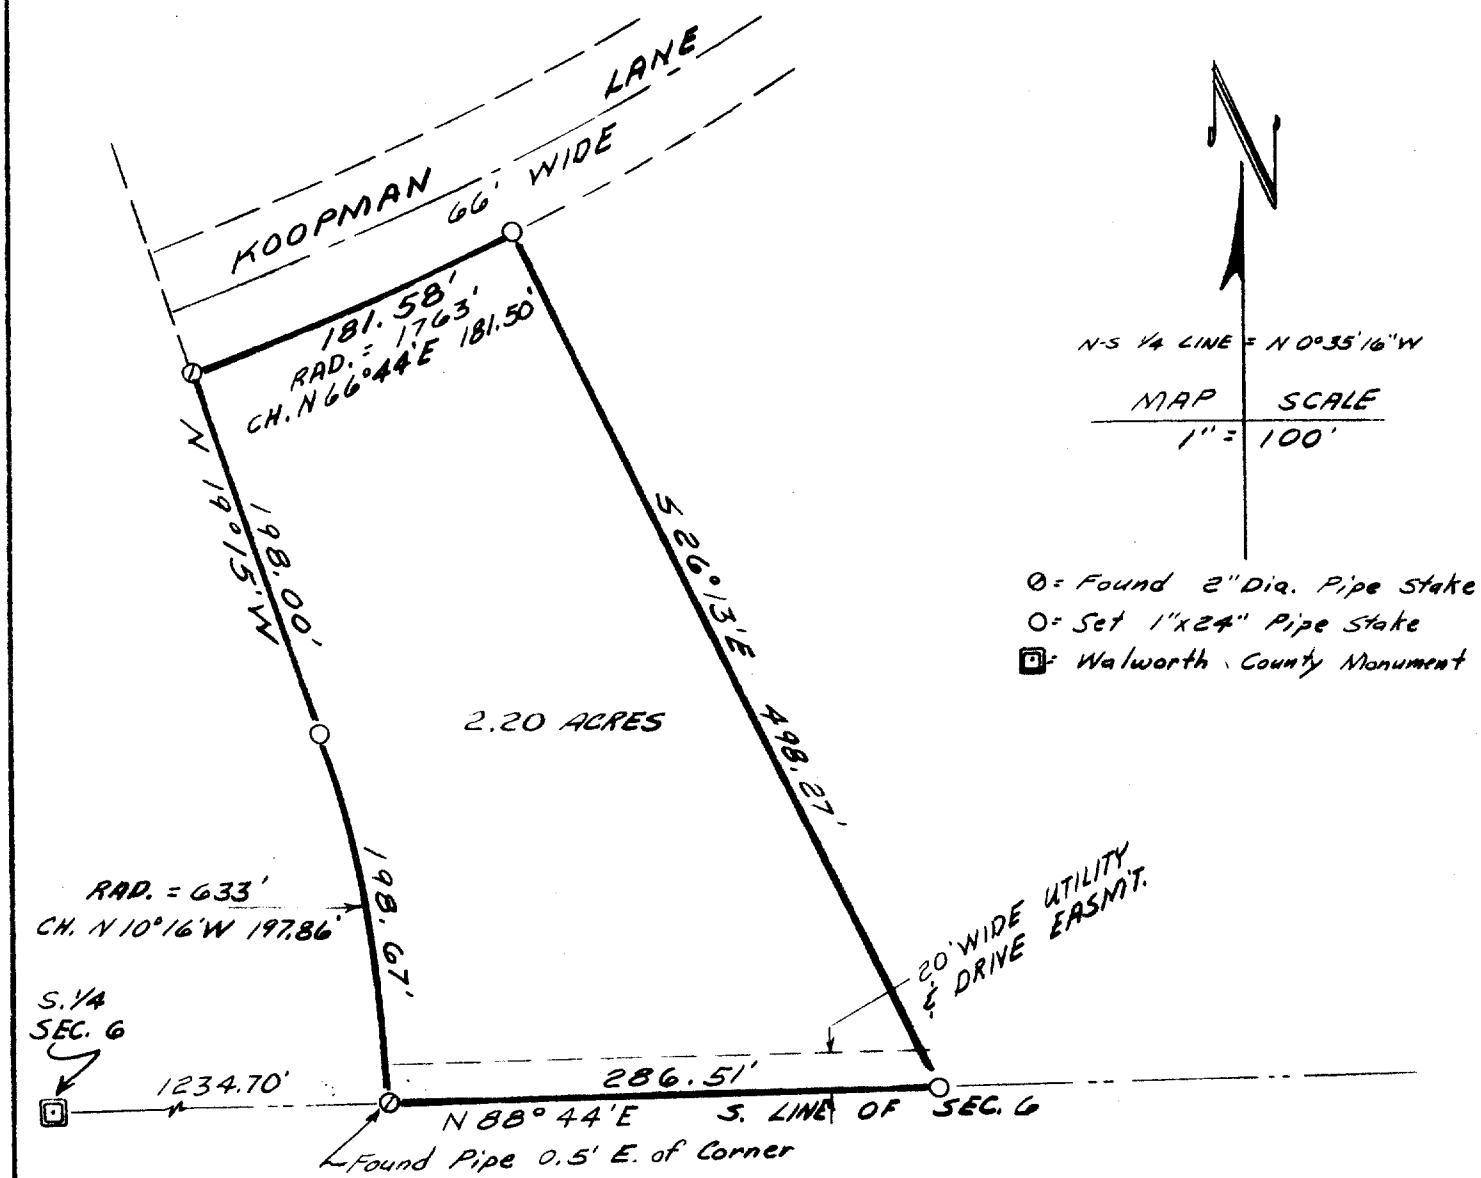

PLAT OF SURVEY OF

Part of the Southeast 1/4 of Section 6, Town 2 North, Range 17 East, City of Elkhorn, Walworth County, Wisconsin, described as follows:

Beginning at a point in the south line of said Section 6 loacated N 88° 44' E 1234.70 feet from the South 1/4 corner of said Section 6; thence Northwesterly 198.67 feet along the arc of a curve to the left having a radius of 633.00 feet and chord N 10° 16' W 197.86 feet to an iron pipe; thence N 19° 15' W 198.00 feet to an iron pipe; thence Northeasterly 181.58 feet along the southerly right of way of Koopman Lane being the arc of a curve to the left having a radius of 1763 feet and chord N 66° 44' E 181.50 feet; thence S 26° 13' E 498.27 feet to the south line of said Section; thence S 88° 44' W 286.51 feet to the point of beginning, containing 2.20 acres more or less.

I HEREBY CERTIFY that this plat of survey is a true and accurate representation of the exterior boundaries of the property described to the best of my professional knowledge and belief.

WISCONSIN
ROBERT A FARRIS
S-1293
ELKHORN
WIS
LAND SURVEYOR

Dated this 7th day of Jan. 1985

Robert A. Farris RLS

VSF-17C2

PROJ. # 2349

4-365