
PLAT OF SURVEY PART OF SE¼ SW¼ SEC. 31, T. 3N., R. 17E., CITY OF ELKHORN, WALWORTH CO., WISCONSIN

TAX PARCEL NO. UNE-28

RECEIVED
JUL 30 1985
W. L.

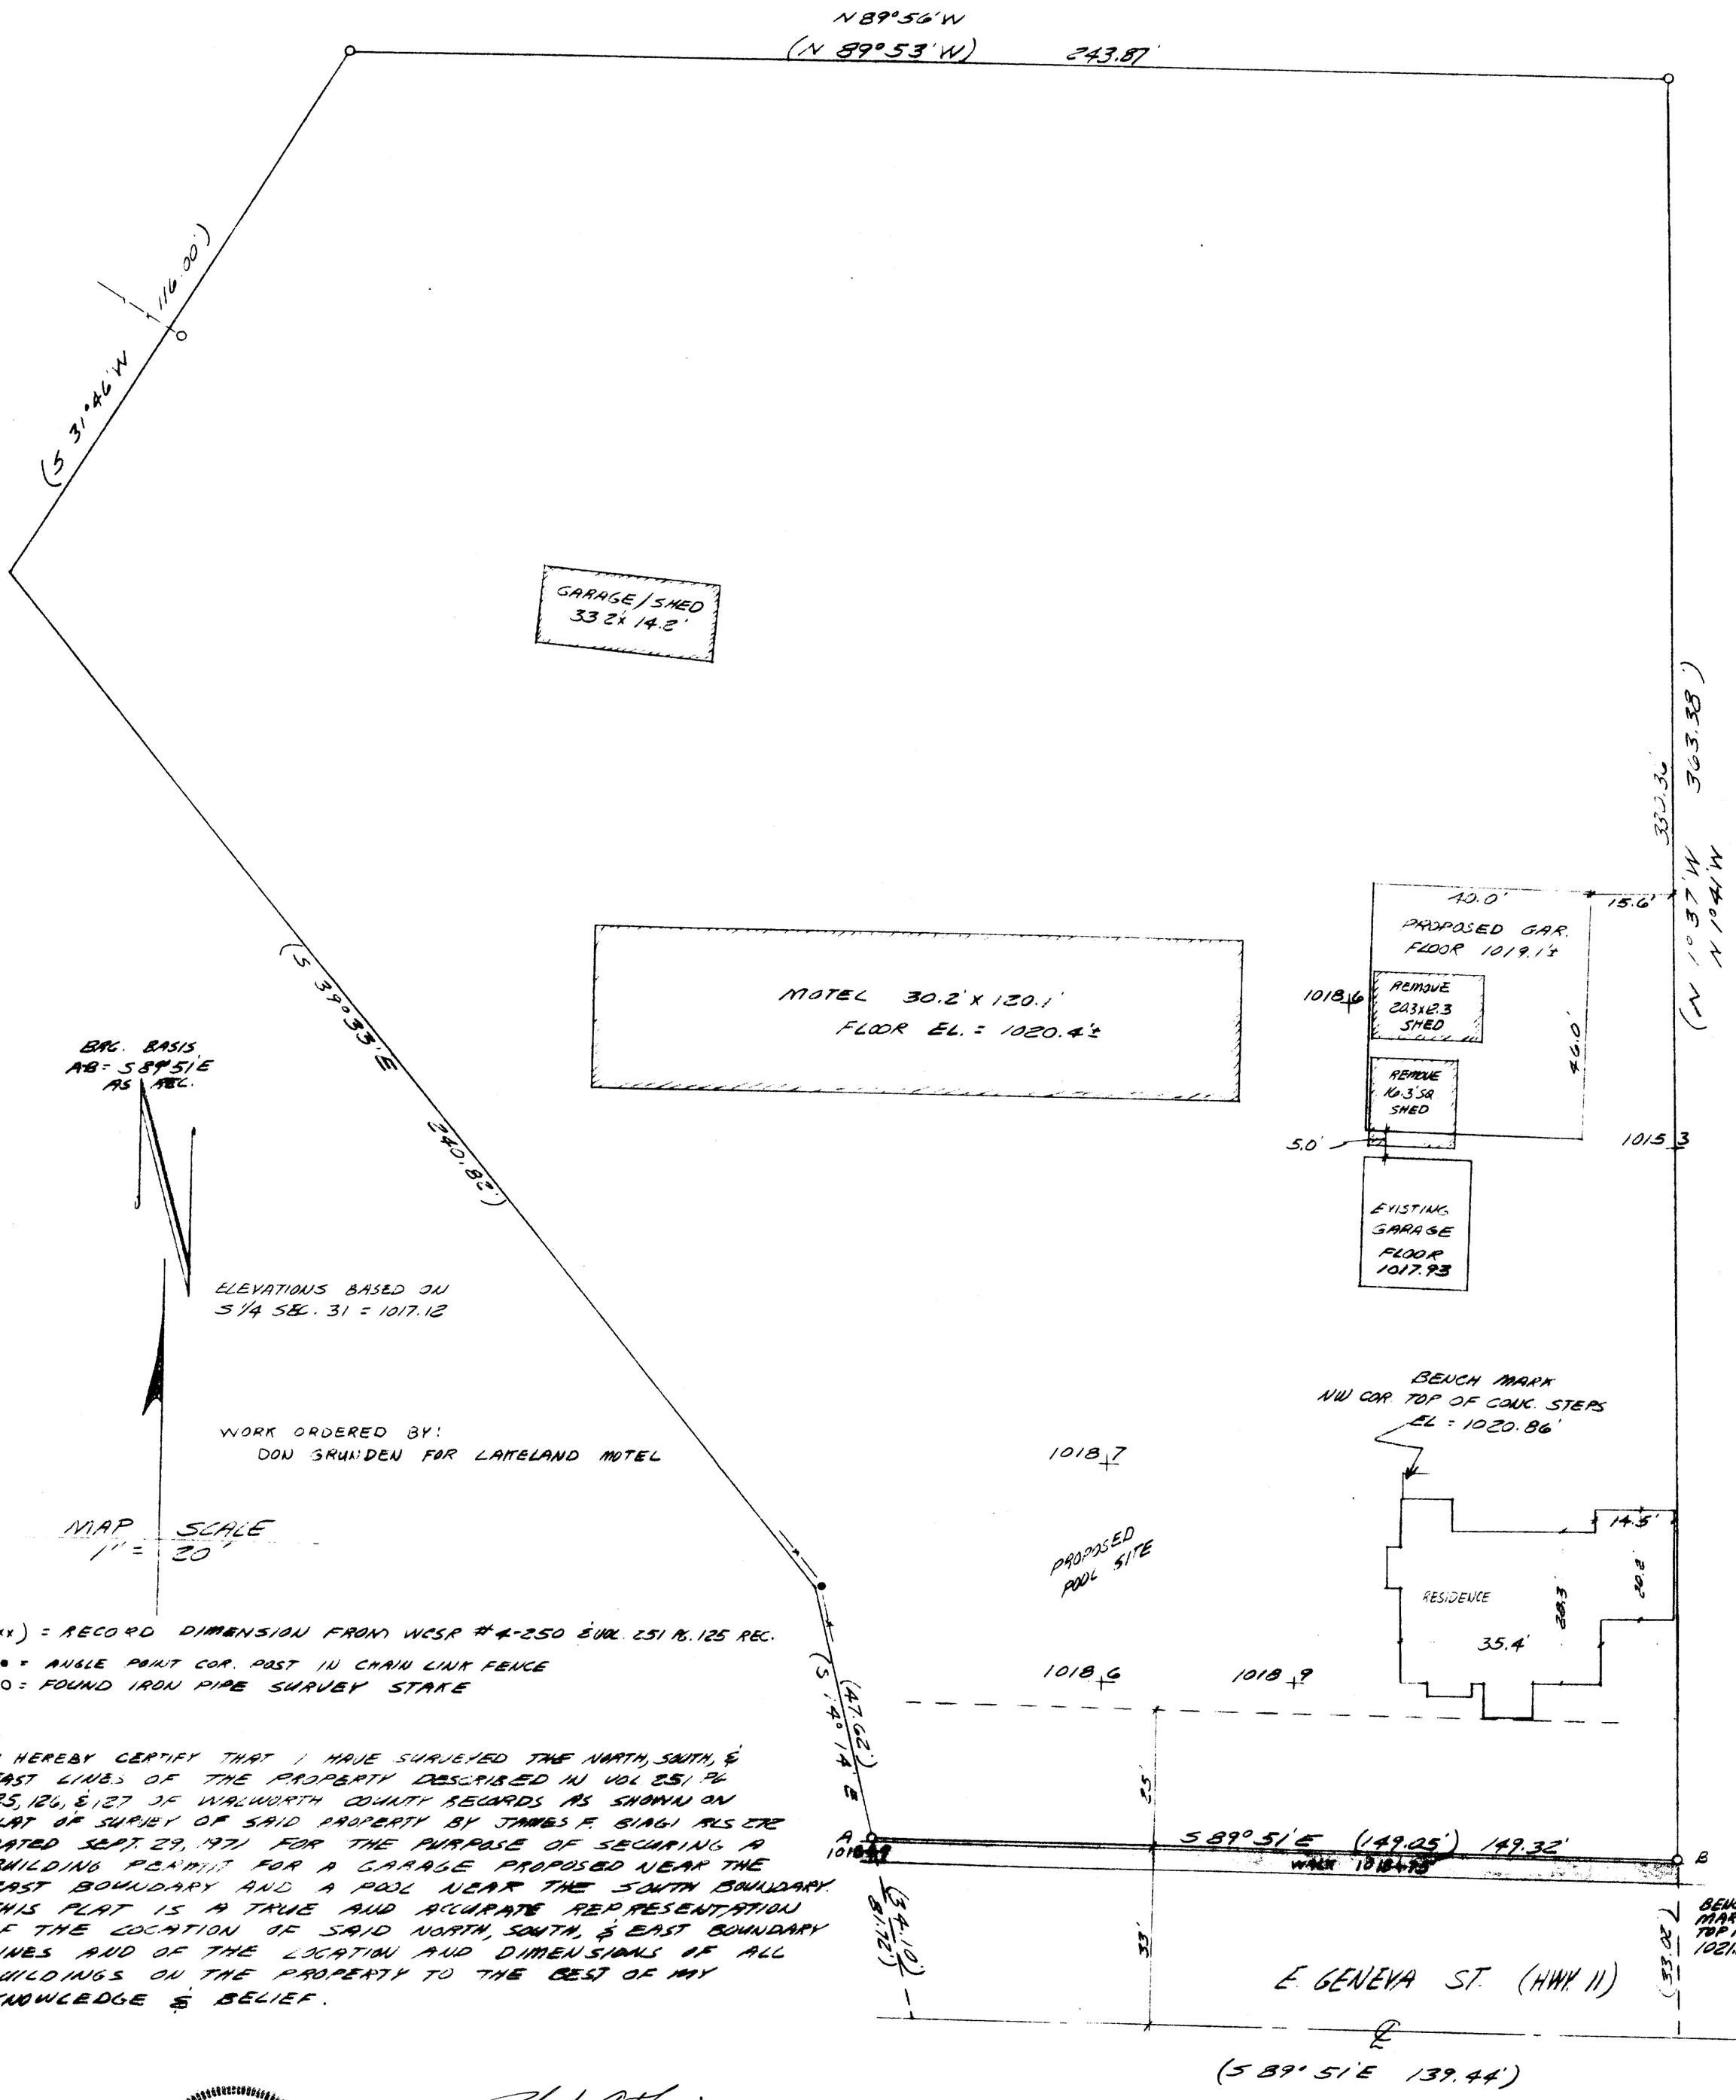

I HEREBY CERTIFY THAT I HAVE SURVEYED THE NORTH, SOUTH, & EAST LINES OF THE PROPERTY DESCRIBED IN VOL 251 PG 125, 126, & 127 OF WALWORTH COUNTY RECORDS AS SHOWN ON PLAT OF SURVEY OF SAID PROPERTY BY JAMES F. BIAGI RLS ETC DATED SEPT. 29, 1971 FOR THE PURPOSE OF SECURING A BUILDING PERMIT FOR A GARAGE PROPOSED NEAR THE EAST BOUNDARY AND A POOL NEAR THE SOUTH BOUNDARY. THIS PLAT IS A TRUE AND ACCURATE REPRESENTATION OF THE LOCATION OF SAID NORTH, SOUTH, & EAST BOUNDARY LINES AND OF THE LOCATION AND DIMENSIONS OF ALL BUILDINGS ON THE PROPERTY TO THE BEST OF MY KNOWLEDGE & BELIEF.

WISCONSIN
ROBERT A. FARRIS
S-1299
ELKHORN
WIS
LAND SURVEYOR

Robert A. Farris
DATED 6/17/85

FARRIS, HANSEN & ASSOCIATES INC.
7 RIDGEWAY CT P.O. BX 487
ELKHORN, WIS.

(XXX) = RECORD DIMENSION FROM WCSR #4-250 & VOL. 251 PG. 125 REC.
• = ANGLE POINT COR. POST IN CHAIN LINK FENCE
O = FOUND IRON PIPE SURVEY STAKE

PROJECT # 248
4-372-F

YUNE-28