
#114-69

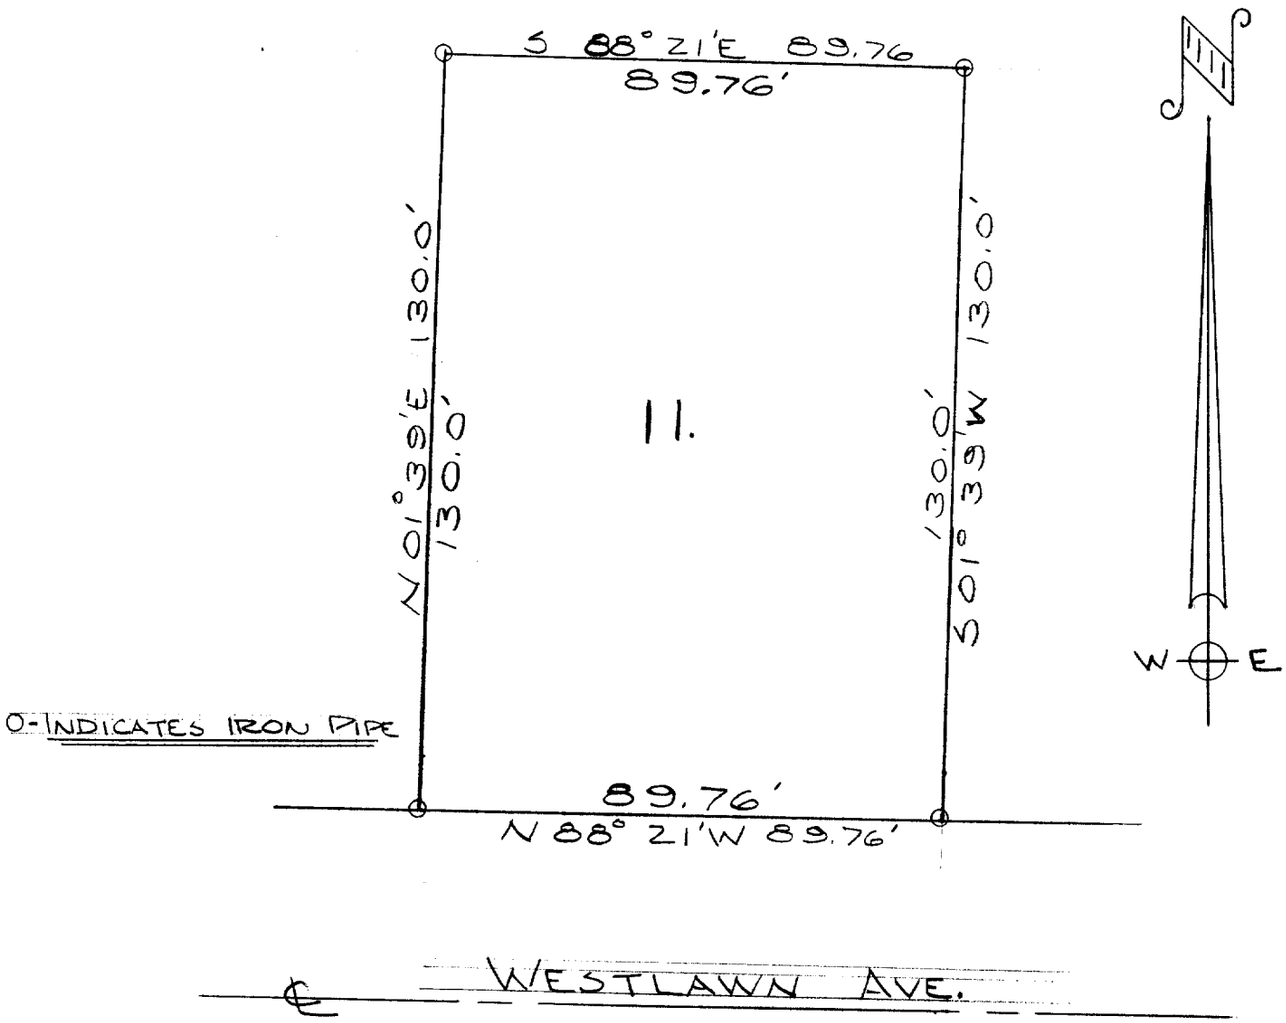

DESCRIPTION: Lot 11 of Block 3 of Edgewood Second Addition in the City of Elkhorn, Walworth County, Wisconsin.

CERTIFICATE: I, James F. Biagi, surveyor, do hereby certify that I have surveyed the property hereon described.

James F. Biagi, R.L.S. 272

August 5, 1969

WISCONSIN JAMES F. BIAGI MILWAUKEE, WIS. LAND SURVEYOR

YEAR-3

4-3B