
RECEIVED
JAN 3 1986

FARRIS, HANSEN & ASSOCIATES, INC.
ENGINEERING, SURVEYING & LAND PLANNING
7 HIGGINS ST. -BOX 429-ELKHORN, WIS.
PHONE 414-723-2222

OWNER:
CITY OF ELKHORN

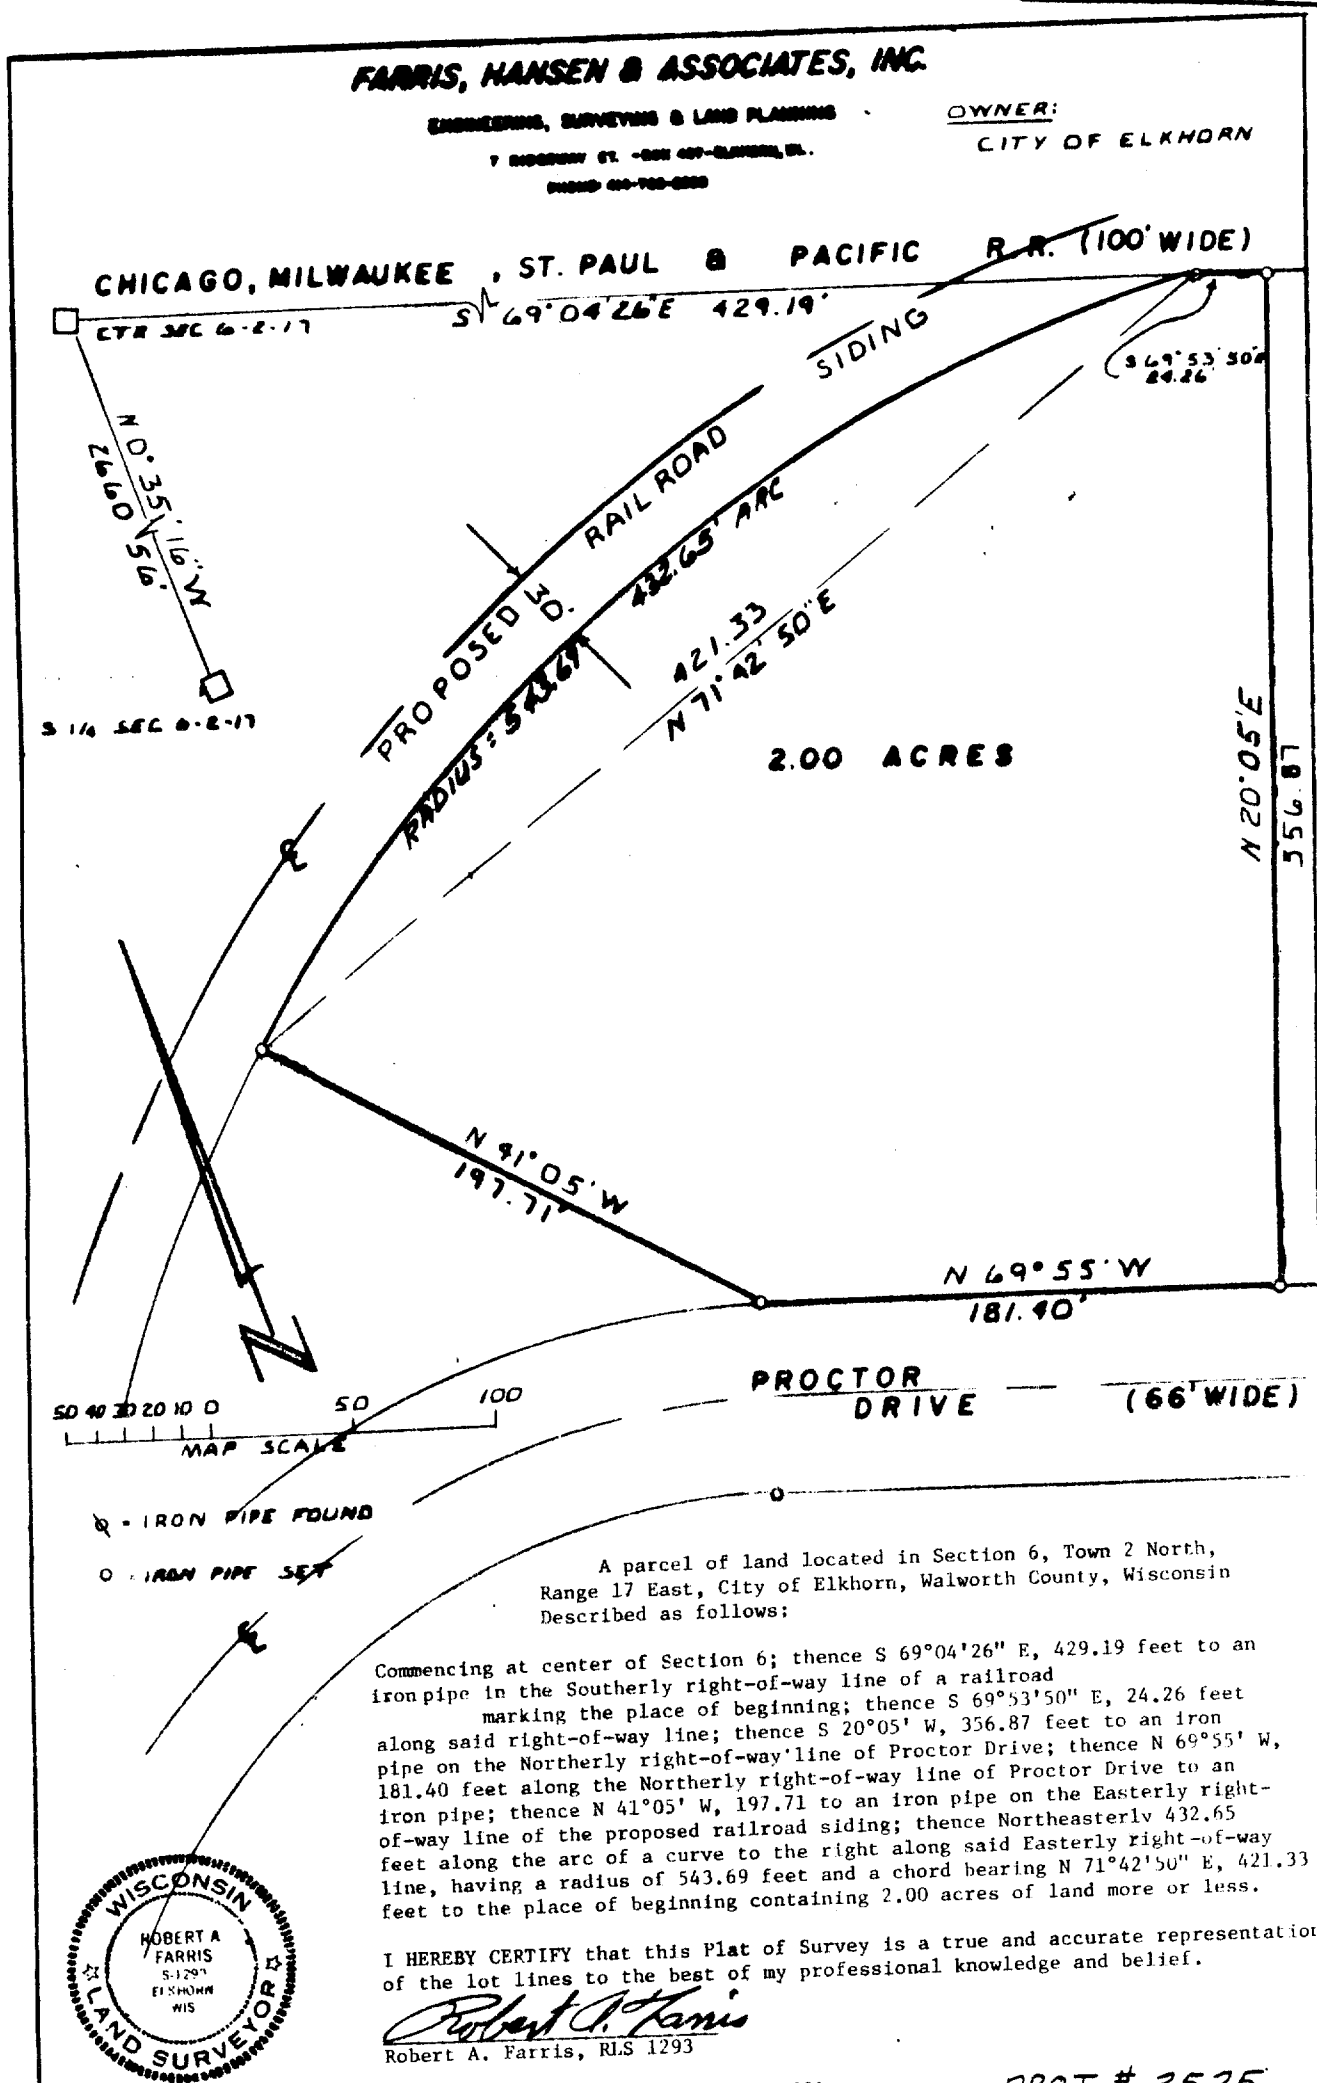

A parcel of land located in Section 6, Town 2 North, Range 17 East, City of Elkhorn, Walworth County, Wisconsin Described as follows:

Commencing at center of Section 6; thence S 69°04'26" E, 429.19 feet to an iron pipe in the Southerly right-of-way line of a railroad marking the place of beginning; thence S 69°53'50" E, 24.26 feet along said right-of-way line; thence S 20°05' W, 356.87 feet to an iron pipe on the Northerly right-of-way line of Proctor Drive; thence N 69°55' W, 181.40 feet along the Northerly right-of-way line of Proctor Drive to an iron pipe; thence N 41°05' W, 197.71 to an iron pipe on the Easterly right-of-way line of the proposed railroad siding; thence Northeasterly 432.65 feet along the arc of a curve to the right along said Easterly right-of-way line, having a radius of 543.69 feet and a chord bearing N 71°42'50" E, 421.33 feet to the place of beginning containing 2.00 acres of land more or less.

I HEREBY CERTIFY that this Plat of Survey is a true and accurate representation of the lot lines to the best of my professional knowledge and belief.

WISCONSIN ROBERT A FARRIS S-1293 ELKHORN WIS LAND SURVEYOR

Robert A. Farris

Robert A. Farris, RLS 1293

Dated this 30th day of December, 1985

PROJ. # 2525

Part of 1SE - 17E

4-402

Pd YUSS-17F1