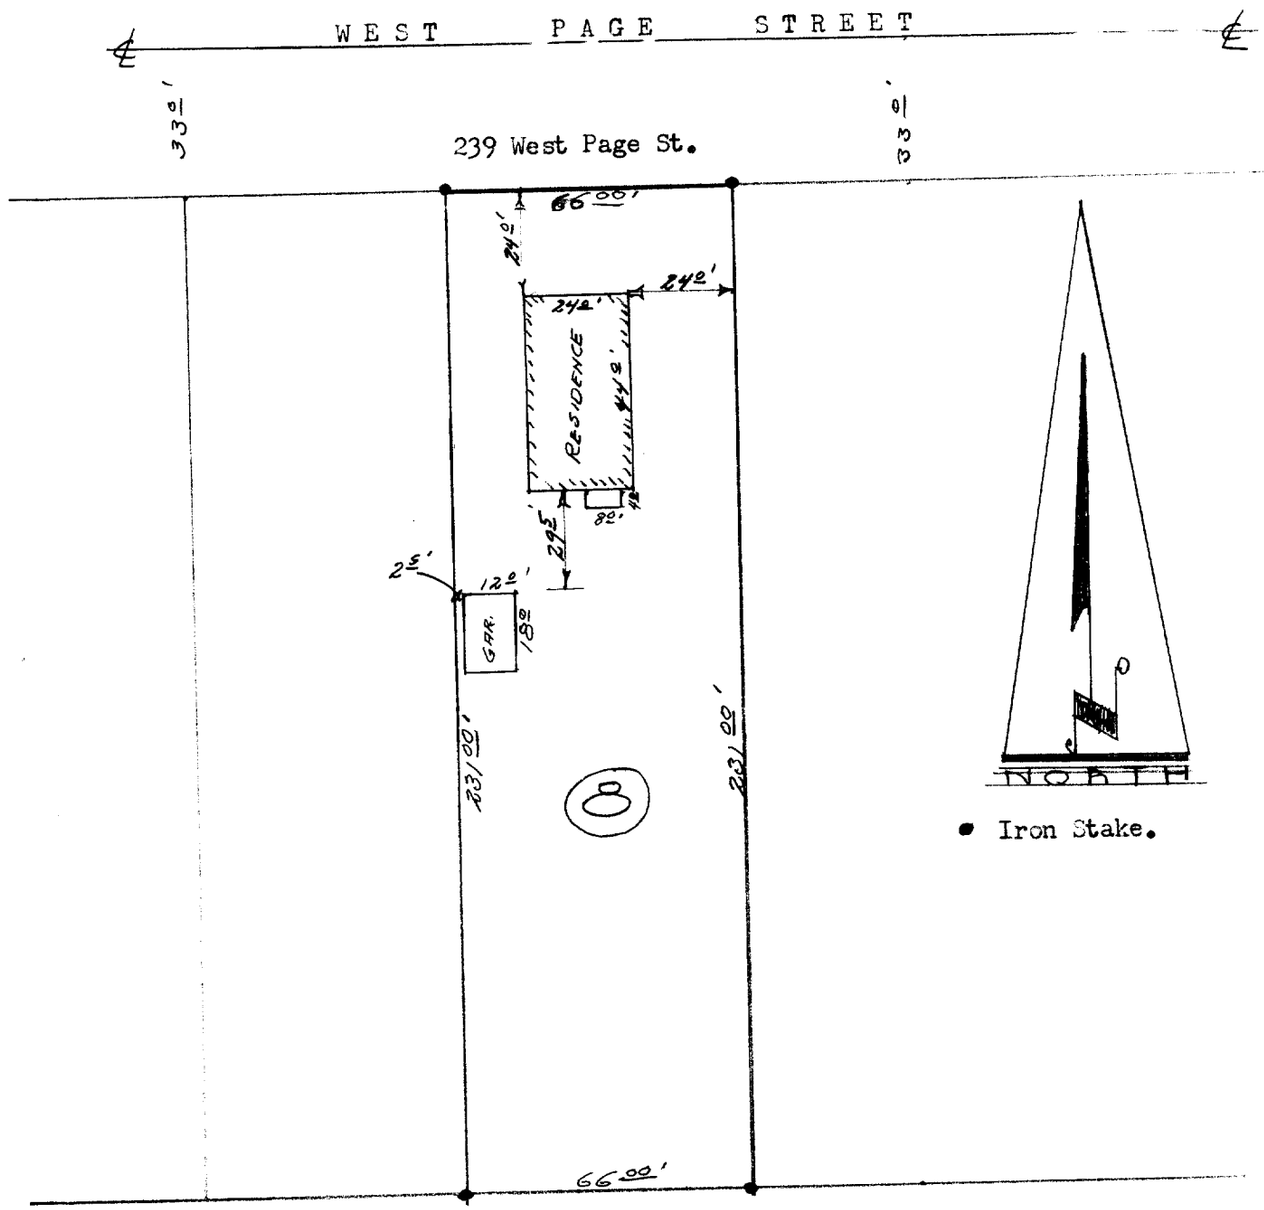


DESCRIPTION:
Lot 8 Fairview Addition , City of Elkhorn, Walworth County, Wisconsin.

CERTIFICATE: I, hereby certify that I have surveyed the above mentioned property and that the above plat is an accurate survey and a true representation thereof and correctly shows the exterior boundary lines and location of buildings and other improvements on said property and the correct measurements thereof.

James F. Biagi

James F. Biagi. RLS 272
Elkhorn, Wisconsin.

Dated: August 26th 1965.

WISCONSIN
JAMES F.
BIAGI
MILWAUKEE,
WIS.
LAND SURVEYOR

XFR-8

4-40B