RECEIVED
OCT 14 1986


PLAT FOR BUILDING PERMIT

~of~

CERTIFIED SURVEY MAP NO. , A REDIVISION OF LOTS 6, 7, AND 10 OF ROCKWELL'S ADDITION TO THE CITY OF ELKHORN, WALWORTH COUNTY, WISCONSIN.

JENSEN SURVEYING & MAPPING S.C.
45 S. WISCONSIN ST. P.O. BOX 322
ELKHORN, WISCONSIN. 53121

SURVEYED FOR: EARL PADDOCK

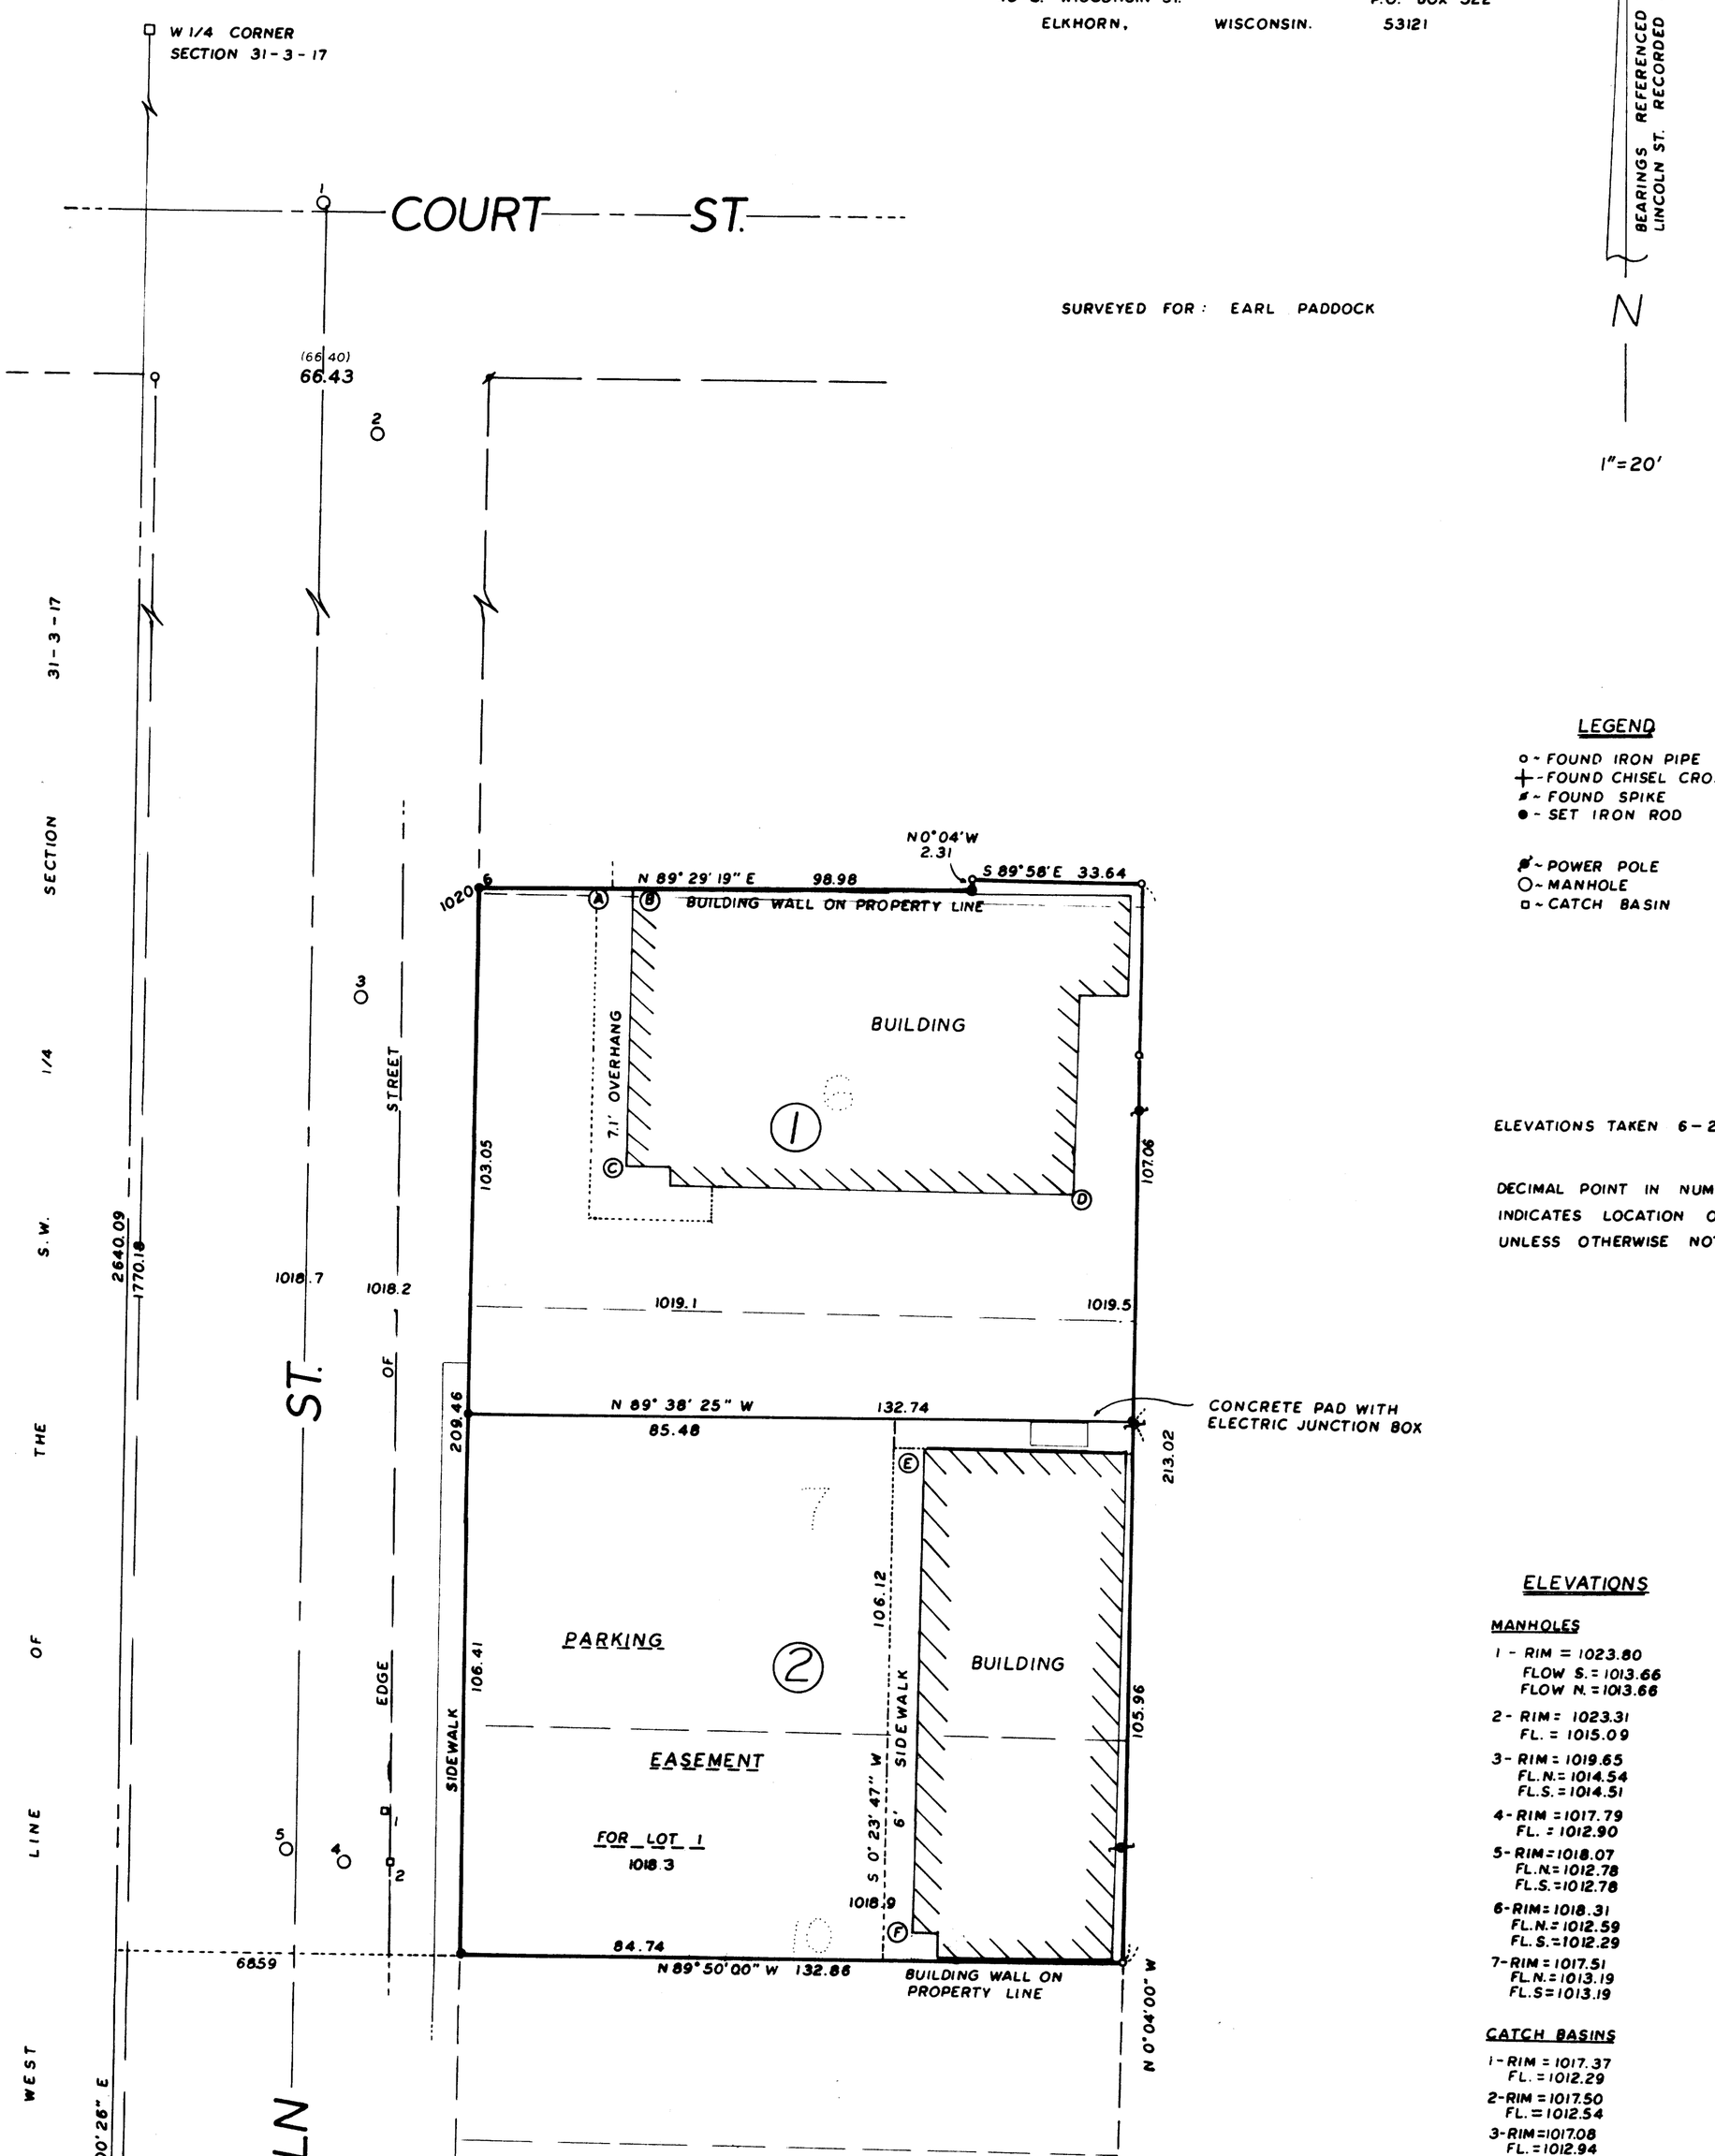

BEARINGS REFERENCED TO THE EAST LINE OF LINCOLN ST. RECORDED AS NORTH

N

1"=20'

LEGEND

- o ~ FOUND IRON PIPE
- + ~ FOUND CHISEL CROSSCUT
- ⸗ ~ FOUND SPIKE
- ● ~ SET IRON ROD
- ~ POWER POLE
- ○ ~ MANHOLE
- □ ~ CATCH BASIN

ELEVATIONS TAKEN 6-26-86

DECIMAL POINT IN NUMERICAL FIGURE INDICATES LOCATION OF ELEVATION UNLESS OTHERWISE NOTED.

ELEVATIONS

MANHOLES

1 - RIM = 1023.80 FLOW S. = 1013.66 FLOW N. = 1013.66	SANITARY
2 - RIM = 1023.31 FL. = 1015.09	STORM
3 - RIM = 1019.65 FL. N. = 1014.54 FL. S. = 1014.51	STORM
4 - RIM = 1017.79 FL. = 1012.90	STORM
5 - RIM = 1018.07 FL. N. = 1012.78 FL. S. = 1012.78	SAN.
6 - RIM = 1018.31 FL. N. = 1012.59 FL. S. = 1012.29	SAN.
7 - RIM = 1017.51 FL. N. = 1013.19 FL. S = 1013.19	STORM

CATCH BASINS

1 - RIM = 1017.37
FL. = 1012.29

2 - RIM = 1017.50
FL. = 1012.54

3 - RIM = 1017.08
FL. = 1012.94

4 - RIM = 1017.06
FL. = 1011.33

GROUND AT BUILDING CORNERS

- (A) 1022.2
- (B) 1020.9
- (C) 1019.6
- (D) 1019.6
- (E) 1019.3
- (F) 1019.3

1986059

4-429