PLAT OF SURVEY & BUILDING LOCATION
-of-

Parcel of land located in the Northeast 1/4 of Section 6, Town 2 North, Range 17 East, City of Elkhorn, Walworth County, described as follows: Commence at the Northeast corner of said Section 6; thence South 1° 37' 57" East along the said Section line, 180.53 feet to the point of beginning; thence continue South 1° 37' 57" East 30.15 feet; thence North 78° 42' 09" West 33.86 feet; thence South 81° 33' 38" West 178.95 feet; thence South 1° 37' 57" East 153.56 feet; thence North 32° 59' 30" West 117.32 feet; thence North 11° 42' 08" West 137.01 feet; thence North 1° 22' East 8.00 feet; thence South 82° 49' 51" East 298.79 feet to the point of beginning.

(Tax Key No. YV SE 00001)

Jensen Surveying & Mapping S.C.
45 S. Wisconsin St. P.O. Box 322
Elkhorn, Wisconsin. 53121
(414) 723-3434

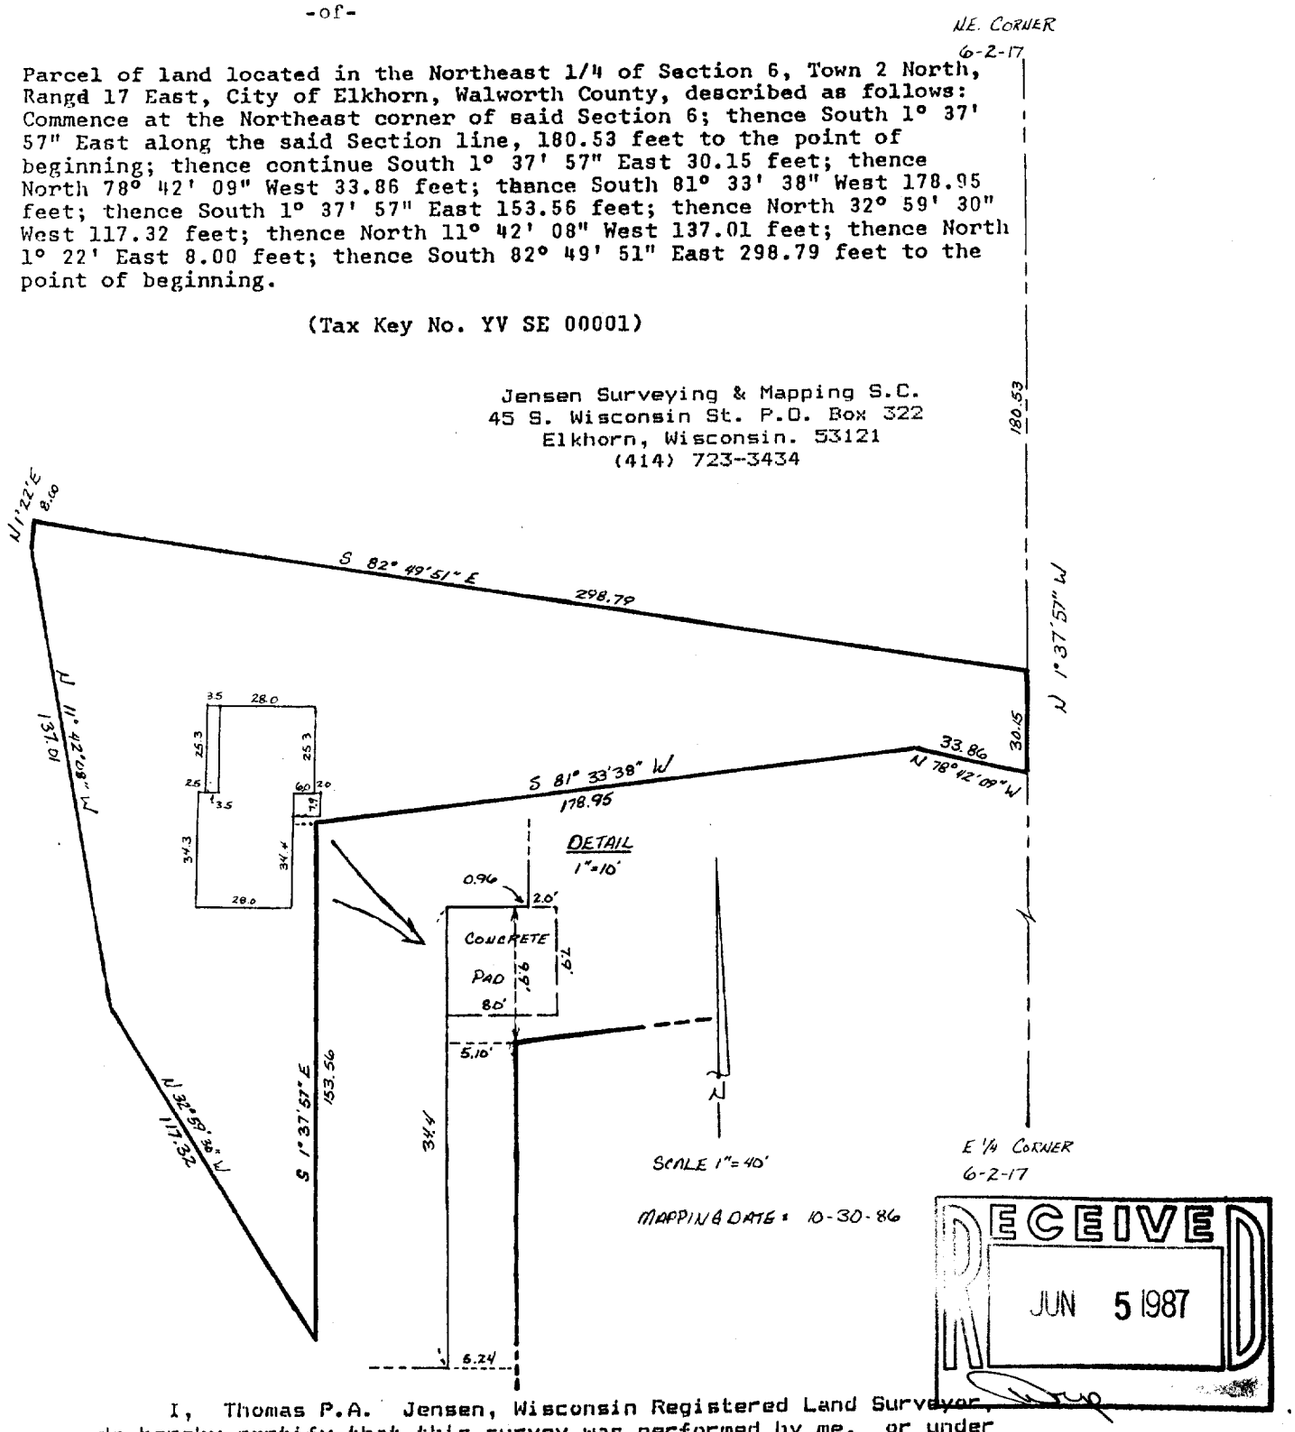

RECEIVED
JUN 5 1987

I, Thomas P.A. Jensen, Wisconsin Registered Land Surveyor, do hereby certify that this survey was performed by me, or under my direction, in full compliance with the owner's/agent's instructions and chapter A-E 5 of the Wisconsin Administrative Code "Minimum Standards For Property Surveys"; and that this map is an accurate representation thereof to the best of my knowledge and belief.

THOMAS P. A. JENSEN S-1084 ELKHORN, WIS. LAND SURVEYOR

Thomas P.A. Jensen S-1084
Jensen Surveying & Mapping S.C.

1986.131

4-455