
ABELL
SURVEYING & MAPPING
DELAVAN, WISCONSIN 53115
414-728-6737

RECEIVED
NOV 25

ORDERED BY:
CENTURY 21-WALTON
REALTY
704 N. LINCOLN
ELKHORN, WI. 53121

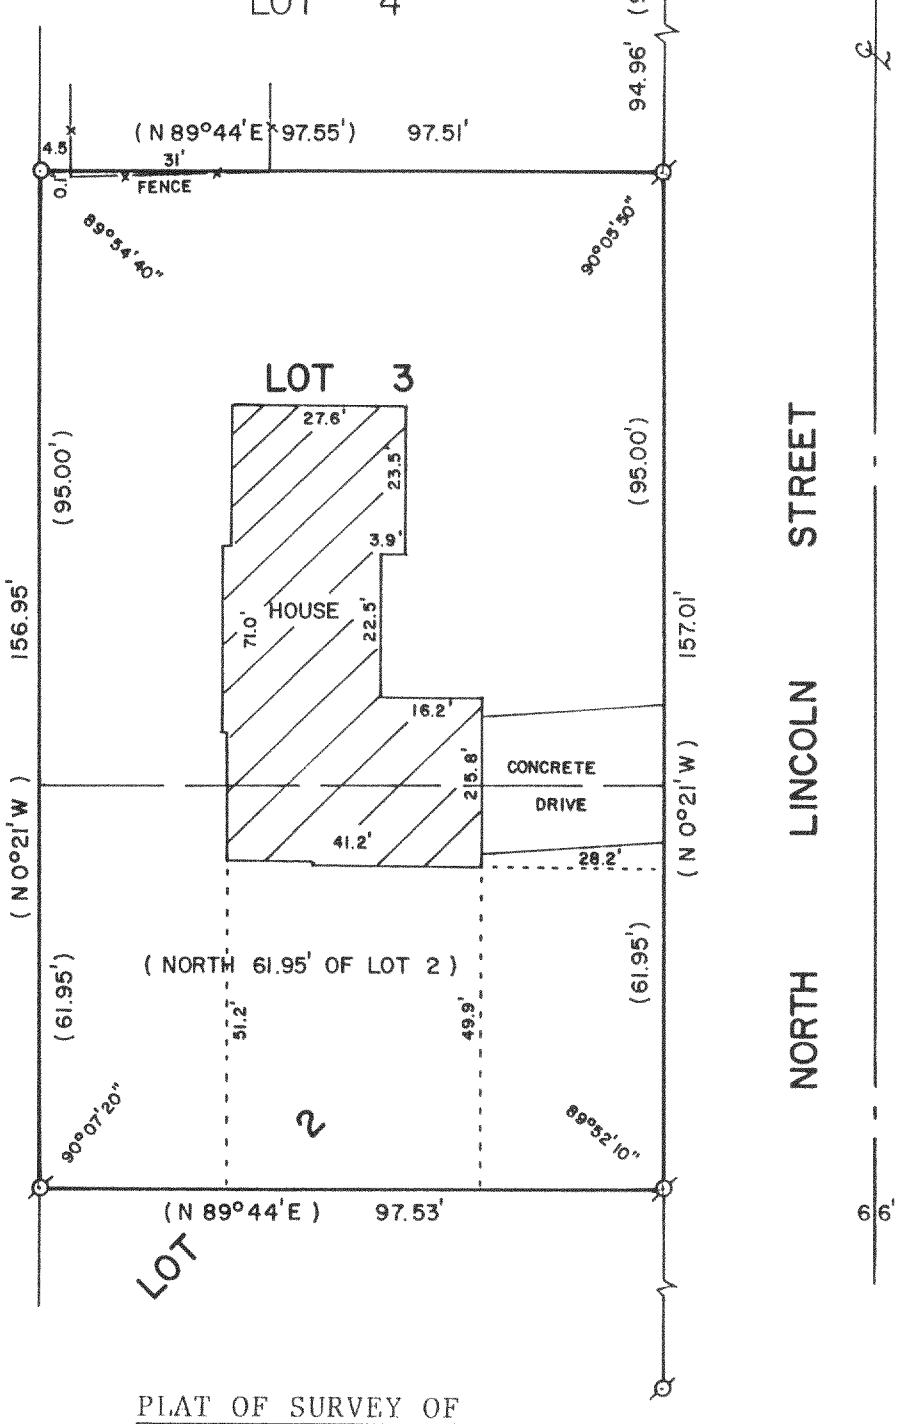

PLAT OF SURVEY OF

LOT 3 AND THE NORTH 61.95 FEET OF LOT 2, MANN BROTHERS ADDITION, CITY OF ELKHORN, WALWORTH COUNTY, WISCONSIN.

SCALE - 1"=30'

LEGEND

- ⊗ - IRON PIPE FOUND
- ○ - IRON ROD SET
- ( ) - RECORDED AS

I, DAVID F. ABELL, DO HEREBY CERTIFY THAT I HAVE SURVEYED THE PROPERTY HEREON DESCRIBED ACCORDING TO THE OFFICIAL RECORDS AND THAT THE PLAT HEREON IS A CORRECT REPRESENTATION OF THE PROPERTY LINES TO THE BEST OF MY KNOWLEDGE AND BELIEF.

David F. Abell
DAVID F. ABELL
WISCONSIN REGISTERED LAND SURVEYOR, S-1596

November 2, 1987
DATE JOB NUMBER - 87172

NOTE: THIS IS NOT A CERTIFIED COPY UNLESS SEALED.

4-485