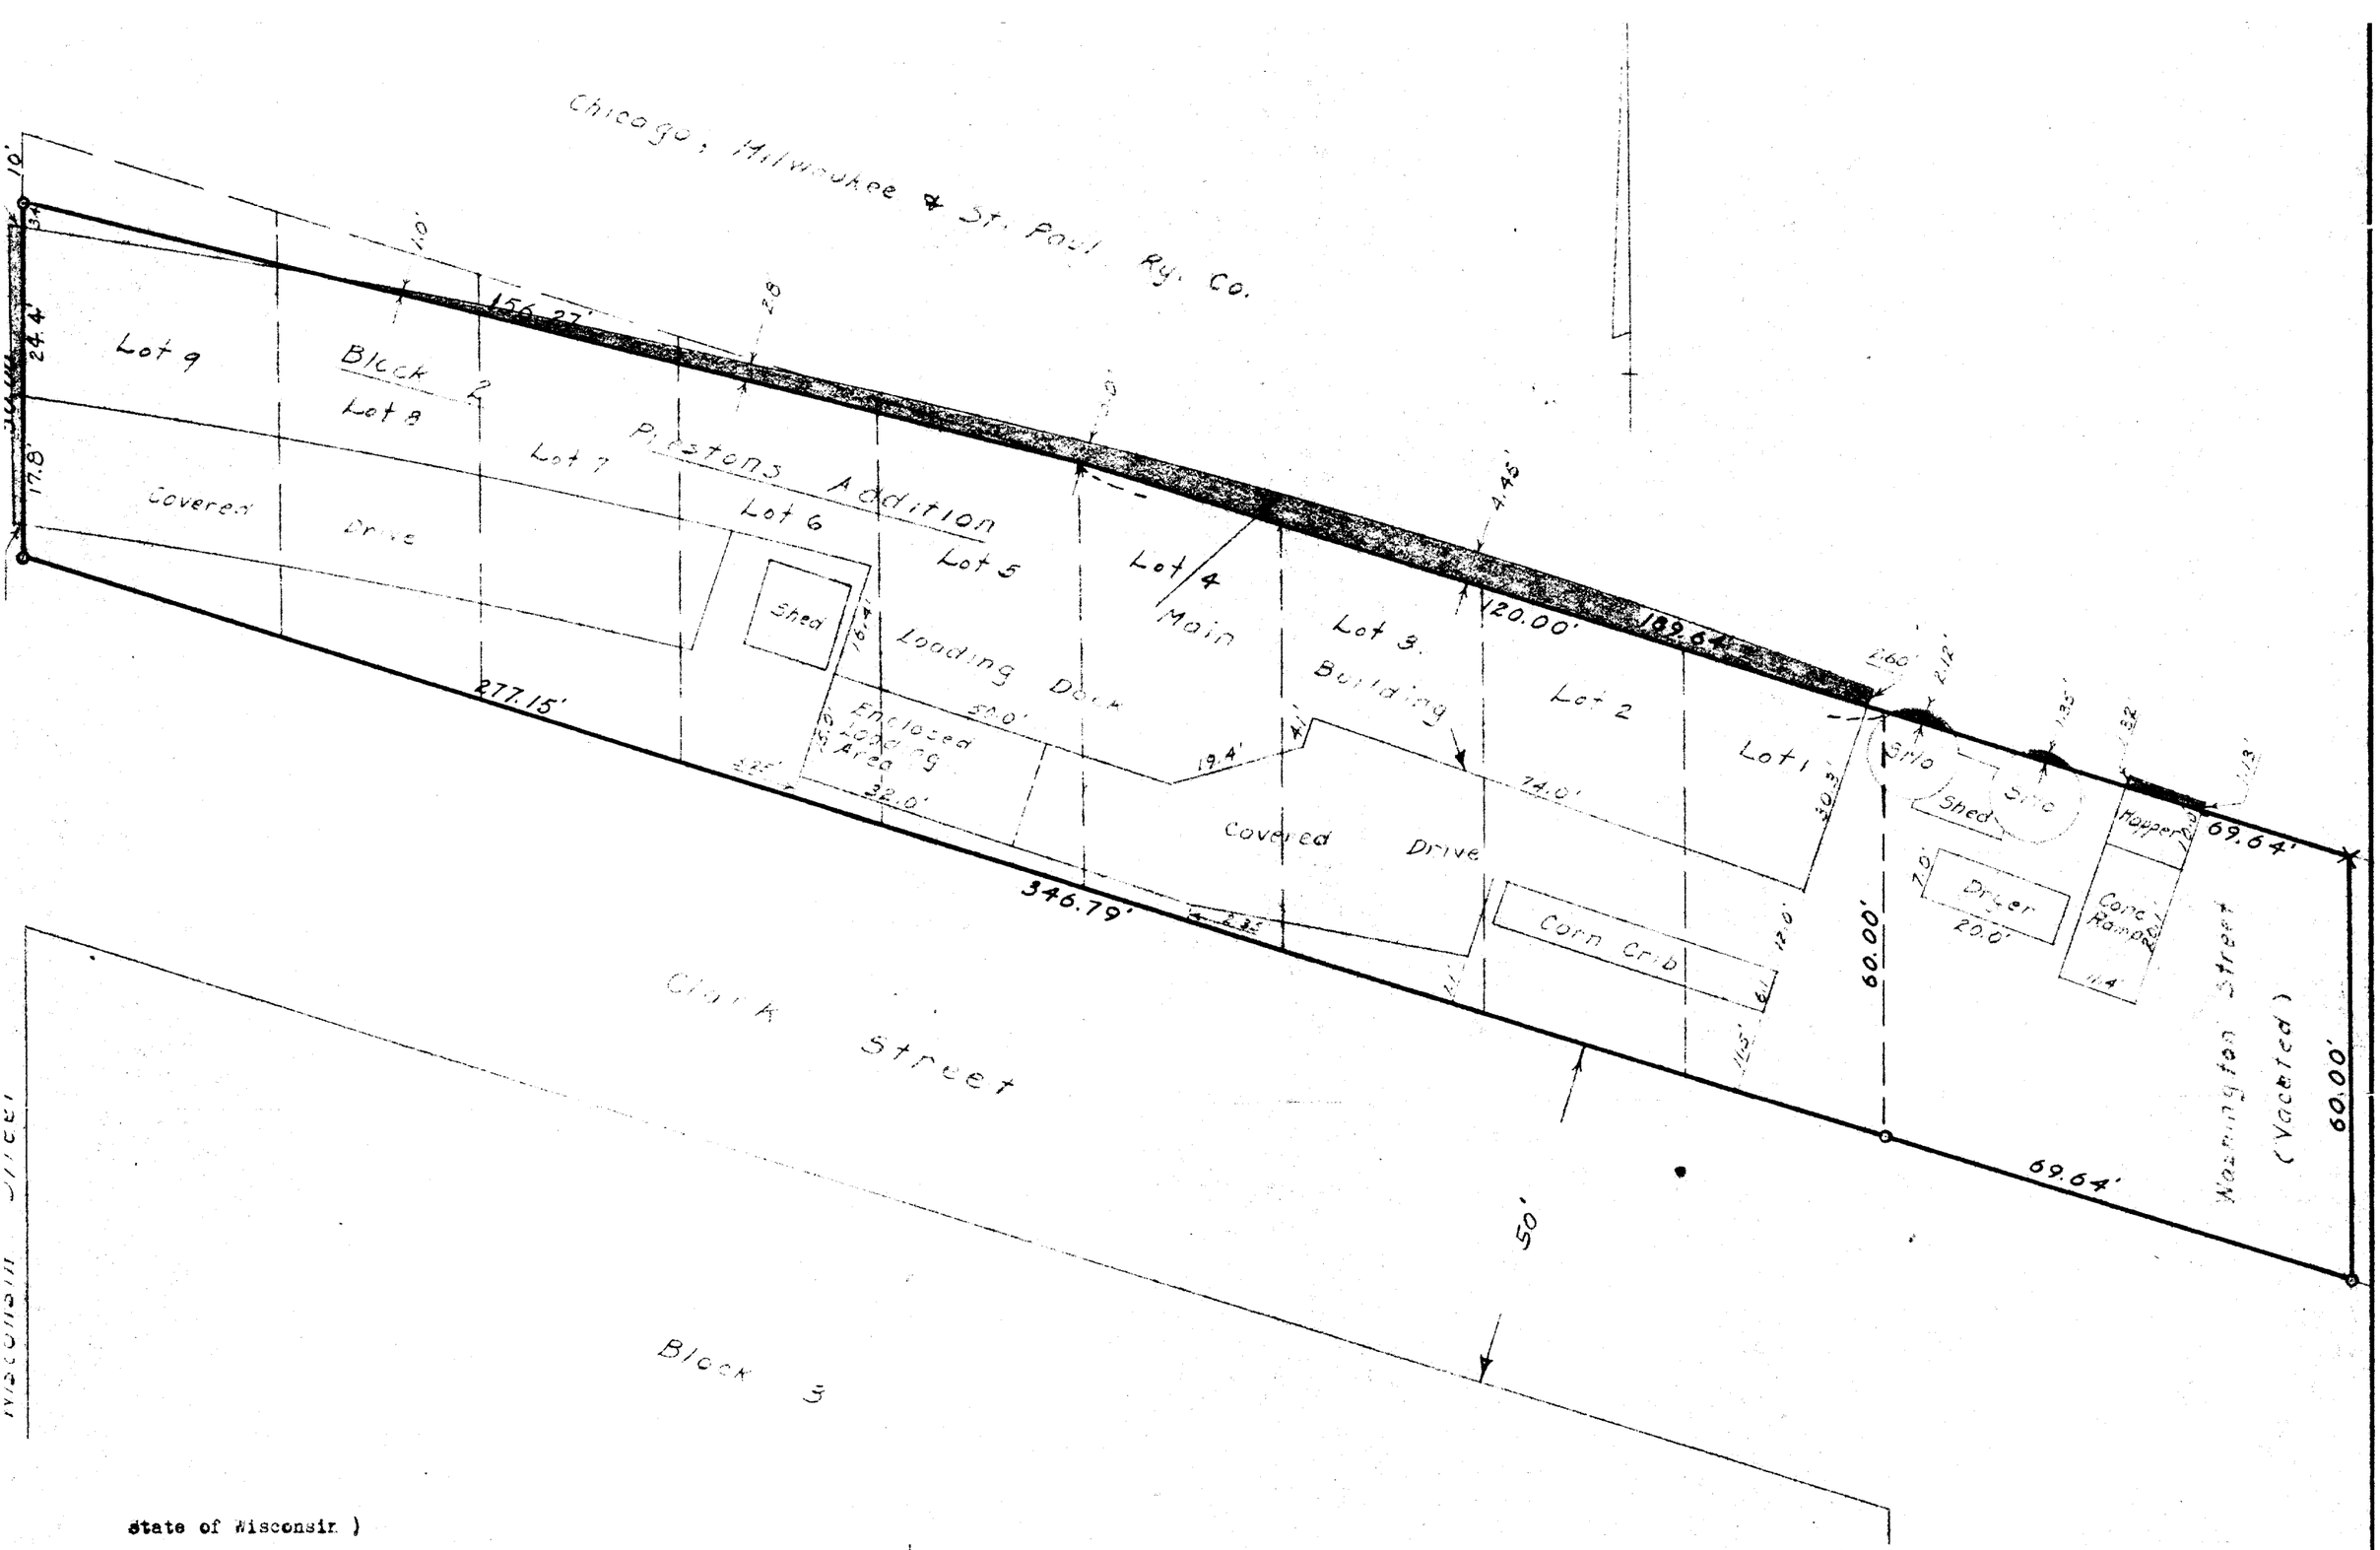

State of Wisconsin)

County of Walworth)

I, Lloyd L. Jensen, do hereby certify that I have surveyed the property hereon described according to the official records, and that the plat hereon is a correct representation of the lot lines and the principal lines of the buildings thereon.

Date March 14, 1961 Lloyd L. Jensen
(Lloyd L. Jensen) Wisconsin Registered Surveyor S-211

Legend
o - Iron Pipe
x - Cross cut in concrete
— - Property Lines
— - Building Lines
▬ - Encroachment

PLAT OF SURVEY
OF

Block 2, Prestons Addition and part of Washington Street (Vacated), City of Elkhorn, Walworth County, Wisconsin.

Lloyd L. Jensen
SURVEYOR

SCALE 1" = 20' DATE March, 1961

4P-2

4-49J