
61-61

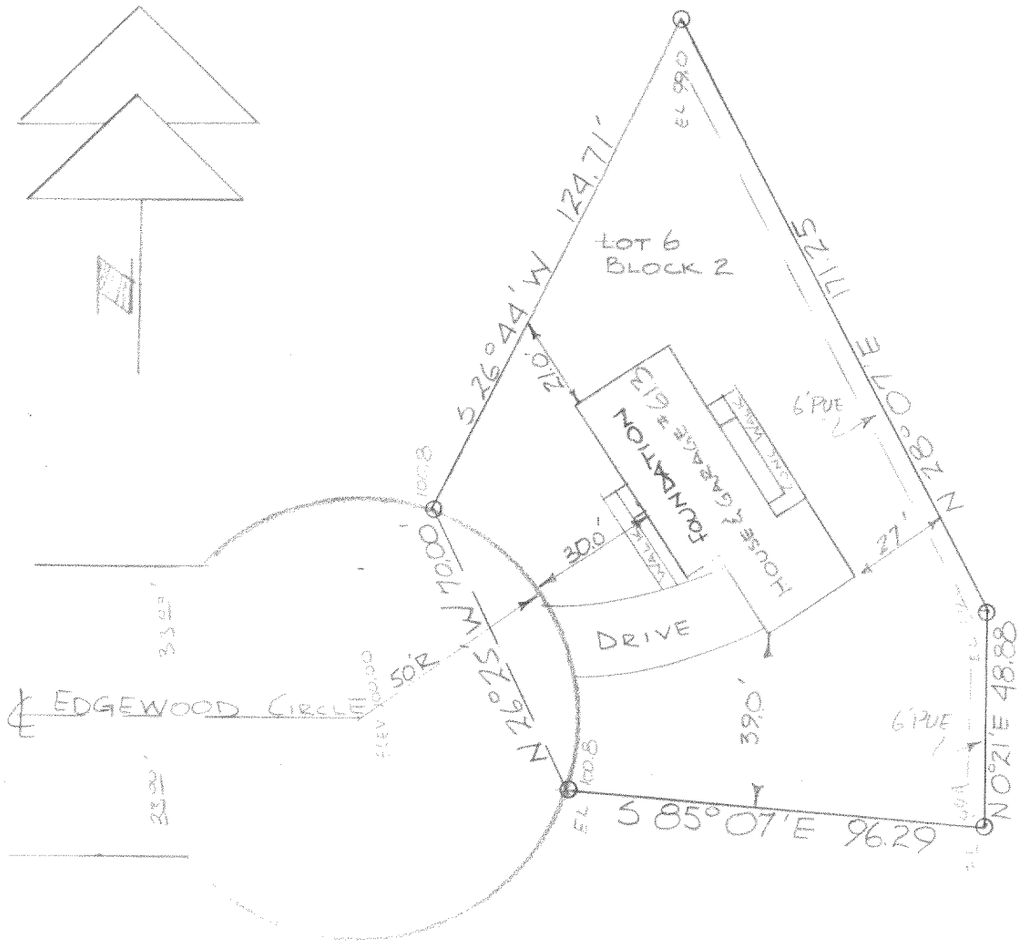

DESCRIPTION: Lot 6 of Block 2 of Edgewood first addition in the City of Elkhorn, Walworth County, Wisconsin.

CERTIFICATE: I, James F. Biagi, surveyor, do hereby certify that I have surveyed the property hereon described, and that the location of all the improvements are as shown on the drawing above.

October 11, 1961

James F. Biagi RLS 272

Recertified April 21st 1964.

James F. Biagi. RLS 272

WISCONSIN
JAMES F.
BIAGI
MILWAUKEE,
WIS.
LAND SURVEYOR

YEA1-16

4-50B