
58-10

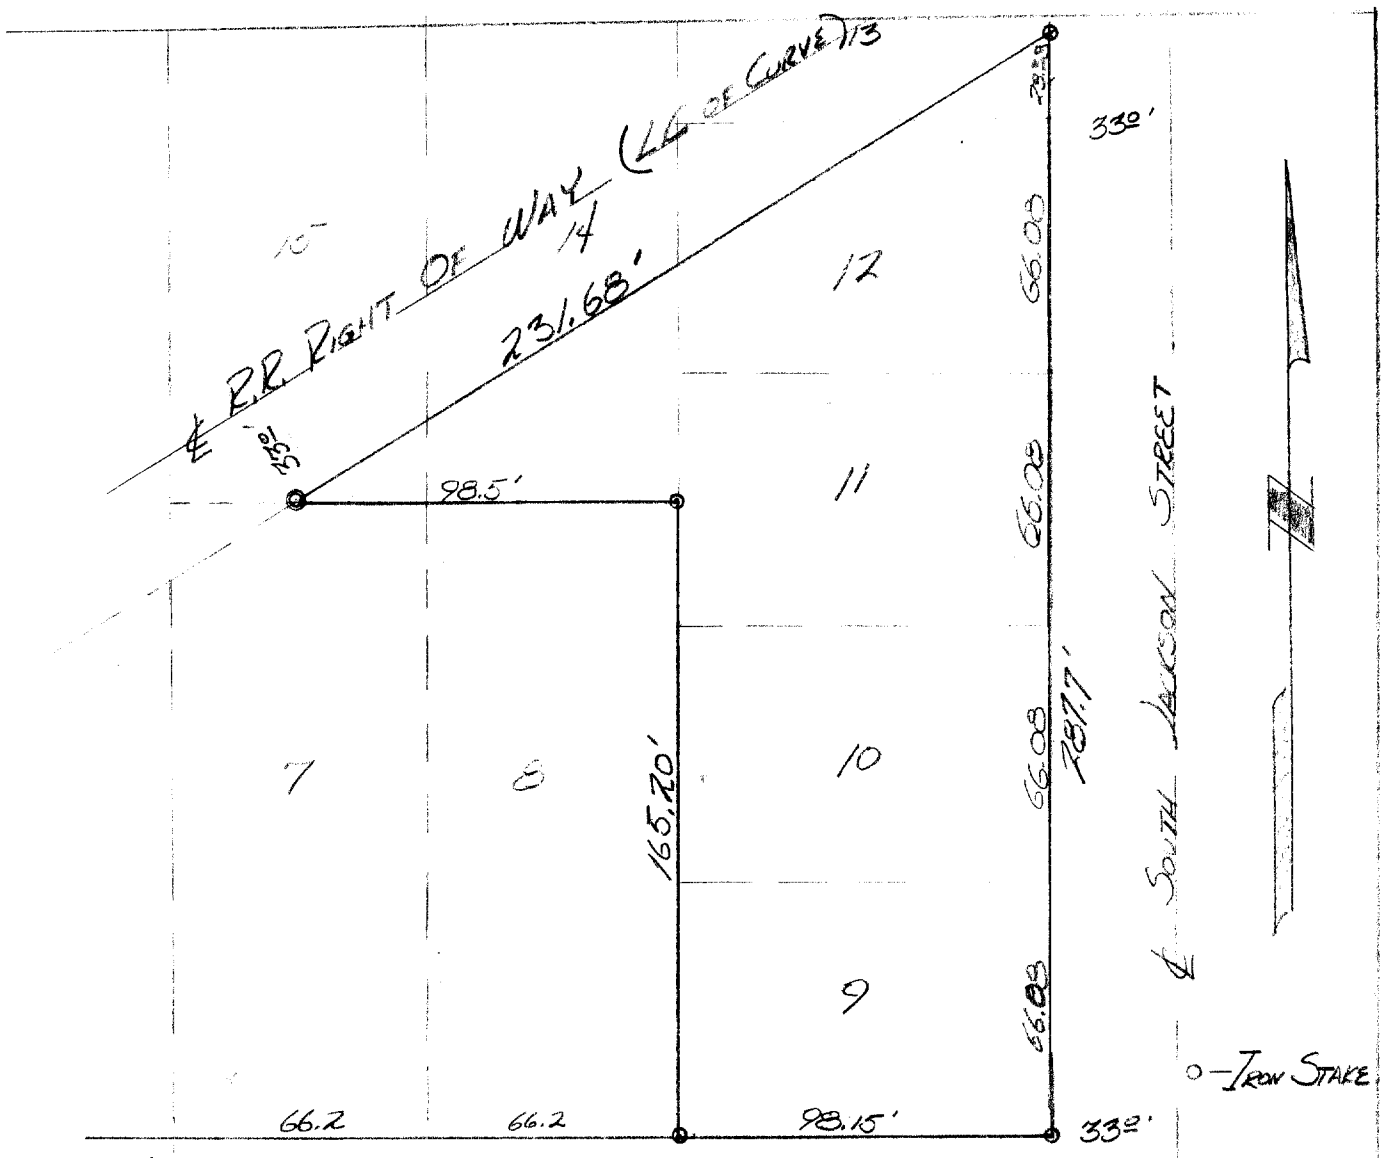


DESCRIPTION: All of Lots 9, 10, and 11 and the portions of Lots 12, 13, 14, and 15 that lie South of the Rail Road right of way, in Block 3, of Elderkins Addition to the City of Elkhorn, Walworth County, Wisconsin.

CERTIFICATE: I, hereby certify, that I have on this the 9th day of September, 1958, surveyed the above described property, and the measurements shown hereon substantially agree with those in the field, and that said survey is in accordance with the official files in the Register of Deeds office, Walworth County.

SIGNED AND SEALED THIS 9TH DAY OF SEPTEMBER 1958

WISCONSIN
JAMES F.
BIAGI
MILWAUKEE,
WIS.
LAND SURVEYOR

James F. Biagi
Land Surveyor (272)

Apr-7

EK-29B + EK-30

4-59B