
114 A-69

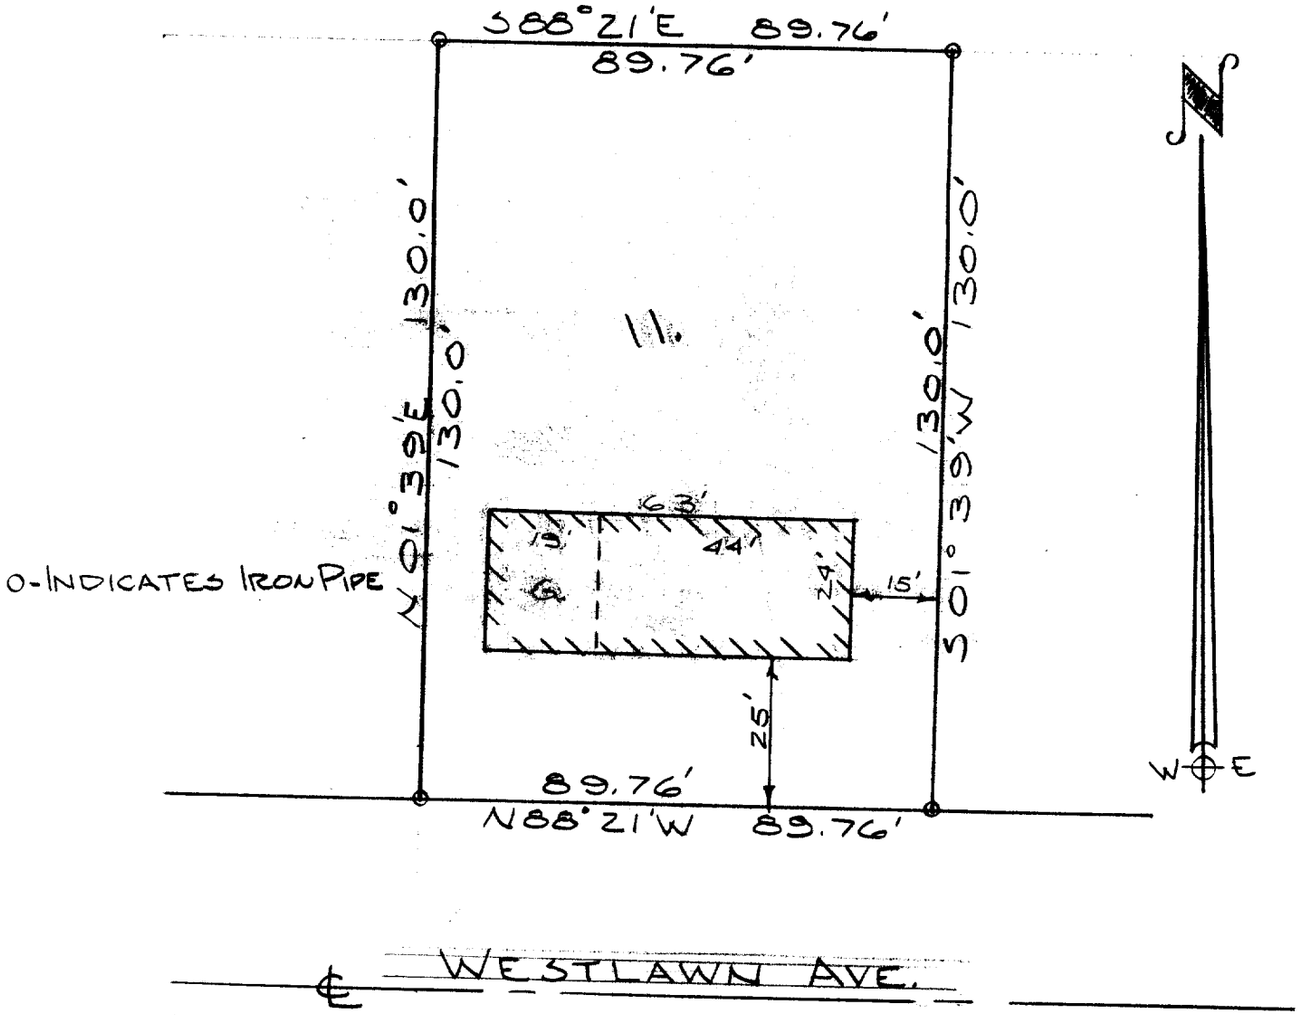

DESCRIPTION:
Lot 11 Block 3 Edgewood Second Addition in the City of Elkhorn, Walworth County, Wisconsin.

CERTIFICATE: I, James F. Biagi, surveyor do hereby certify that I have surveyed the property hereon described.

August 15th 1969.

James F. Biagi RLS 272
Elkhorn, Wisconsin.

WISCONSIN
JAMES F.
BIAGI
MILWAUKEE, WIS.
LAND SURVEYOR

YEA2-3

4-5B