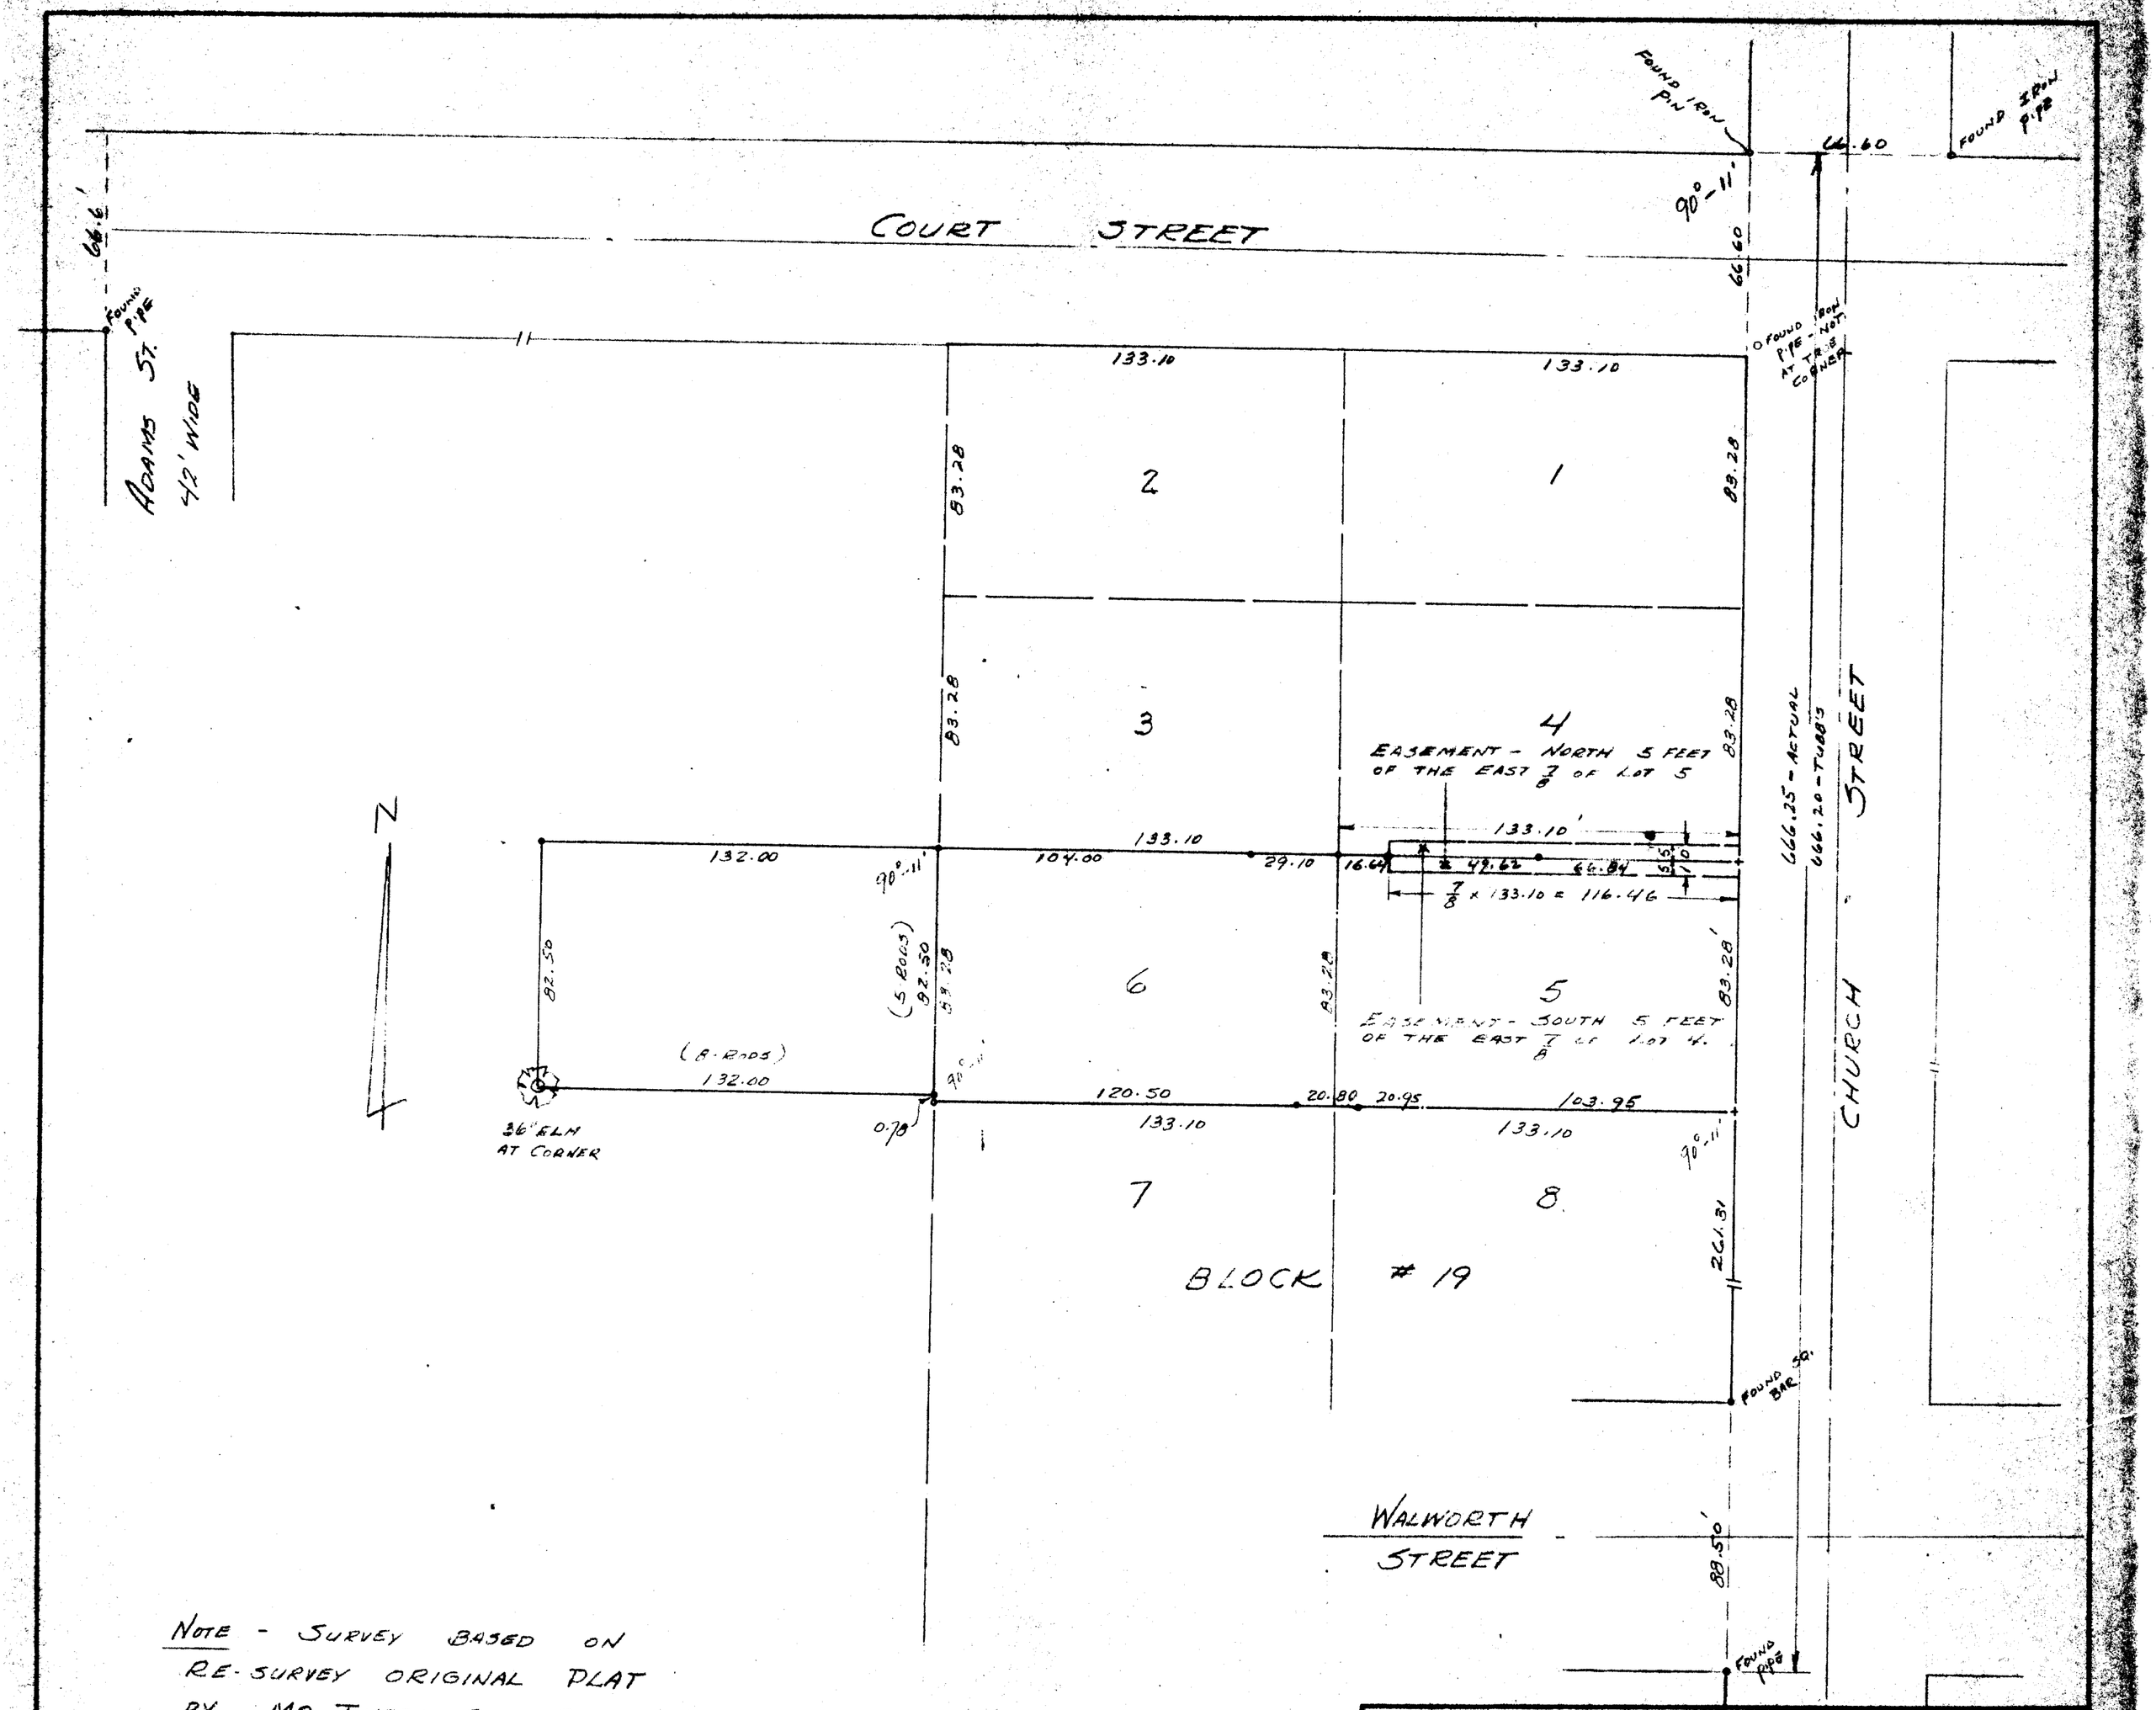

NOTE - SURVEY BASED ON RE-SURVEY ORIGINAL PLAT BY MR. TUBBS - CITY ENGR.

o IRON STAKE SET

\+ CHISLE CUT IN CONCRETE

WISCONSIN LLOYD L. JENSEN 5121 ELKHORN, WIS. LAND SURVEYOR

PLAT OF SURVEY
OF

LOTS 5 AND 6 BLOCK 19 ORIGINAL PLAT - AND PARCEL 8 RODS x 5 RODS WEST OF SAID LOT 6 CITY OF ELKHORN WALWORTH COUNTY, WISCONSIN.

Lloyd L. Jensen
SURVEYOR

SCALE 1" = 40'

DATE MAY 1967

NO. 1384—400—1-30-68

OP-137 + U-NW 187

4r62