


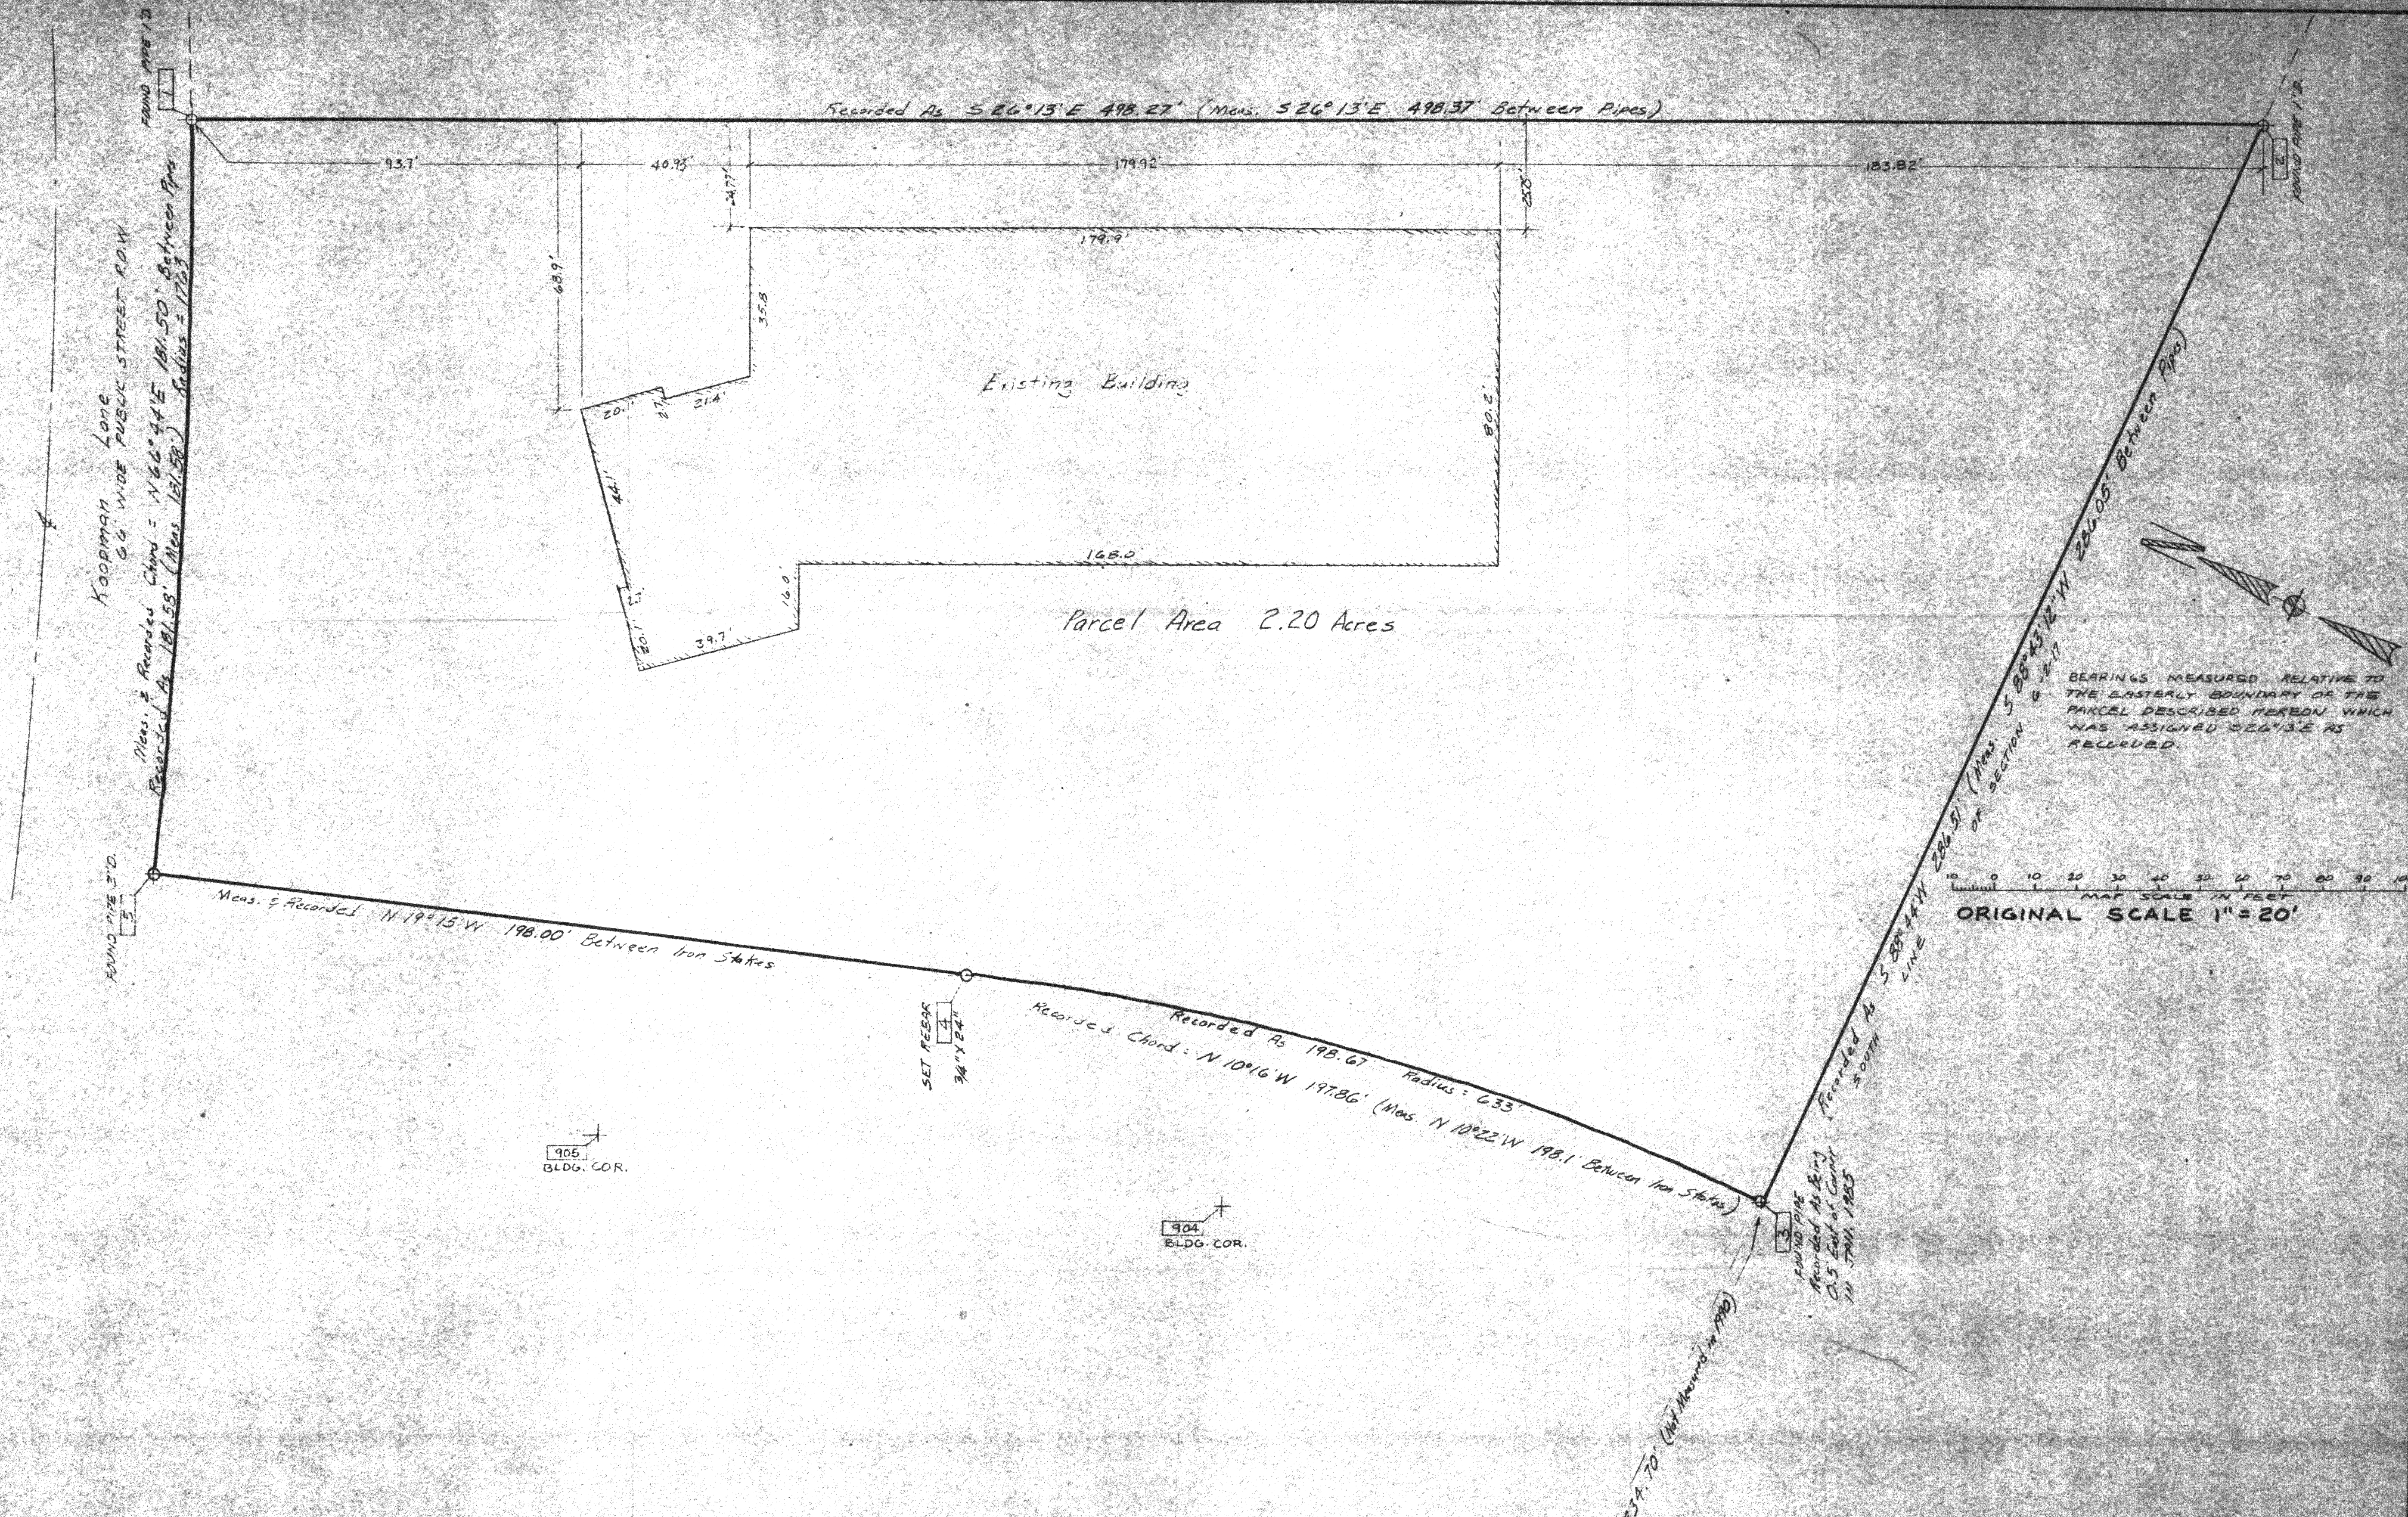

PLAT OF SURVEY OF



Part of the Southeast 1/4 of Section 6, Town 2 North, Range 17 East, City of Elkhorn, Walworth County, Wisconsin, described as follows:

Beginning at a point in the south line of said Section 6 located N 88° 44' E 1234.70 feet from the South 1/4 corner of said Section 6; thence Northwesterly 198.67 feet along the arc of a curve to the left having a radius of 633.00 feet and chord N 10° 16' W 197.86 feet to an iron pipe; thence N 19° 15' W 198.00 feet to an iron pipe; thence Northeasterly 181.58 feet along the southerly right of way of Koopman Lane being the arc of a curve to the left having a radius of 1763 feet and chord N 66° 44' E 181.50 feet; thence S 26° 13' E 498.27 feet to the south line of said Section; thence S 88° 44' W 286.51 feet to the point of beginning, containing 2.20 acres more or less.

NOTE: COPIES OF THIS MAP TO WHICH THE FOLLOWING CERTIFICATE SHALL APPLY ARE BLUE LINE PRINTS WITH THE SURVEYOR'S ORIGINAL SEAL AND SIGNATURE IN BLACK INK. COPIES BY ANY OTHER MEANS MAY CONTAIN ALTERATIONS WHICH DO NOT REPRESENT THE SURVEYOR'S WORK PRODUCT.

I HEREBY CERTIFY THAT THE PARCEL DESCRIBED HEREON HAS BEEN SURVEYED UNDER MY DIRECTION AND THAT THIS PLAT OF SURVEY IS A TRUE AND ACCURATE REPRESENTATION OF THE EXTERIOR BOUNDARIES OF SAID PARCEL AND OF THE LOCATION AND DIMENSIONS OF THE PRINCIPAL BUILDING EXISTING THEREON TO THE BEST OF MY PROFESSIONAL KNOWLEDGE AND BELIEF.

DATED THIS 17TH DAY JULY, 1990

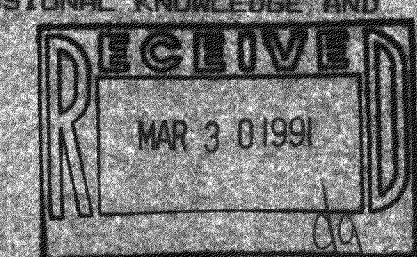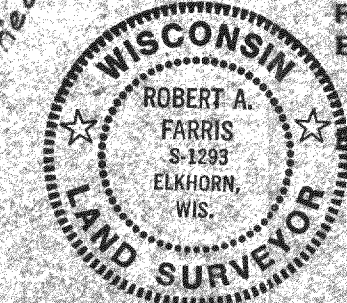

WORK ORDERED BY: BRIDGN BUILDING CORP. BROOKFIELD, WISCONSIN

PLAT OF SURVEY
SAN JAMAR, INC. PARCEL
IN SE 1/4 SEC. 6-2-17
WALWORTH CO., WI.

FARRIS, HANSEN & ASSOCIATES, INC.
Engineering, Architecture, Surveying
7 Ridgway Court P.O. Box 437
ELKHORN, WISCONSIN 53121
Office: (414) 723-2098
Fax: (414) 723-5886

REVISIONS

PROJECT NO.
2299
DATE
7/17/90
SHEET NO.
1 of 1

004-656

USE 000-112