
61-54

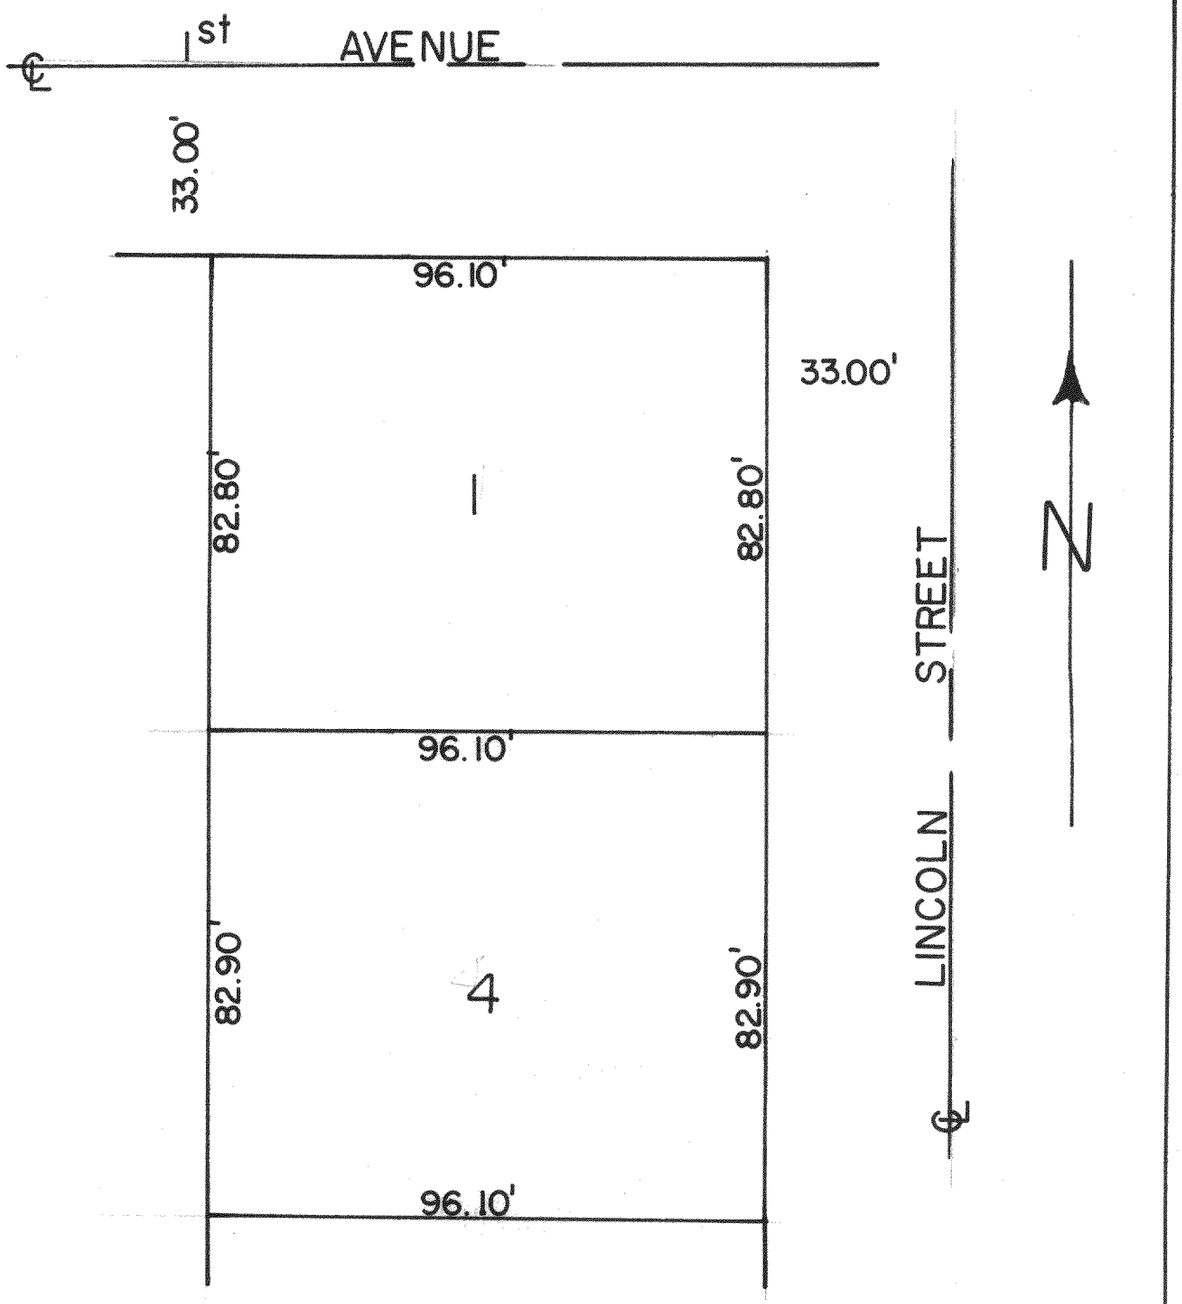

DESCRIPTION: Lots 1 & 4 , of Block 35 of Davis Addition to the City of Elkhorn, Walworth County, Wisconsin.

CERTIFICATE: I, James F. Biagi, surveyor, do hereby certify that I have surveyed the property hereon described on this 2nd day of May, 1961.

WISCONSIN JAMES F. BIAGI MILWAUKEE, WIS. SURVEYOR

James F. Biagi, U.S.

YO-1,181

4-66 B