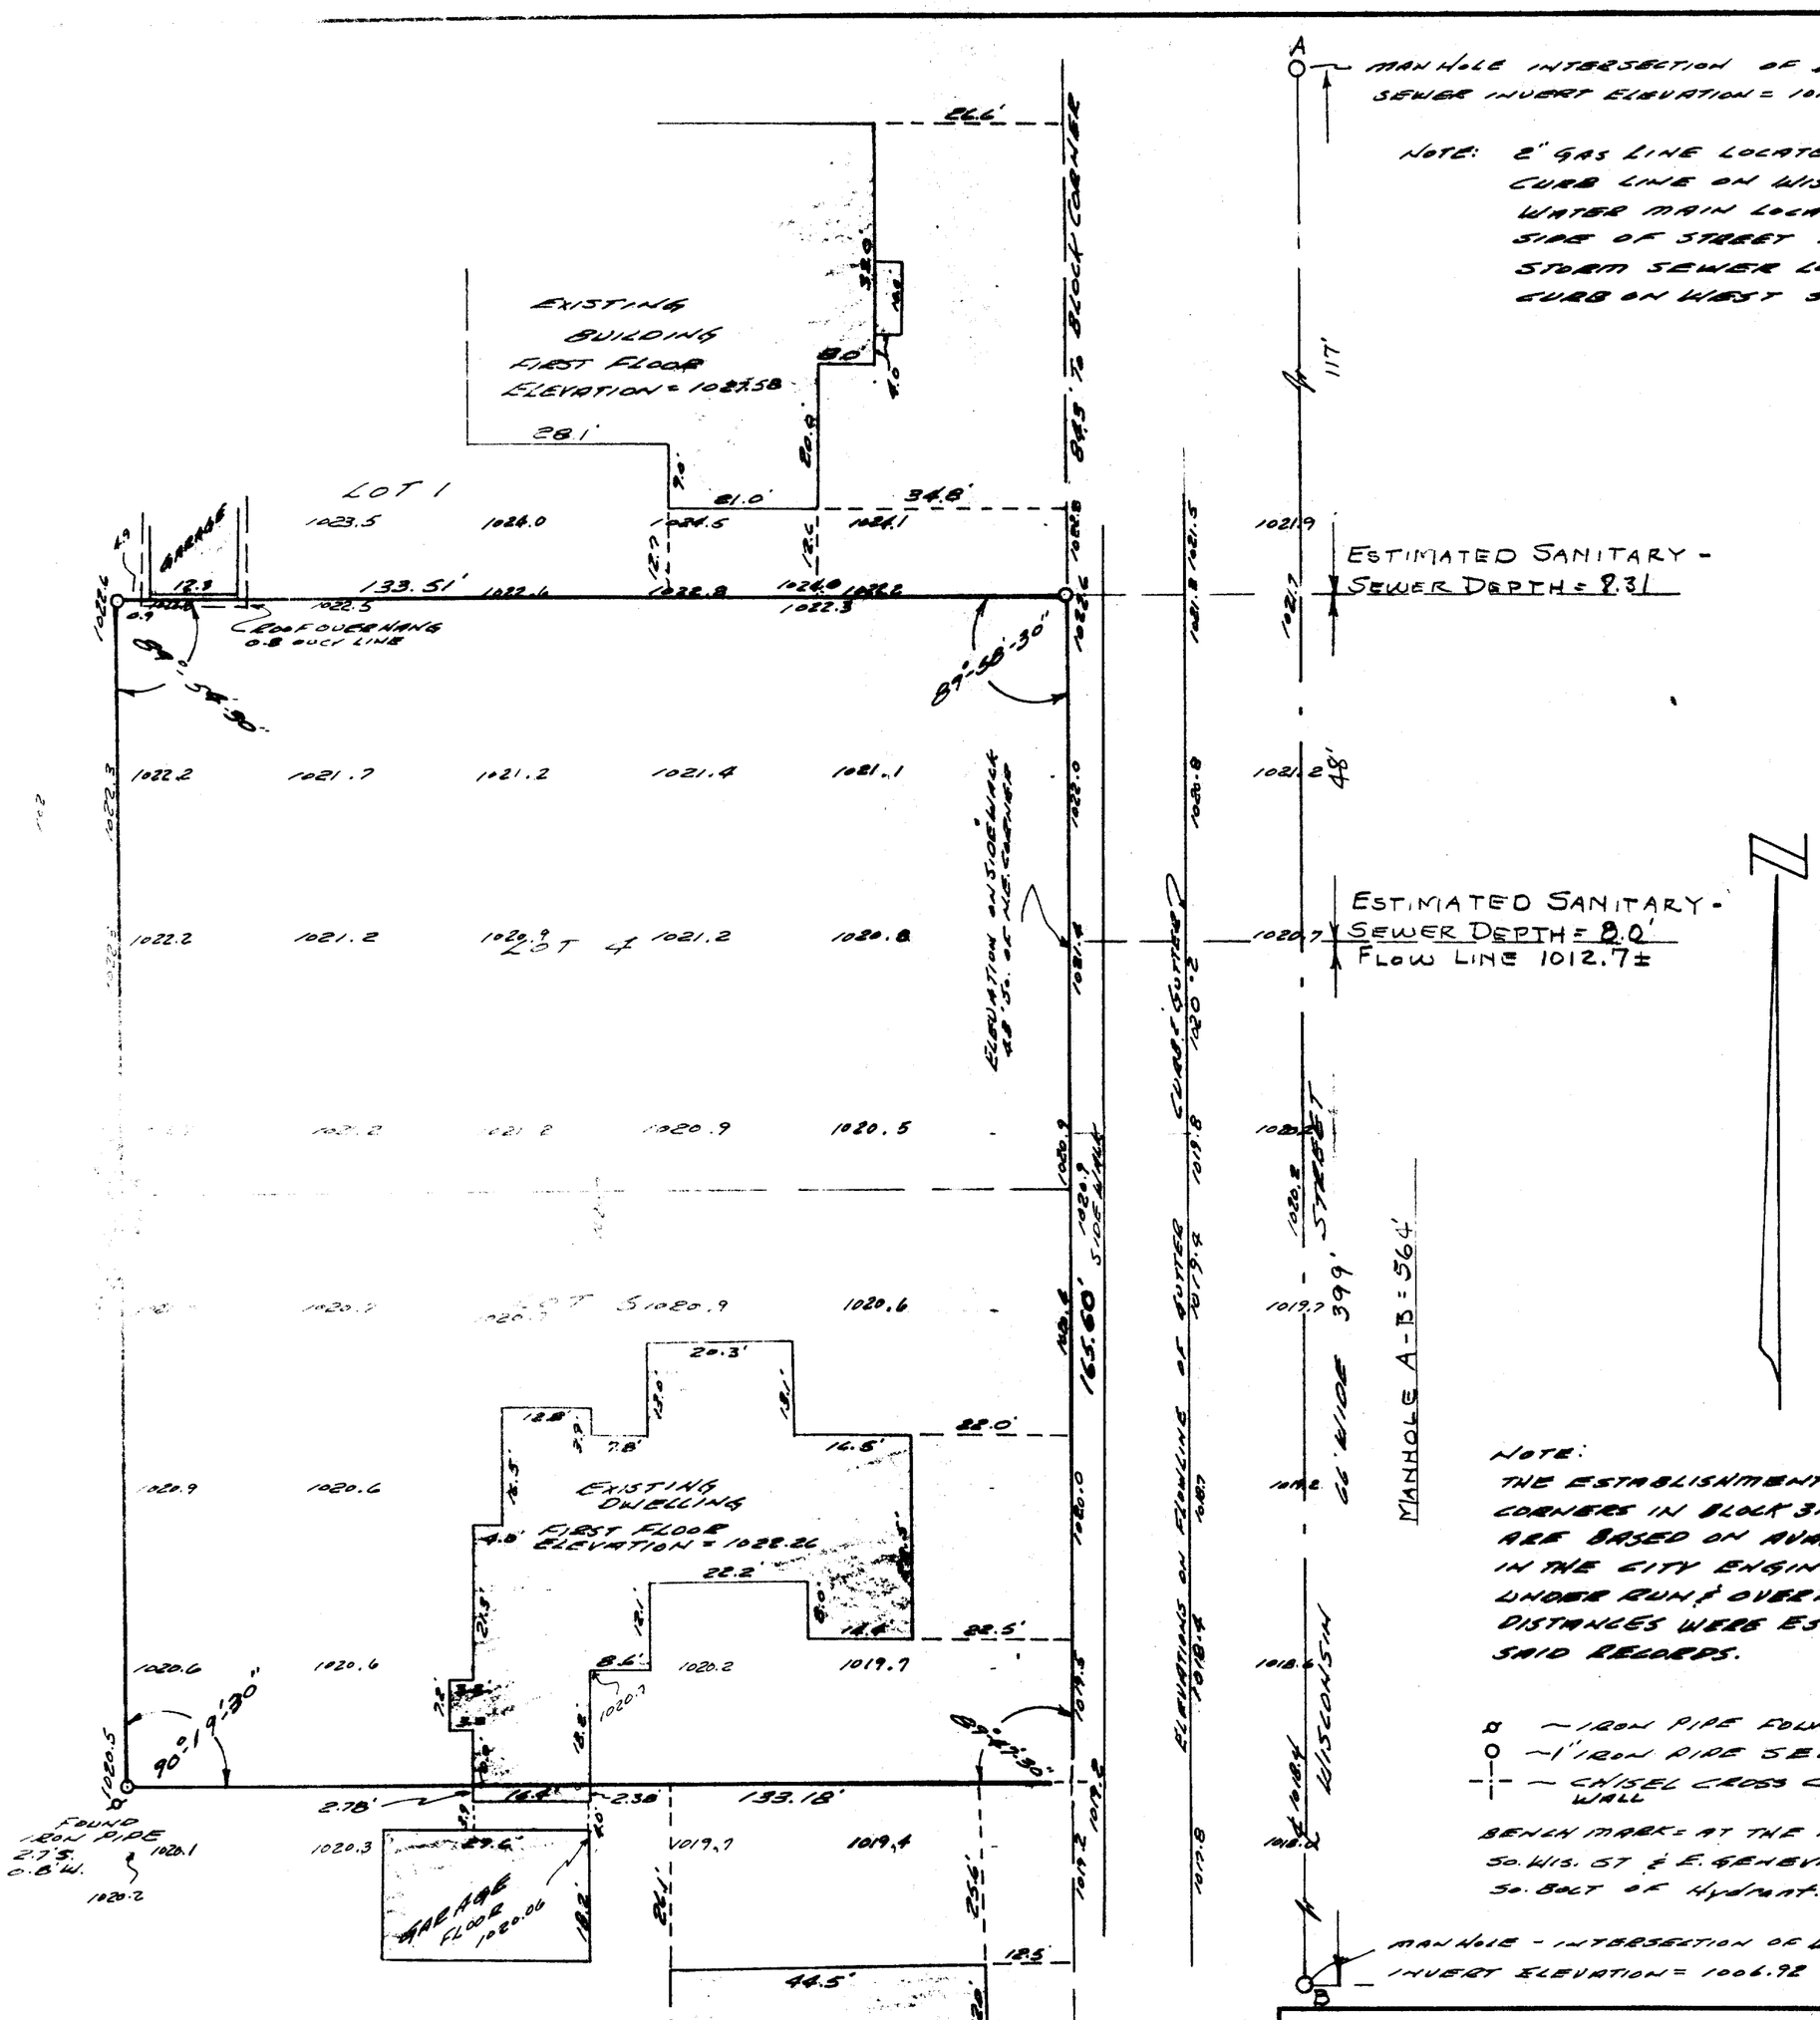

PLAT OF SURVEY
OF

LOTS 4 AND 5 OF BLOCK 31, ROCKWELL'S ADDITION, CITY OF ELKHORN, WALWORTH COUNTY, WISCONSIN.

Floyd S. Jensen
SURVEYOR

SCALE 1" = 20'
REVISED FEB. 1972

DATE JAN. 1972

4-66