
53-9

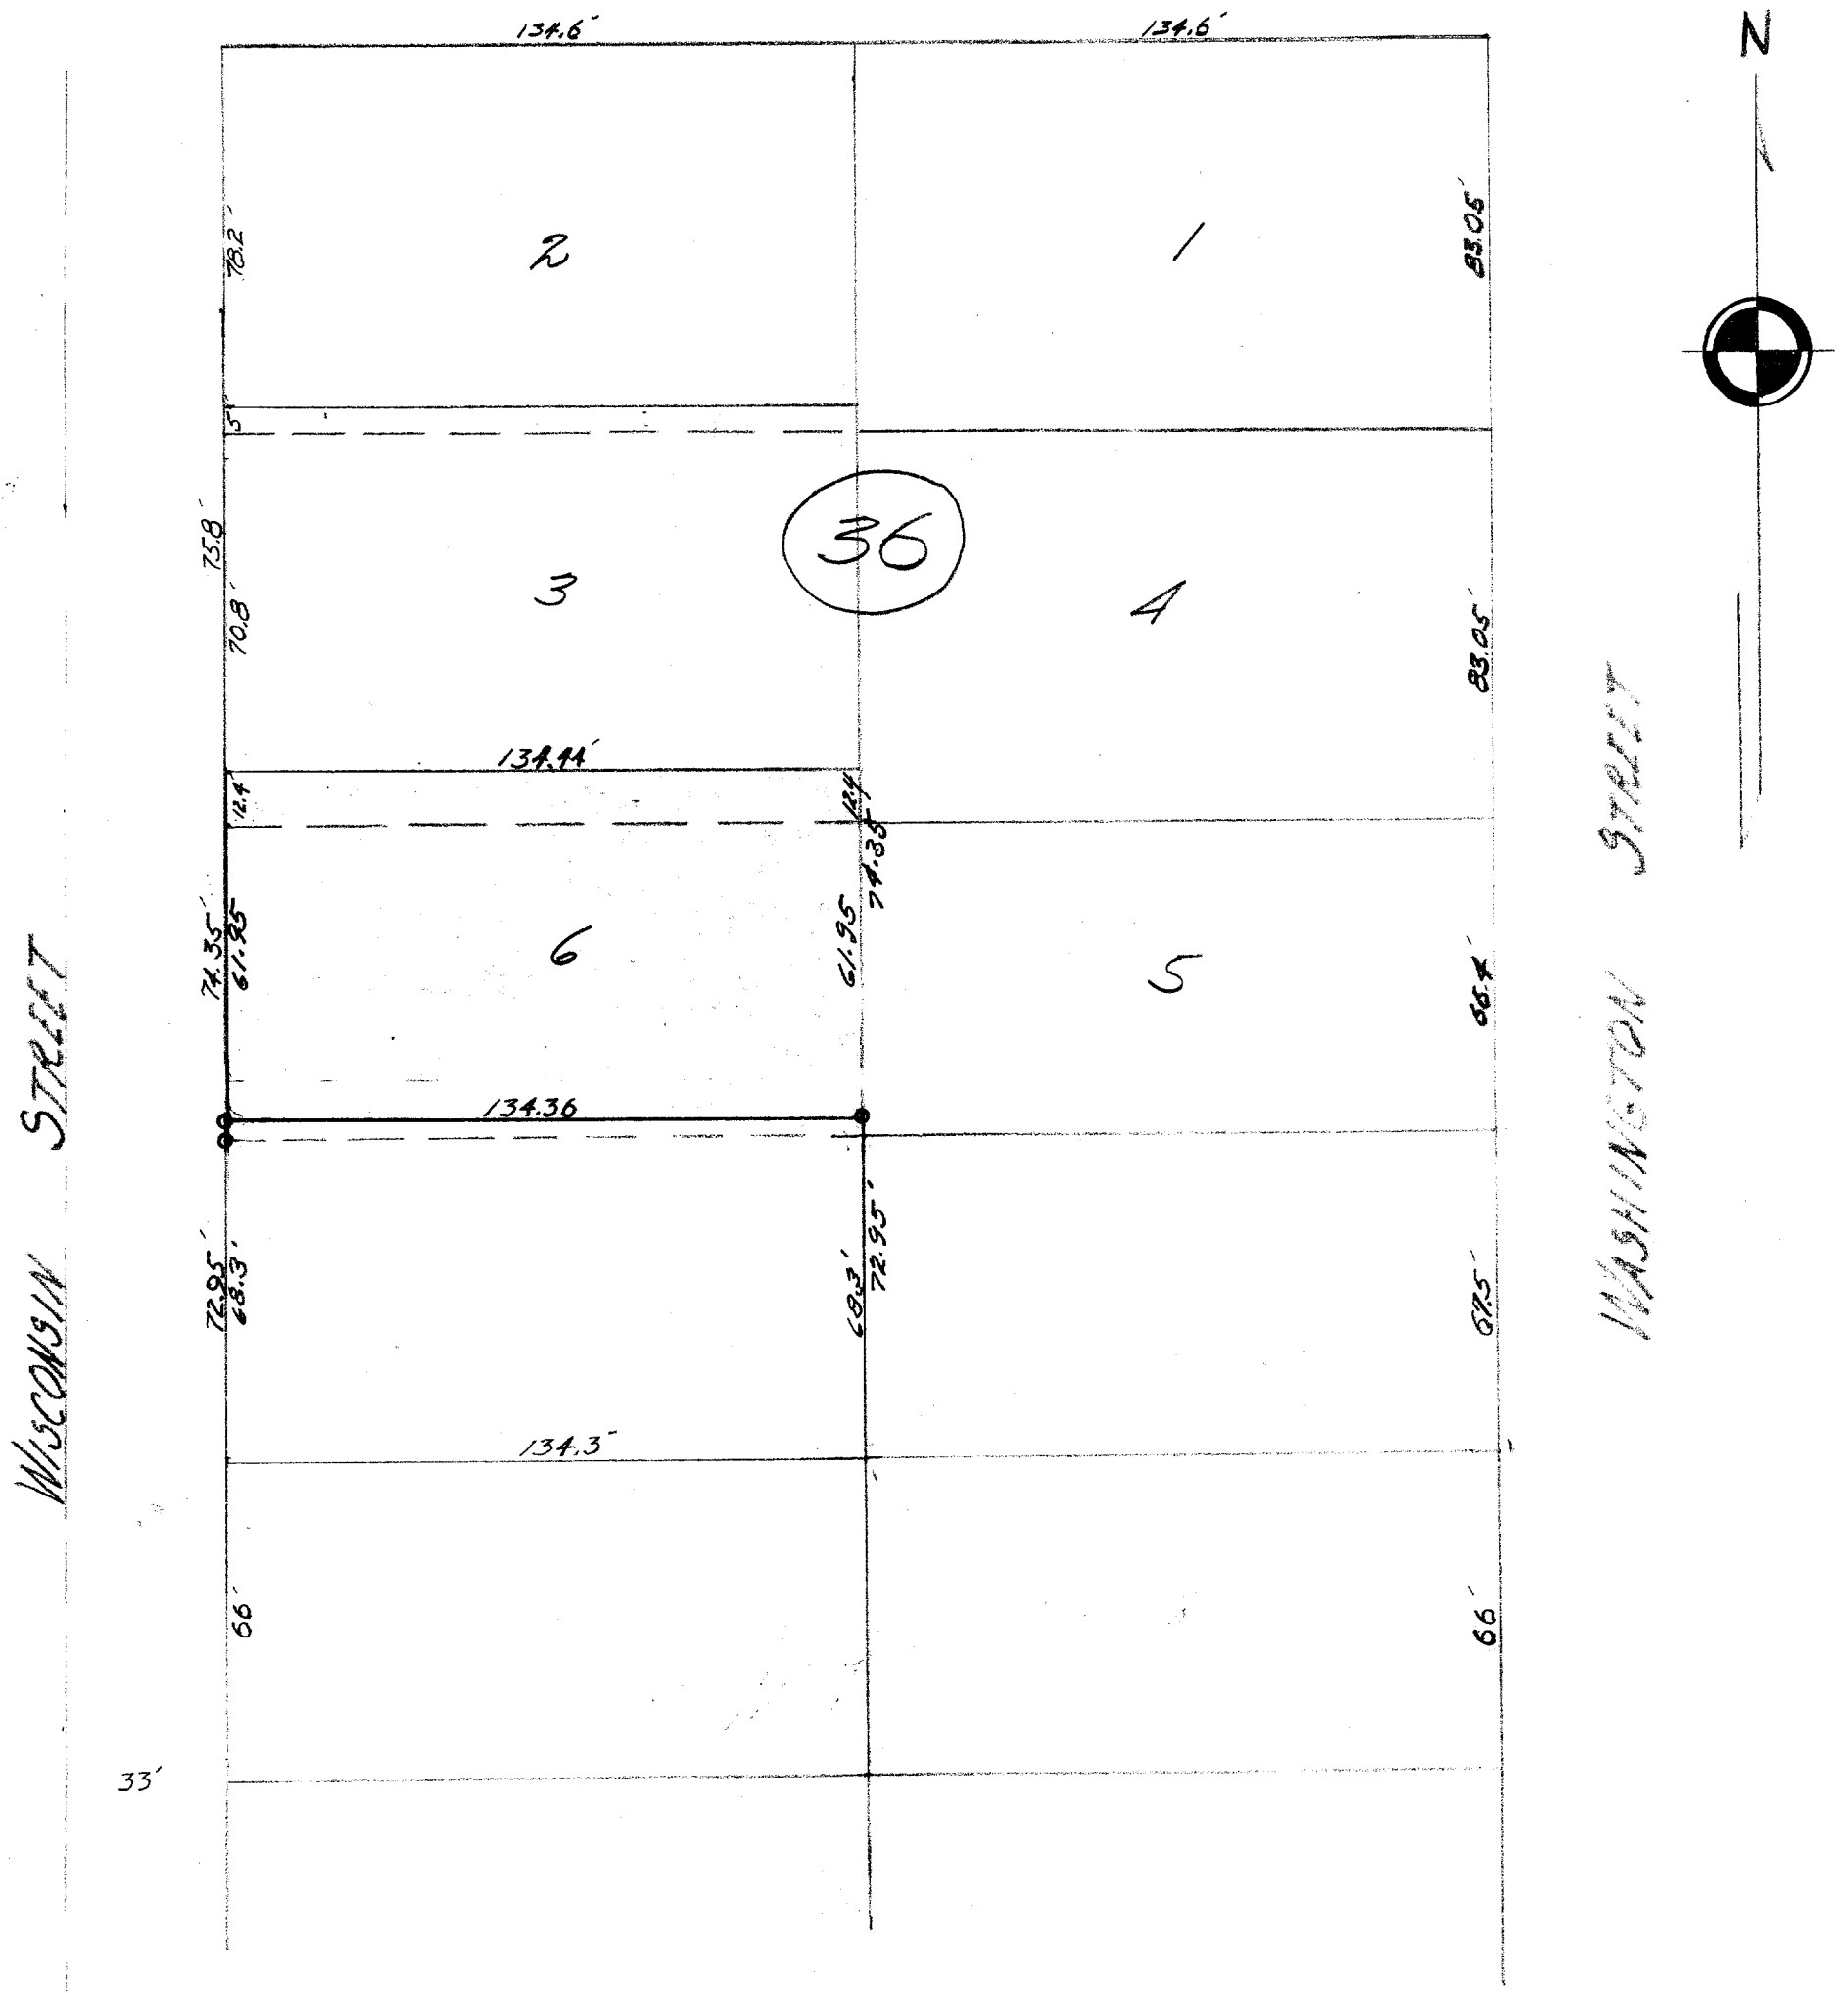

DESCRIPTION:

The South, 12.4 feet of Lot 3, Block 36, and the North 61.95 feet of Lot 6 Block 36, of Davis Addition to the City of Elkhorn, Walworth County, Wisconsin.

CERTIFICATE: I, hereby certify that I have on this the 4th day of June 1953, surveyed the above described property and that no encroachments exist. SIGNED AND SEALED ON THIS THE 5TH DAY OF JUNE 1953.

Joseph M. Biagi. Professional Engineer.
Elkhorn Wisconsin.

YD-5

4-68-B