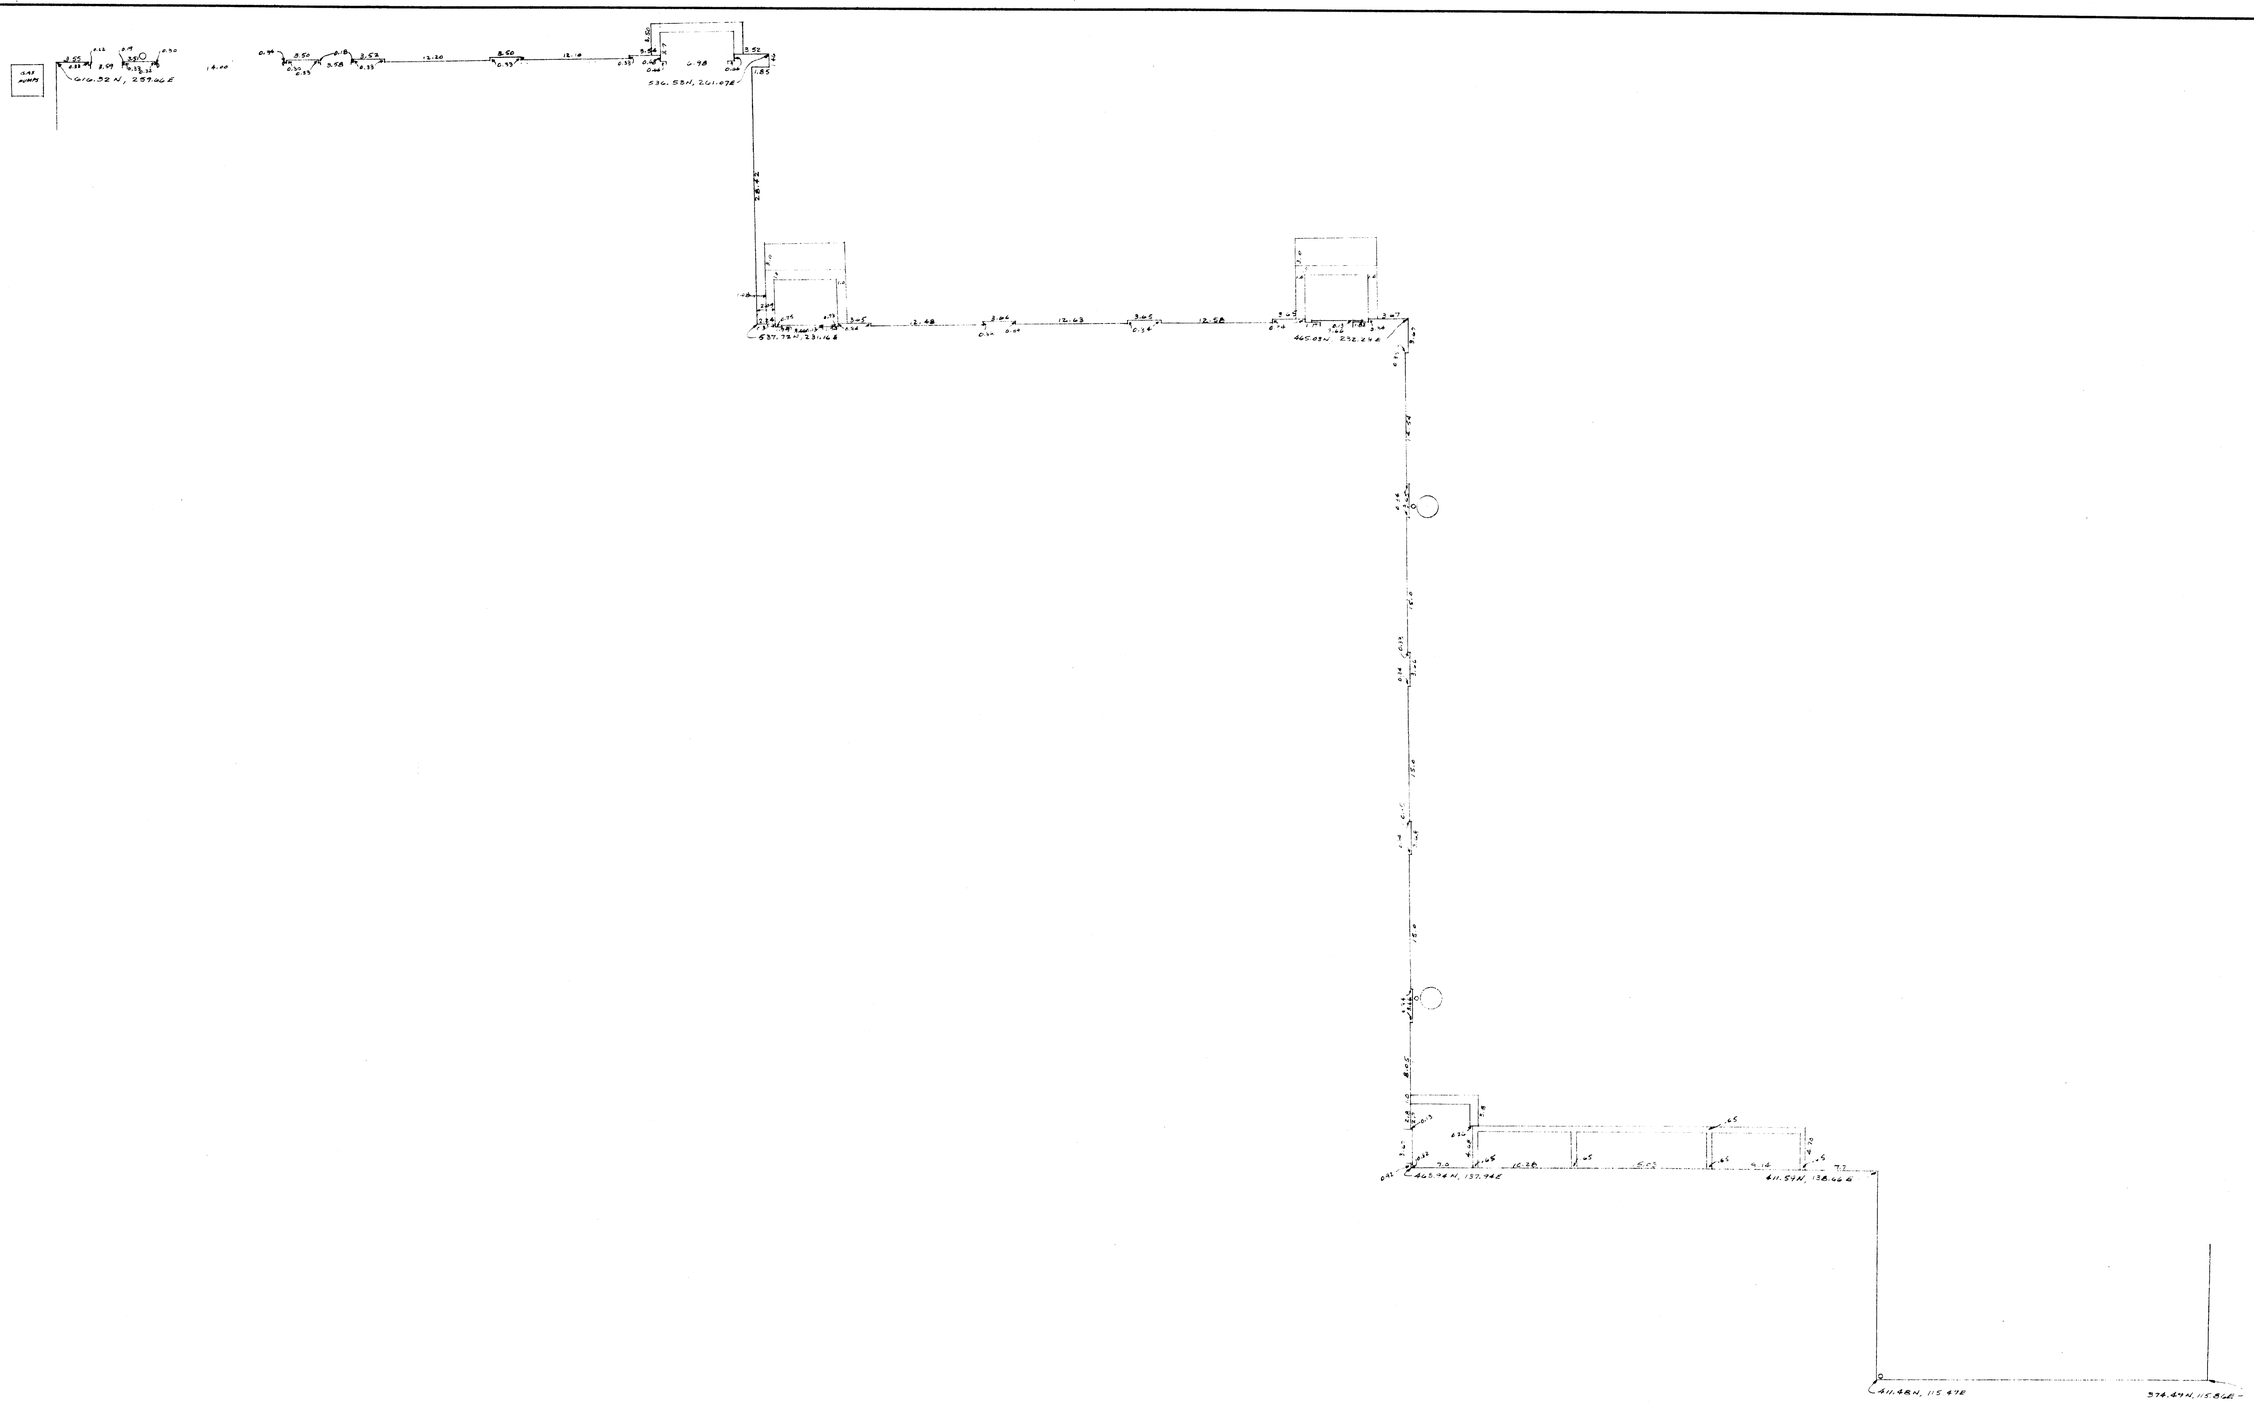


DIMENSIONS SHOWN ARE @ FOUNDATION FACE

BLOW-UP EAST SIDE
ELKHORN MIDDLE SCHOOL

DRAWN BY	JENSEN & JOHNSON CIVIL ENGINEERS ELKHORN, WIS.	SCALE: 1/2" = 1'-0"
CHECKED BY Lloyd F. Jensen		REVISED
APPROVED BY	DATE	SHEET NO. OF

K & E 10-7188 500-10-70

YAB - 17
YAB - 18

4-68 J