
#113-69

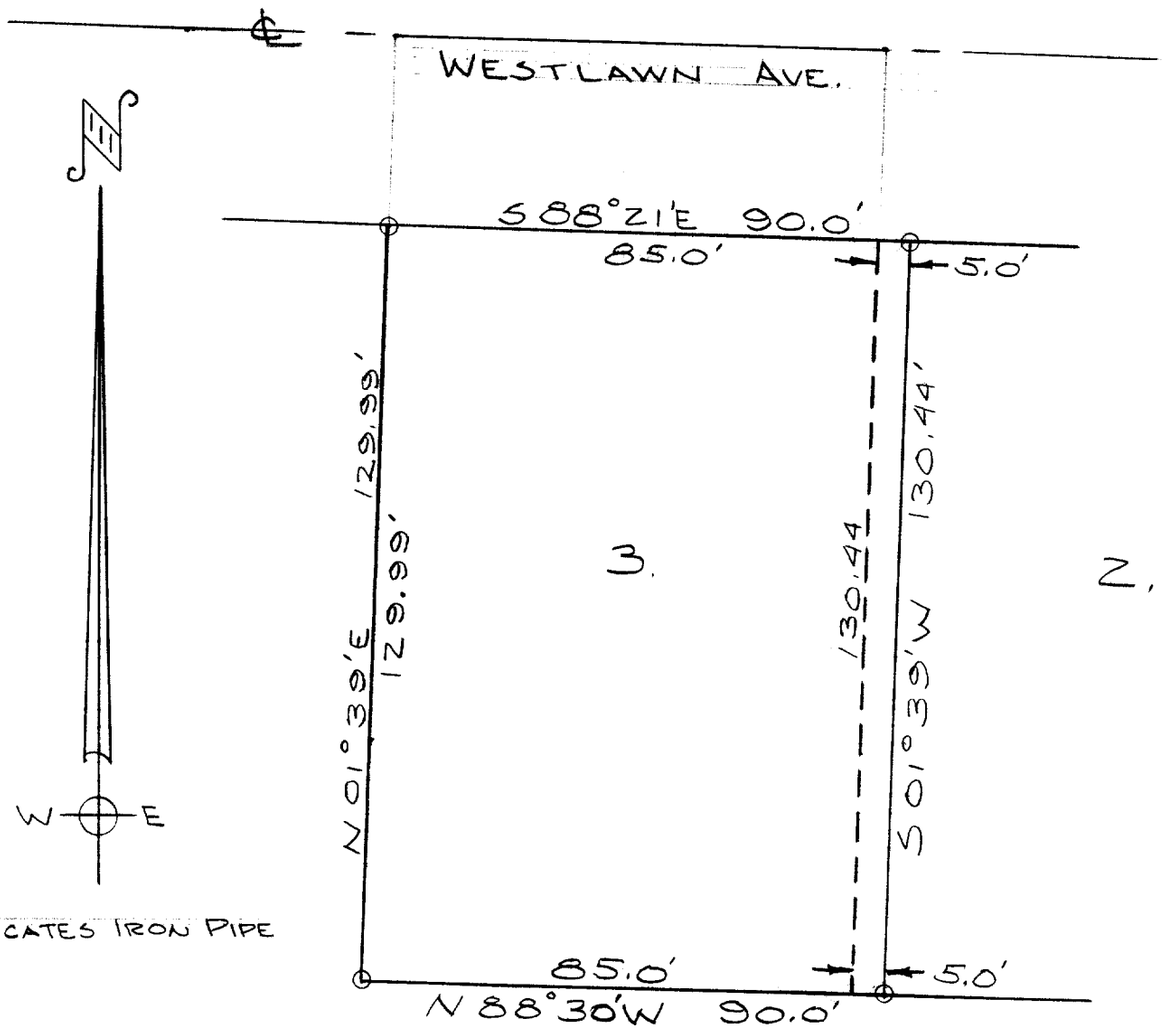

O INDICATES IRON PIPE

DESCRIPTION: Lot 3 and the West 5.00 feet of Lot 2 of Block 6 of Edgewood Second Addition in the City of Elkhorn, Walworth County, Wisconsin.

CERTIFICATE: I, James F. Biagi, surveyor, do hereby certify that I have surveyed the property hereon described.

WISCONSIN JAMES F. BIAGI MILWAUKEE, WIS. LAND SURVEYOR

James F. Biagi, R.L.S. 272

August 5, 1969

EA 2-8

4-6 B