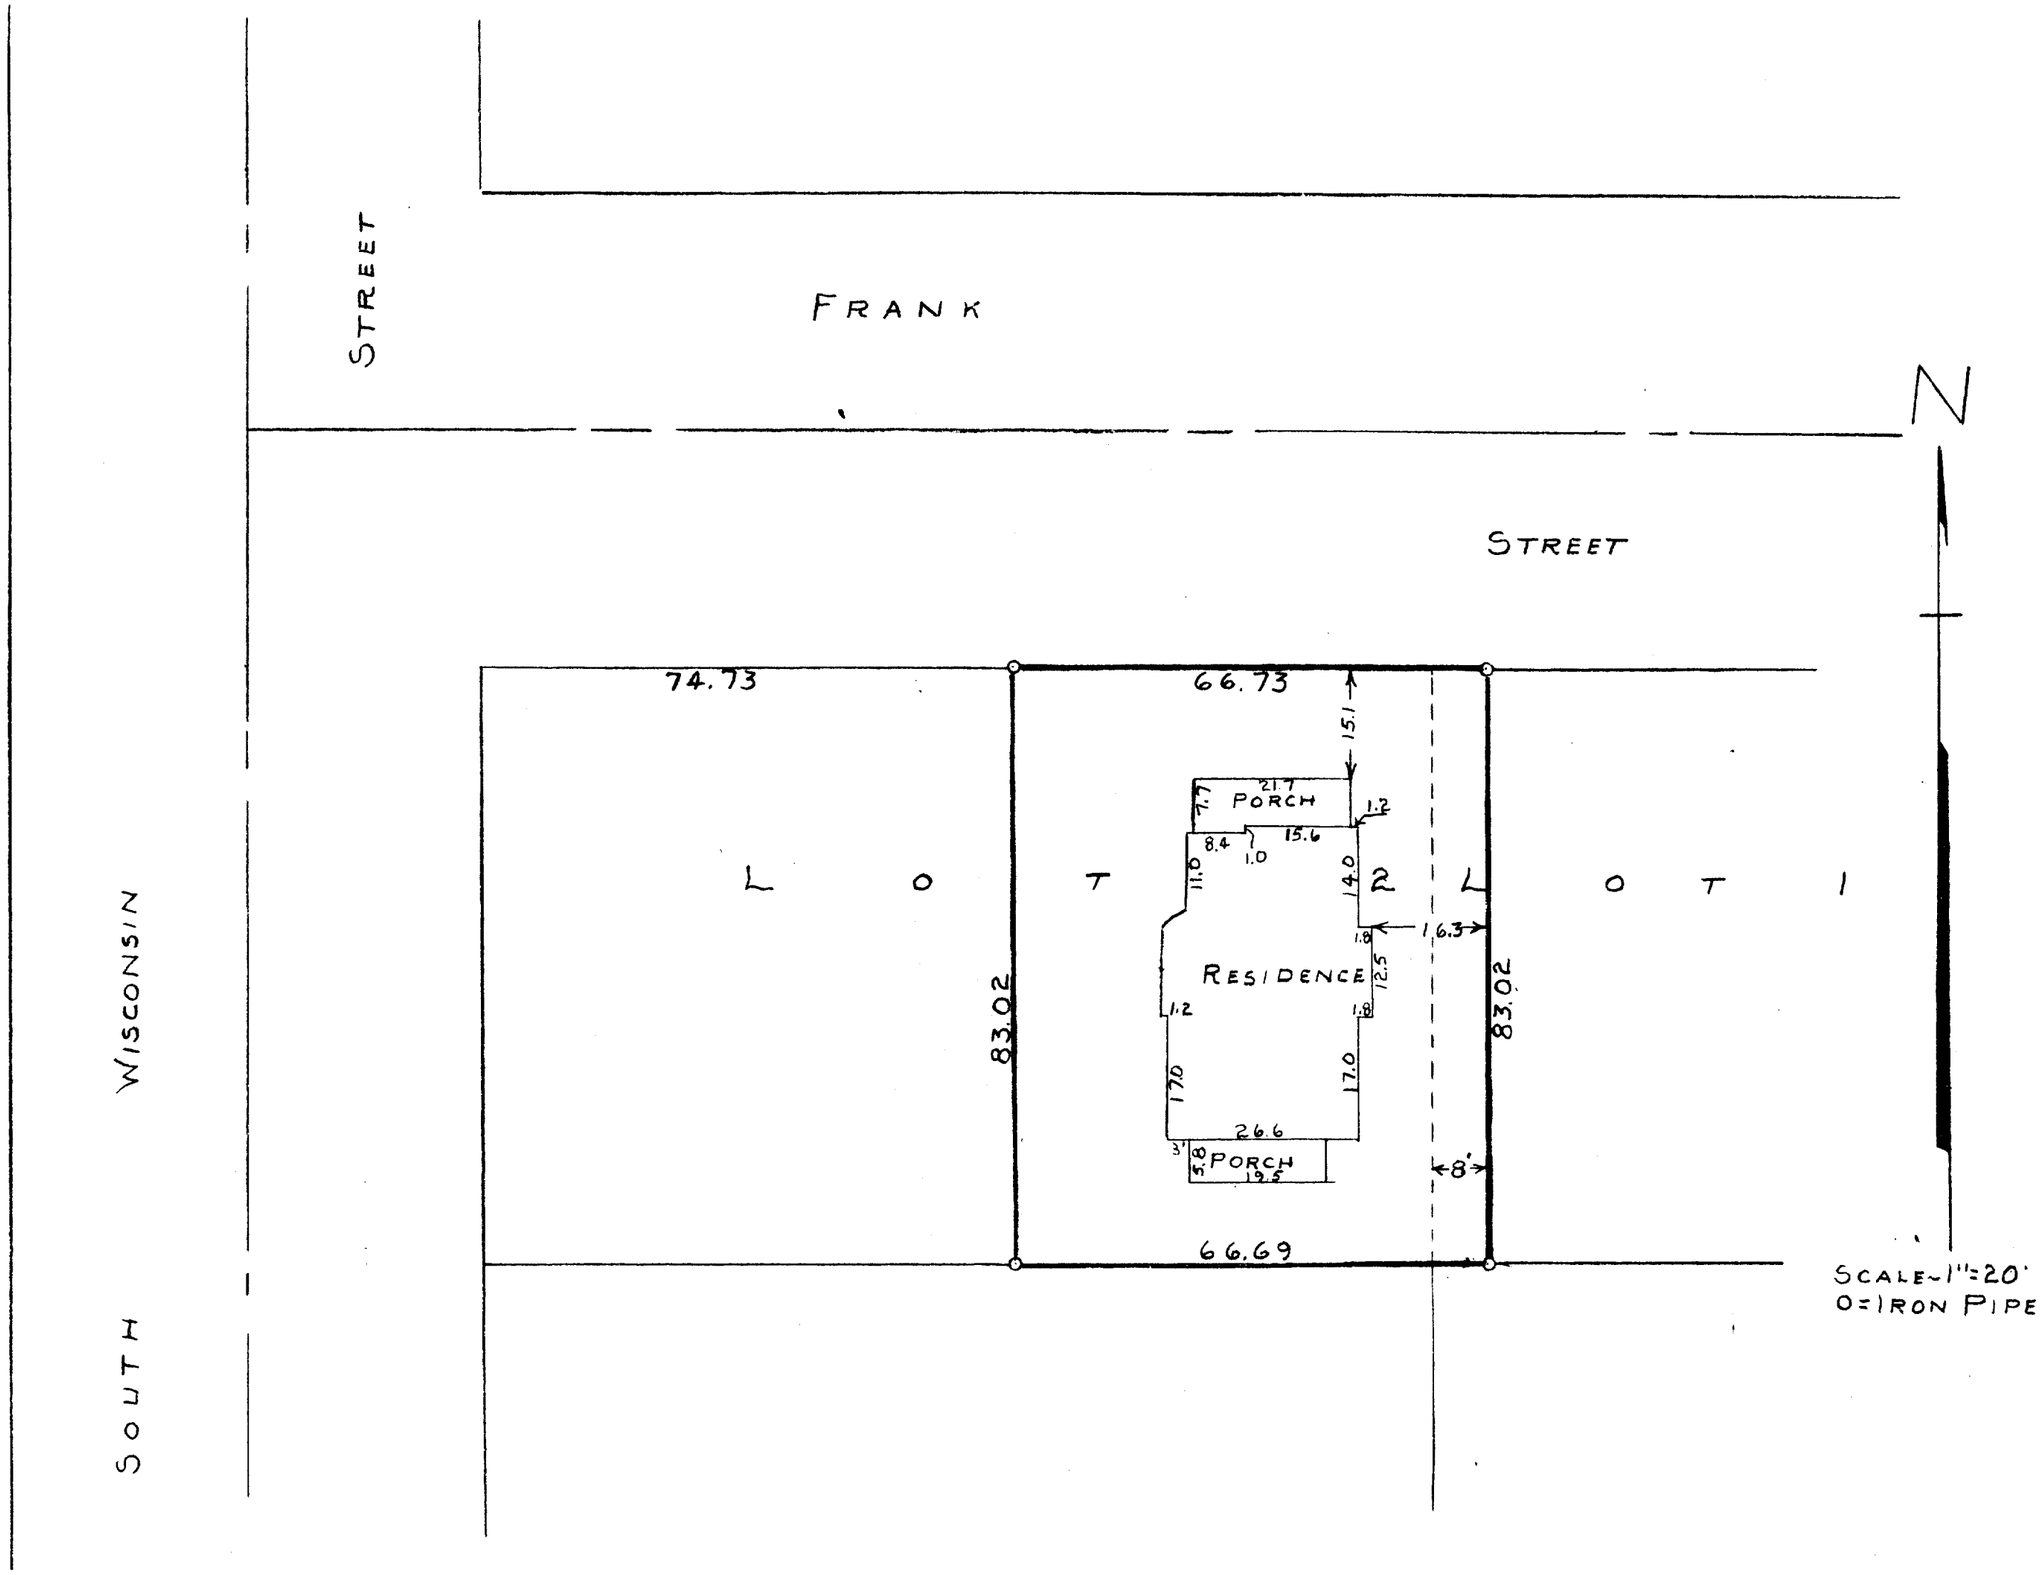

STATE OF WISCONSIN) SS
COUNTY OF WALWORTH)

I, GEORGE T. DUNHAM, DO HEREBY CERTIFY THAT I HAVE SURVEYED THE PROPERTY DESCRIBED AS FOLLOWS:

A PARCEL OF LAND LOCATED IN LOTS 1 AND 2, BLOCK 49 OF ROCKWELL'S SECOND ADDITION TO THE CITY OF ELKHORN, WALWORTH COUNTY, WISCONSIN, DESCRIBED AS FOLLOWS TO-WIT: THE EAST 1/2 OF SAID LOT 2 AND THE WEST 8.00 FEET OF SAID LOT 1, EXCEPTING THEREFROM THE WEST 8.00 FEET OF THE EAST 1/2 OF SAID LOT 2.

AND THAT THE PLAT SHOWN ABOVE IS A CORRECT REPRESENTATION OF THE PROPERTY LINES.

APRIL 2, 1956

George T. Dunham
GEORGE T. DUNHAM, SURVEYOR
DELAVAN WISCONSIN

4-7

YRW2-17