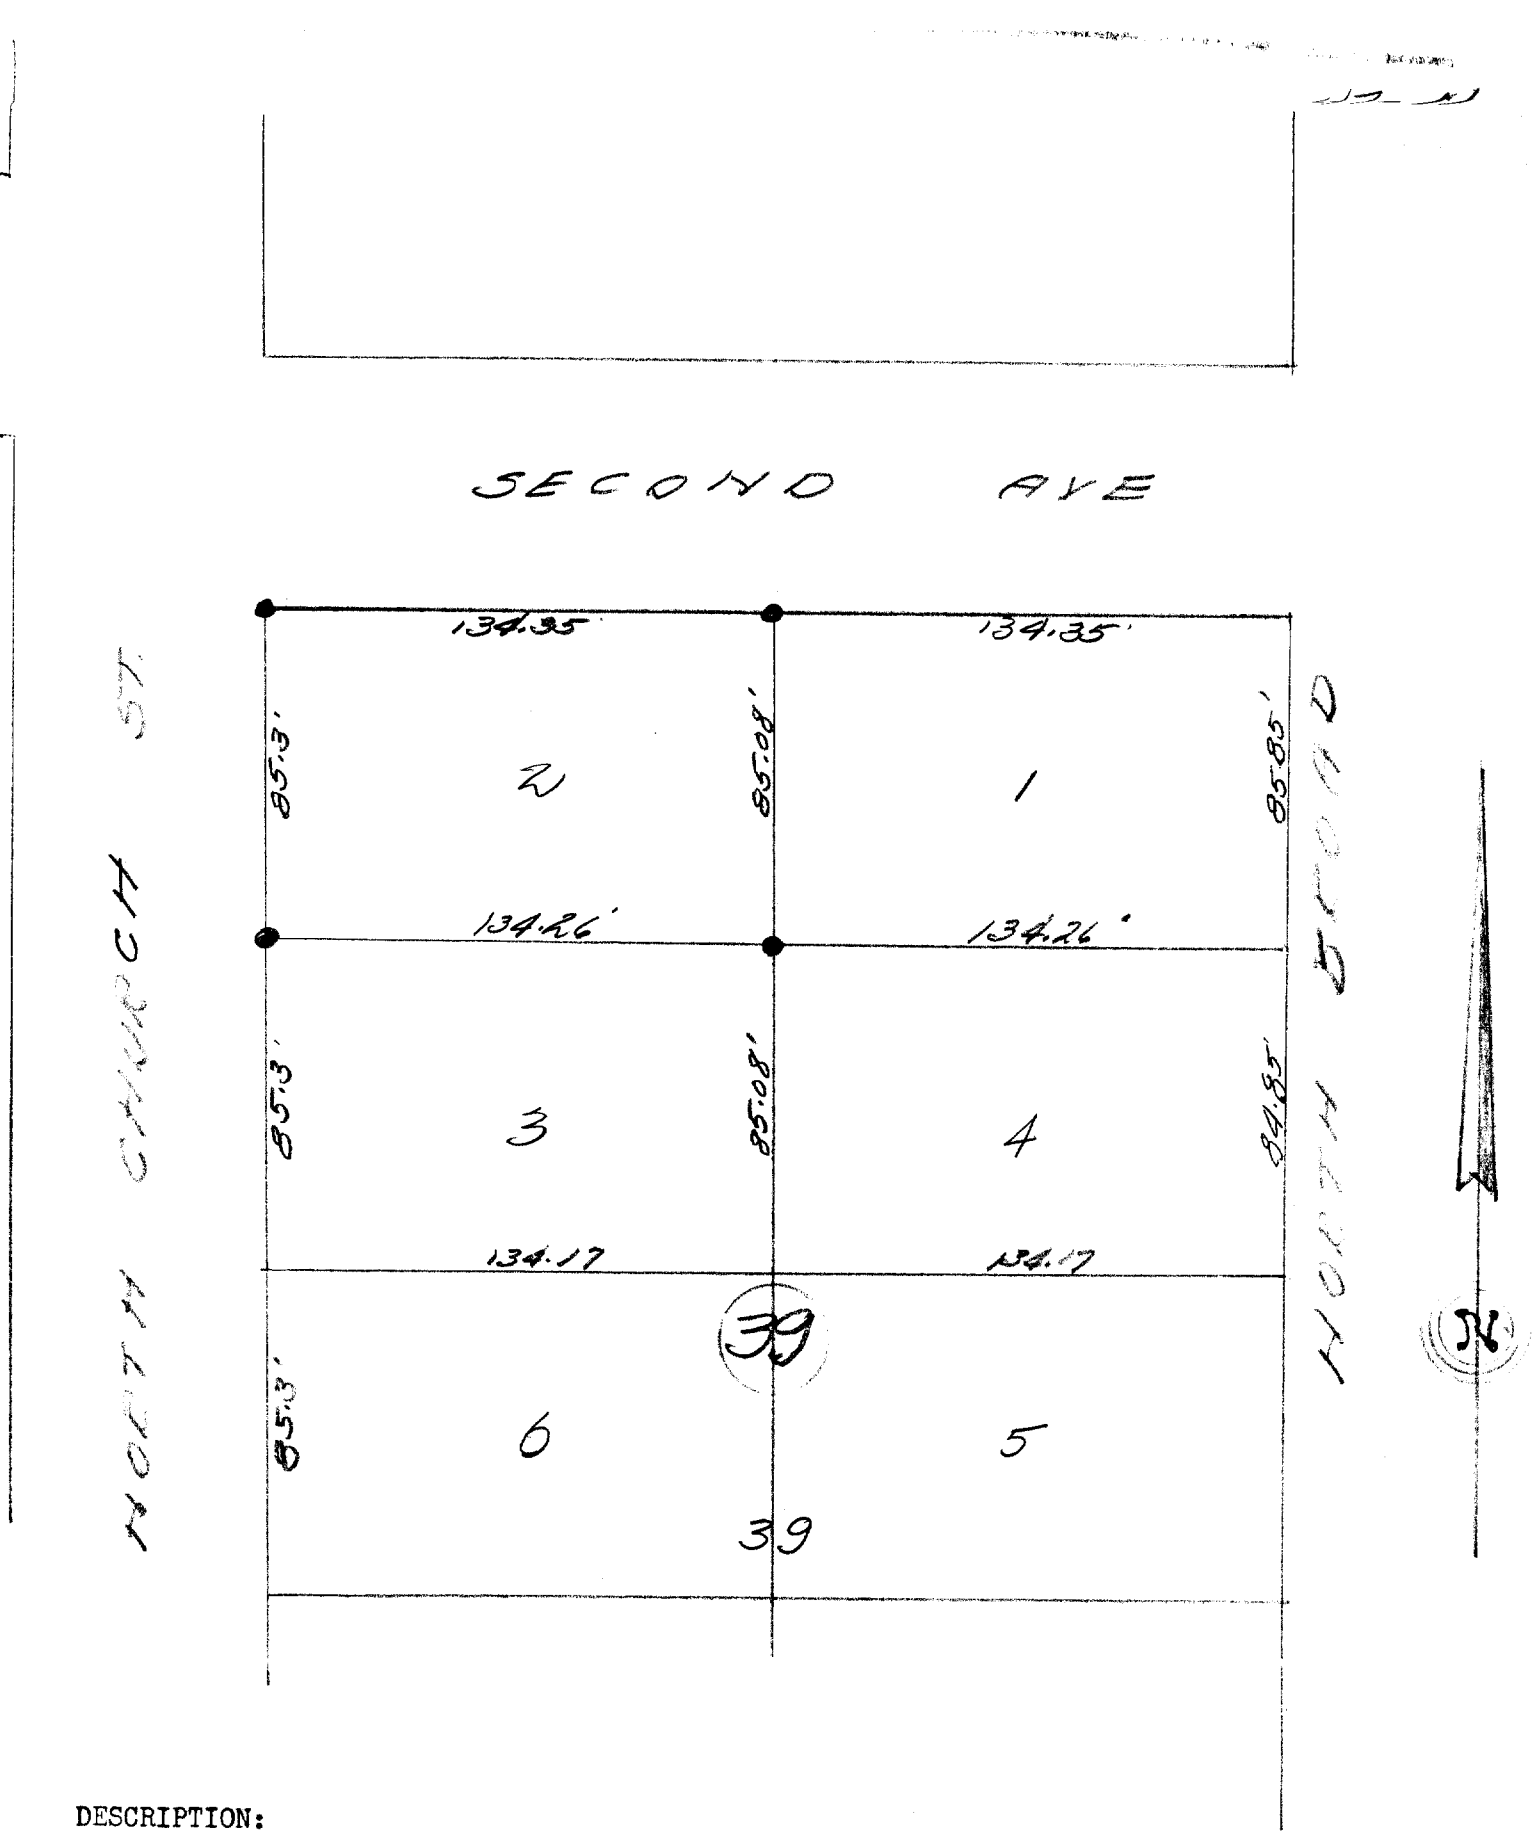


DESCRIPTION:

Lot 2, Block 39 of the Davis Addittion to the City of Elkhorn, Walworth County Wisconsin.

CERTIFICATE:

I, Joseph M. Biagi, hereby certify that I have on this the 12th day of August, 1947, survryed the above described property according to the official records on file in the office of the Recorder of Deeds in and for Walworth County, Wisconsin, and find that the measurements and bearings of the boundary lines of said property as taken at the site on this day, substantially agree with those in the above description and that no encroachments exist.

SIGNED AND SEALED THIS 12TH DAY OF AUGUST 1947.

Joseph M. Biagi. Professional Engineer.
Elkhorn Wisconsin.

YD-26A

4-71-B