55-25

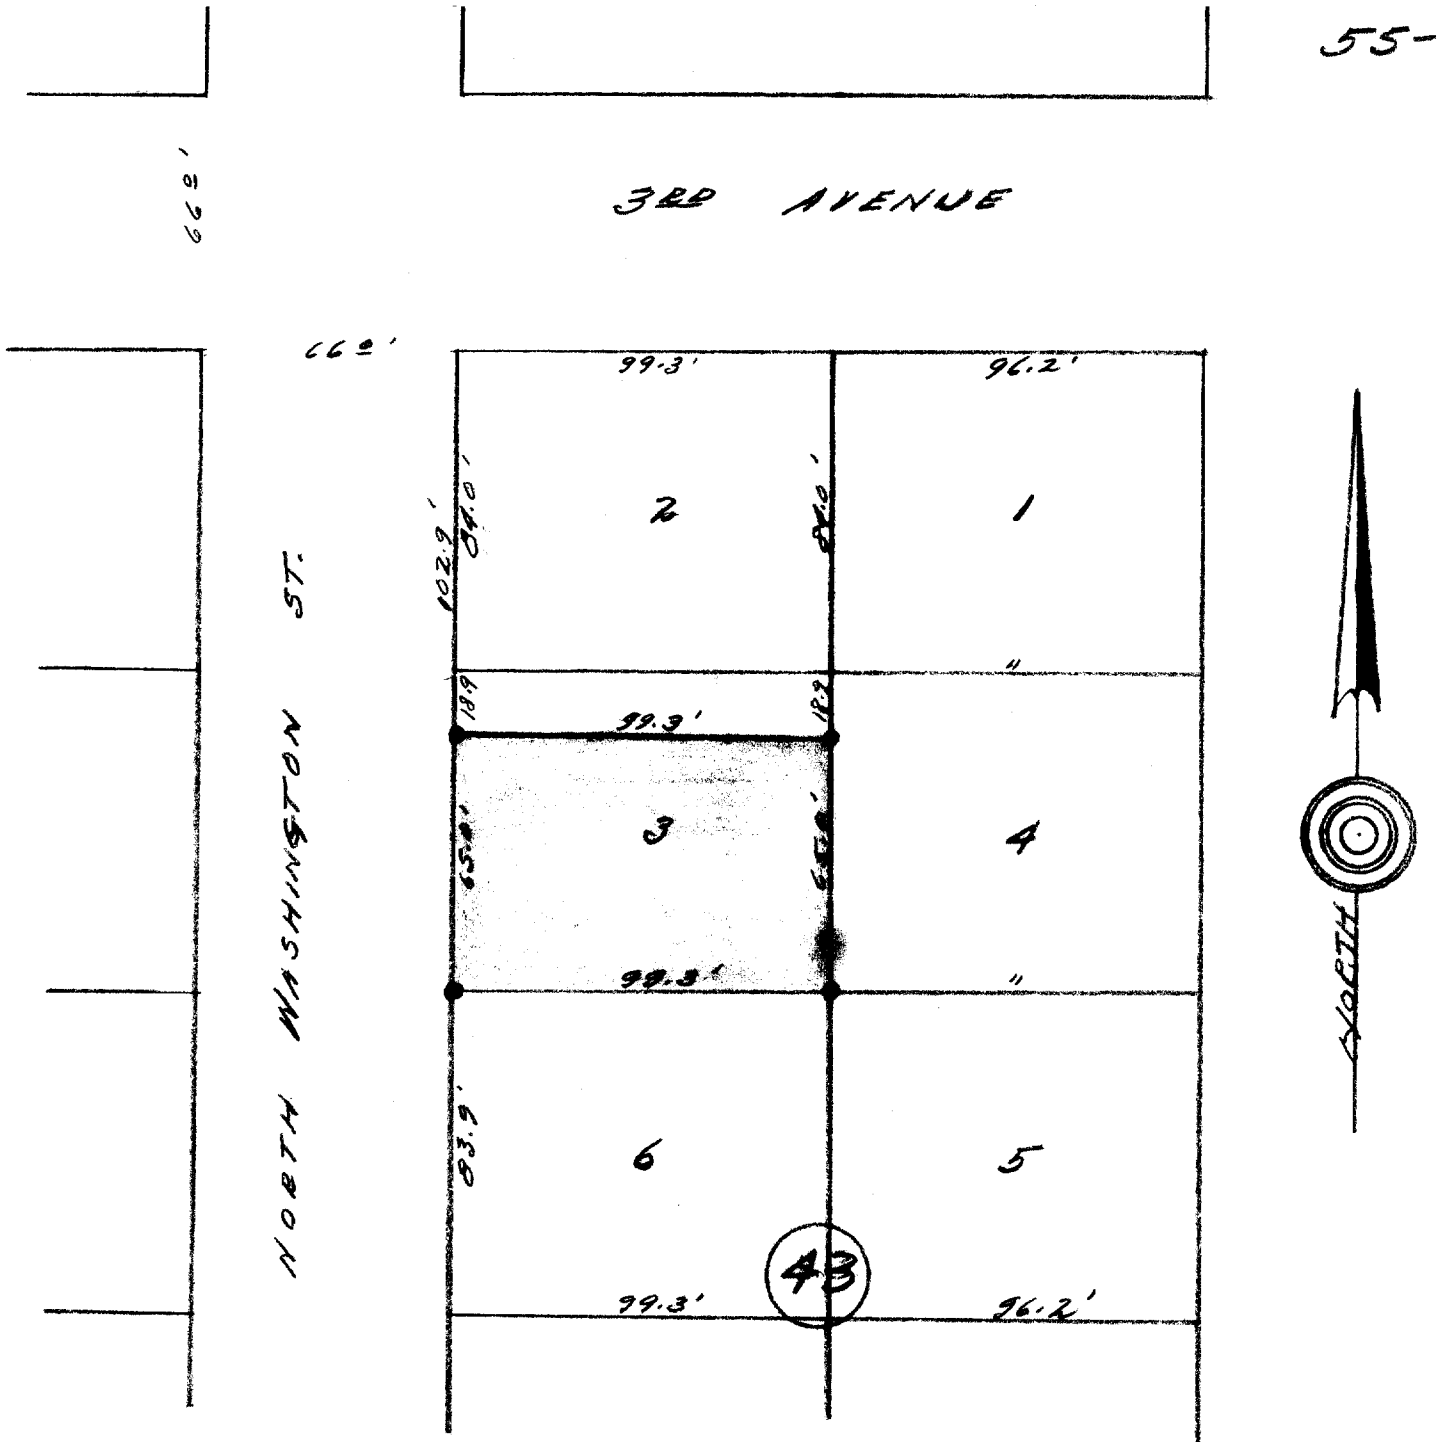

DESCRIPTION: The south 65 feet of Lot 3, Block 43 Davis Addition to the City of Elkhorn, Walworth County, Wisconsin.

CERTIFICATE: I, hereby certify that I have on this the 26th day of March 1955. surveyed the above described property.

SIGNED AND SEALED ON THIS THE 1ST DAY OF APRIL 1955.

Joseph M. Biagi

Joseph M. Biagi. Professional Engineer.
Elkhorn Wisconsin.

YD-47B

4-74-B