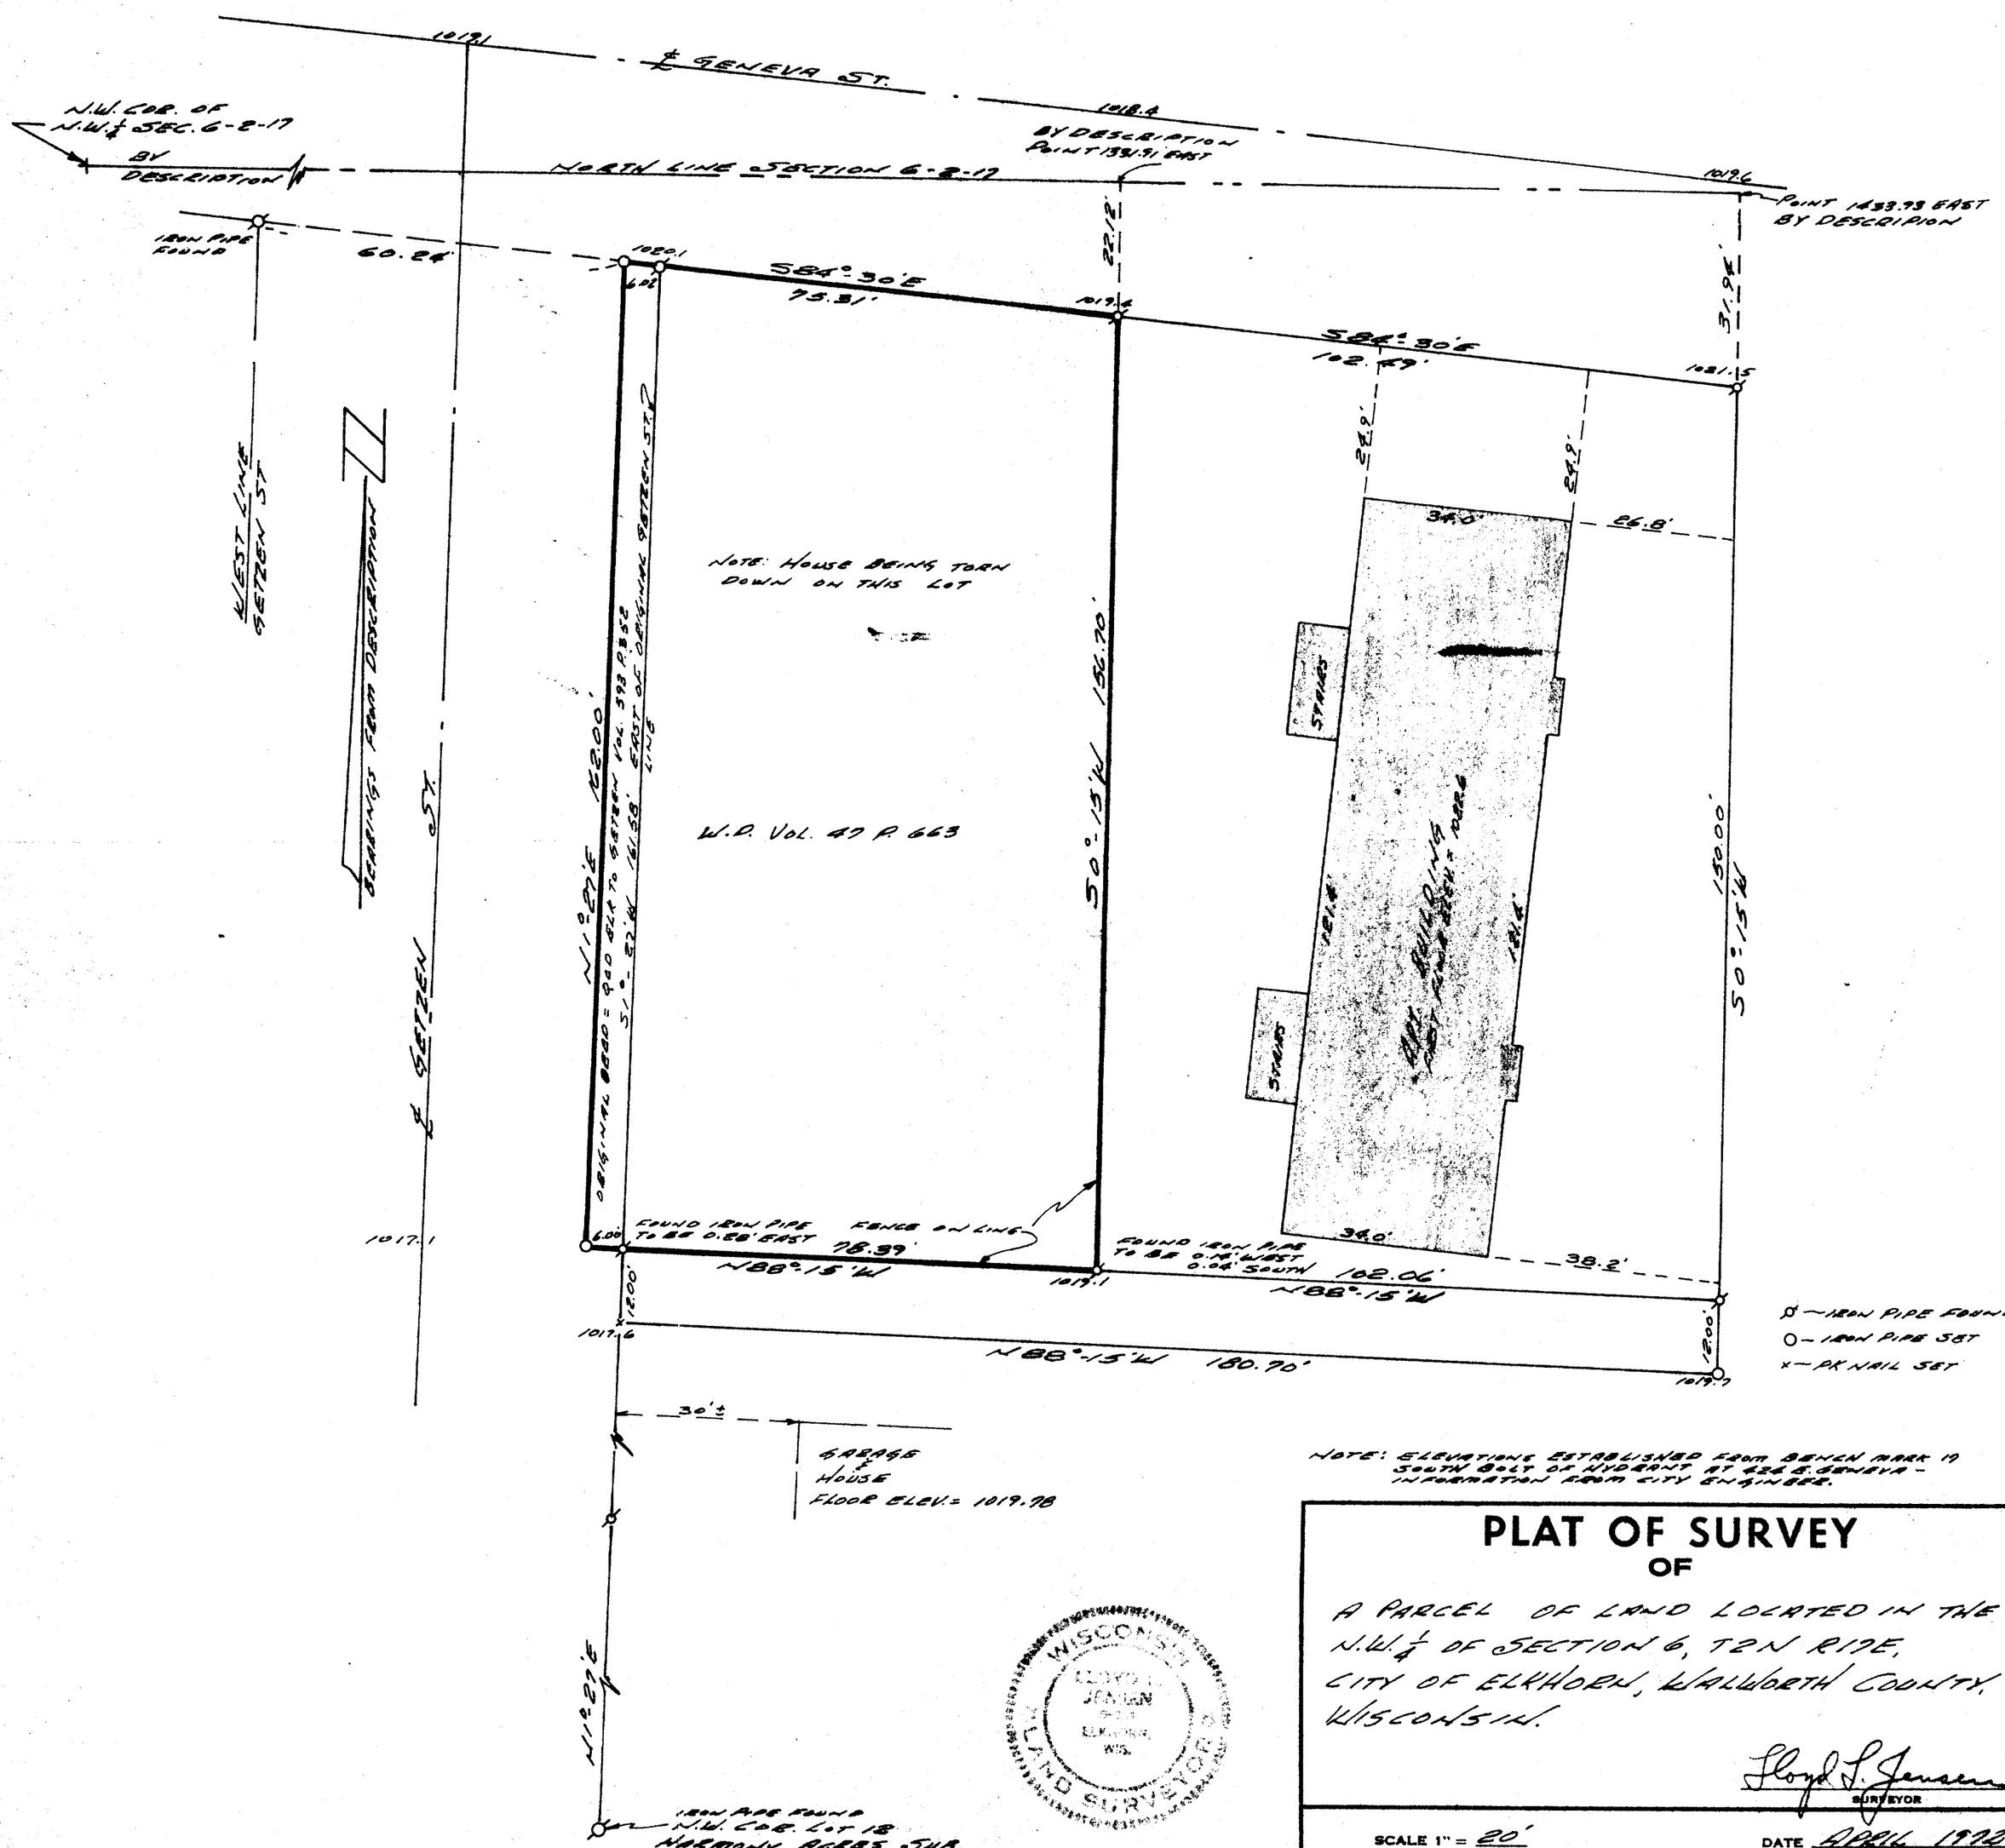


PLAT OF SURVEY
OF

A PARCEL OF LAND LOCATED IN THE N.W.¼ OF SECTION 6, T2N R12E, CITY OF ELKHORN, WALWORTH COUNTY, WISCONSIN.

Floyd L. Jensen
SURVEYOR

SCALE 1" = 20'

DATE APRIL 1972