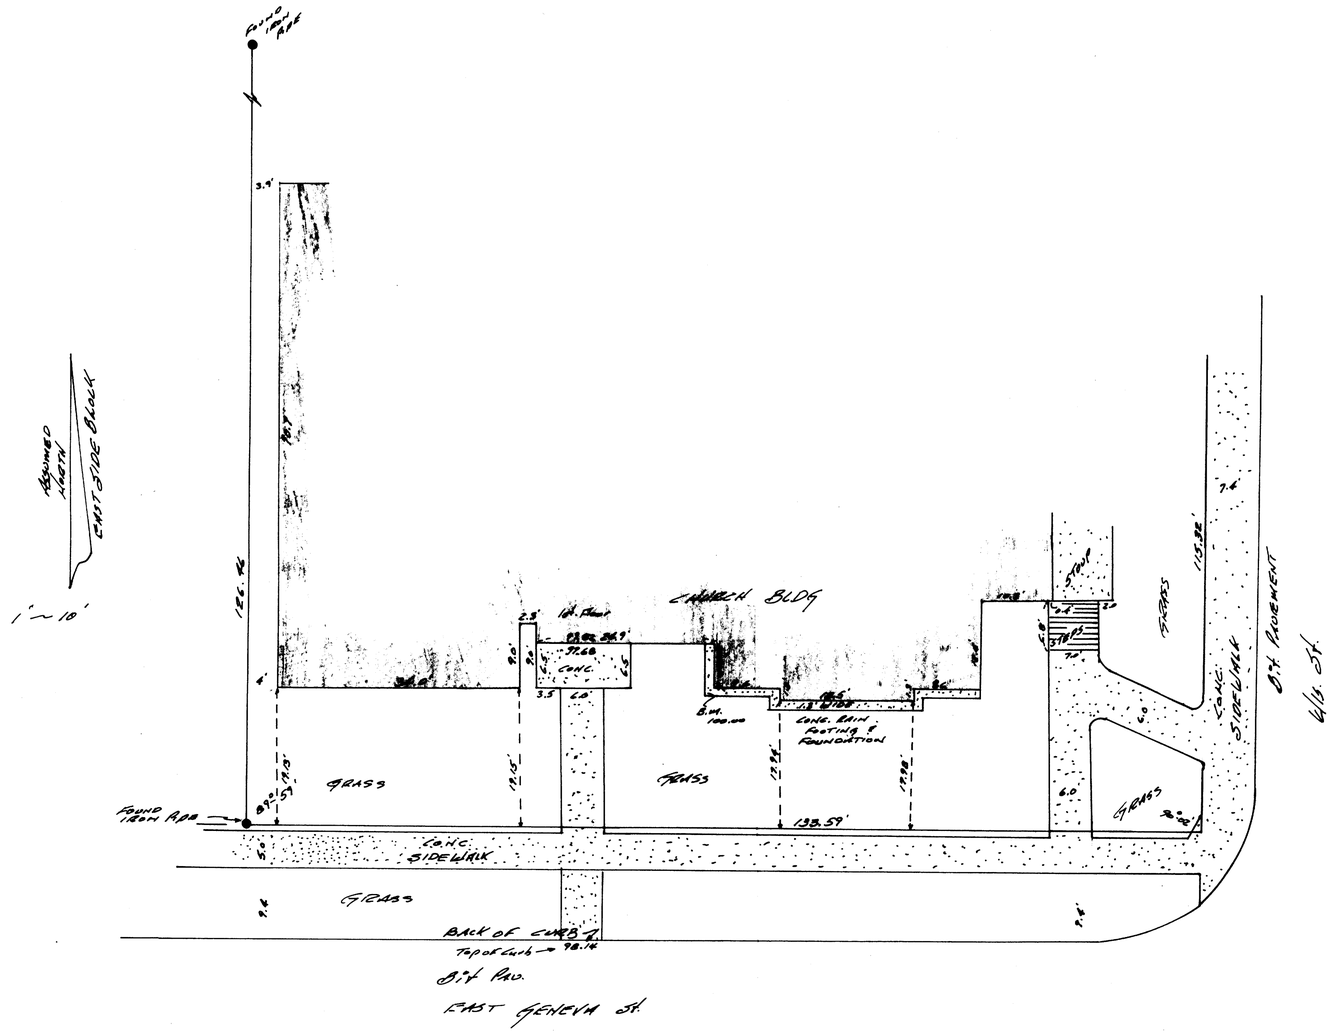

PLAT OF SURVEY OF THE SOUTH½ OF LOT 10 BLOCK 26, ORIGINAL PLAT, CITY OF ELKHORN, WALWORTH CO. WIS.

I, Thomas P.A. Jensen, Wisconsin Registered Land Surveyor, do hereby certify that this survey was performed by me, or under my direction, in full compliance with the owner's/agent's instructions and Chapter A-E 7 of the Wisconsin Administrative Code "Minimum Standards For Property Surveys"; and that this map is an accurate representation thereof to the best of my knowledge and belief.

Thomas P.A. Jensen R.L.S-1084
Jensen Surveying & Mapping S.C.

RECEIVED FEB 10 1993

Yop-239

004-775

1992.125