
KOLB LAND CONSULTING, INC.

LAND SURVEYING · SUBDIVIDING · LAND PLANNING

929 WILLIAMS STREET LAKE GENEVA, WISCONSIN 53147 414-248-3697

NOTE: RELOCATED PROPERTY CORNERS AND IMPROVEMENTS JUNE 19, 1992.

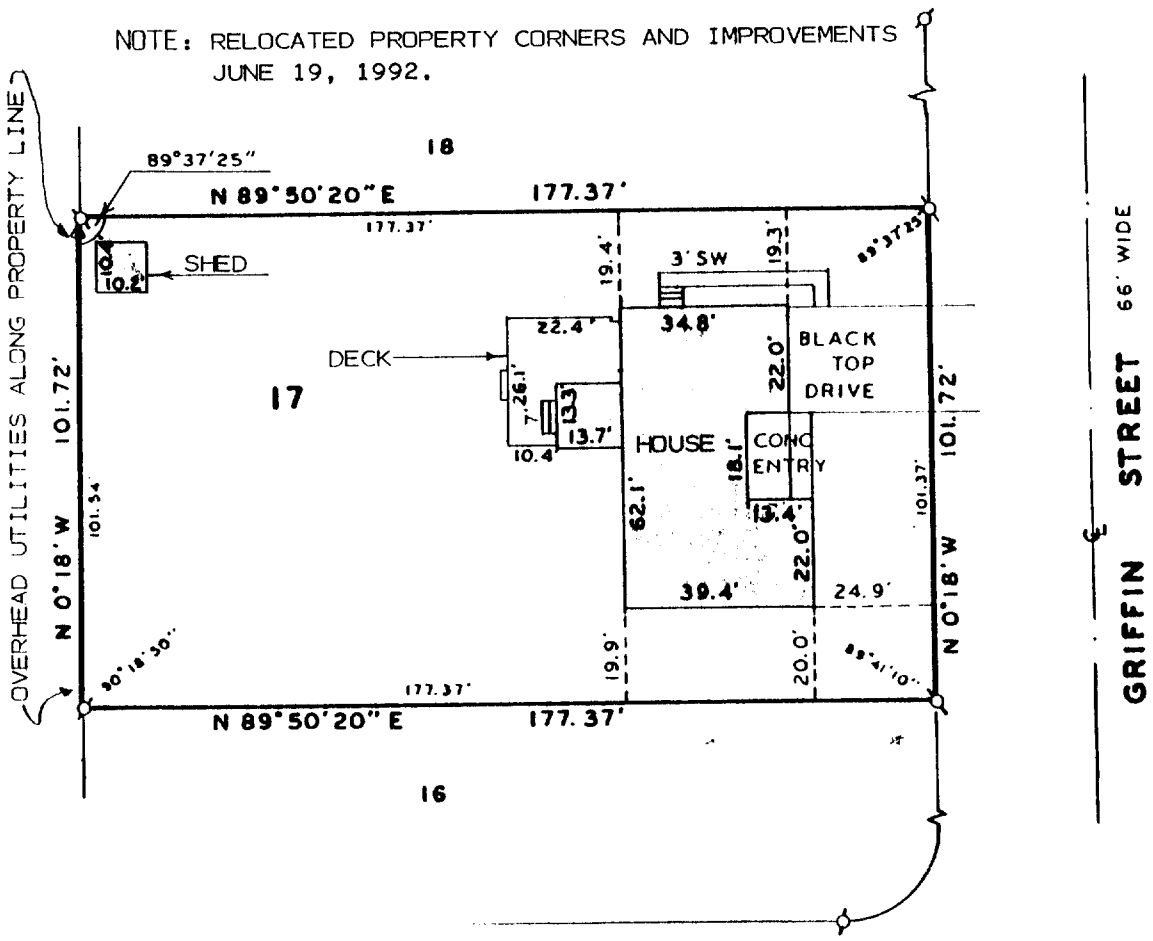

SCALE: 1" = 40'

PLAT OF SURVEY OF

LOT 17 OF BARTELSON'S FIRST ADDITION, LOCATED IN THE NORTHWEST 1/4 OF THE SOUTHWEST 1/4 OF SECTION 36, T3N, R16E, CITY OF ELKHORN, WALWORTH COUNTY, WISCONSIN.

LEGEND

- ø – IRON PIPE FOUND
- o – IRON PIPE SET
- SW – SIDE WALK
- 90°00'00" / 100' – FIELD MEASUREMENTS
- Δ – UTILITY POLE

ORDERED BY: LEON WIRTH
106 GRIFFIN STREET
ELKHORN, WI. 53121

RECEIVED
MAR 2 5 1993

YBA-2

I HEREBY CERTIFY THAT I HAVE SURVEYED THE ABOVE DESCRIBED PROPERTY AND THAT THE ABOVE MAP IS A TRUE REPRESENTATION THEREOF AND SHOWS THE SIZE AND LOCATION OF THE PROPERTY, ITS EXTERIOR BOUNDARIES, THE LOCATION OF ALL VISIBLE STRUCTURES AND DIMENSIONS OF ALL PRINCIPAL BUILDINGS THEREON, BOUNDARY FENCES, APPARENT EASEMENTS, ROADWAYS AND VISIBLE ENCROACHMENTS, IF ANY, TO THE BEST OF MY KNOWLEDGE AND BELIEF. THIS SURVEY IS MADE FOR THE USE OF THE PRESENT OWNERS OF THE PROPERTY AND ALSO THOSE WHO PURCHASE, MORTGAGE OR GUARANTEE THE TITLE THERETO WITHIN ONE (1) YEAR FROM DATE HEREOF.
SURVEY NOT VALID UNLESS SURVEYOR'S SIGNATURE IS IN RED.

HAROLD H. KOLB

WISCONSIN REGISTERED LAND SURVEYOR, S-187

DATE

REVISED

REVISED 0004-786