
#113-69

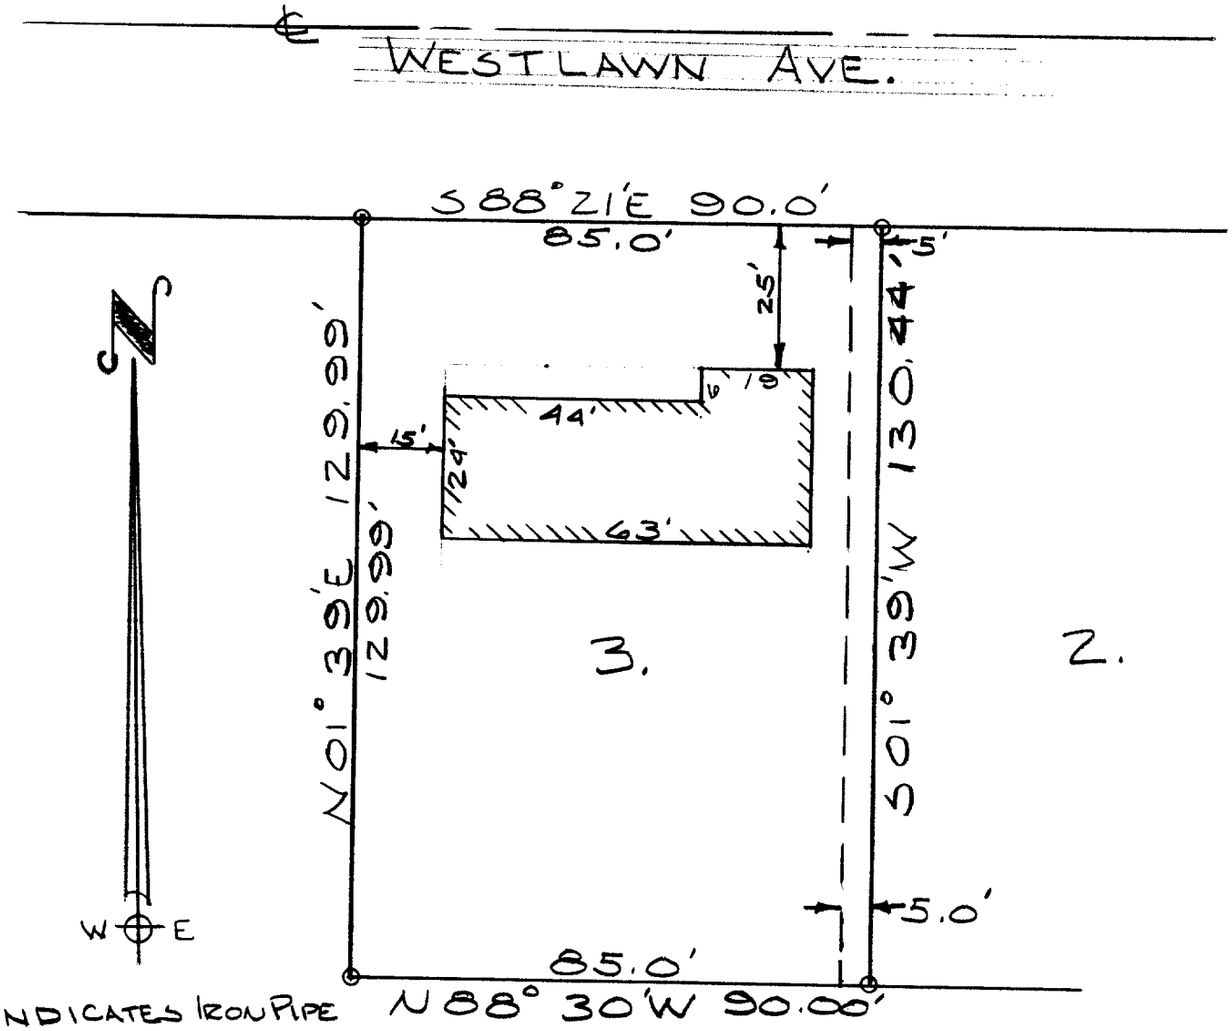

DESCRIPTION: Lot 3 and the West 5.00 feet of Lot 2 Block 6 of Edgewood Second Addition in the City of Elkhorn, Walworth County, Wisconsin.

CERTIFICATE: I, James F. Biagi, surveyor do hereby certify that I have surveyed the property hereon described.

James F. Biagi RLS 272
Elkhorn, Wisconsin.

August 15th 1969

WISCONSIN JAMES F. BIAGI ELKHORN, WIS. LAND SURVEYOR

EA 2-3

4-8 B