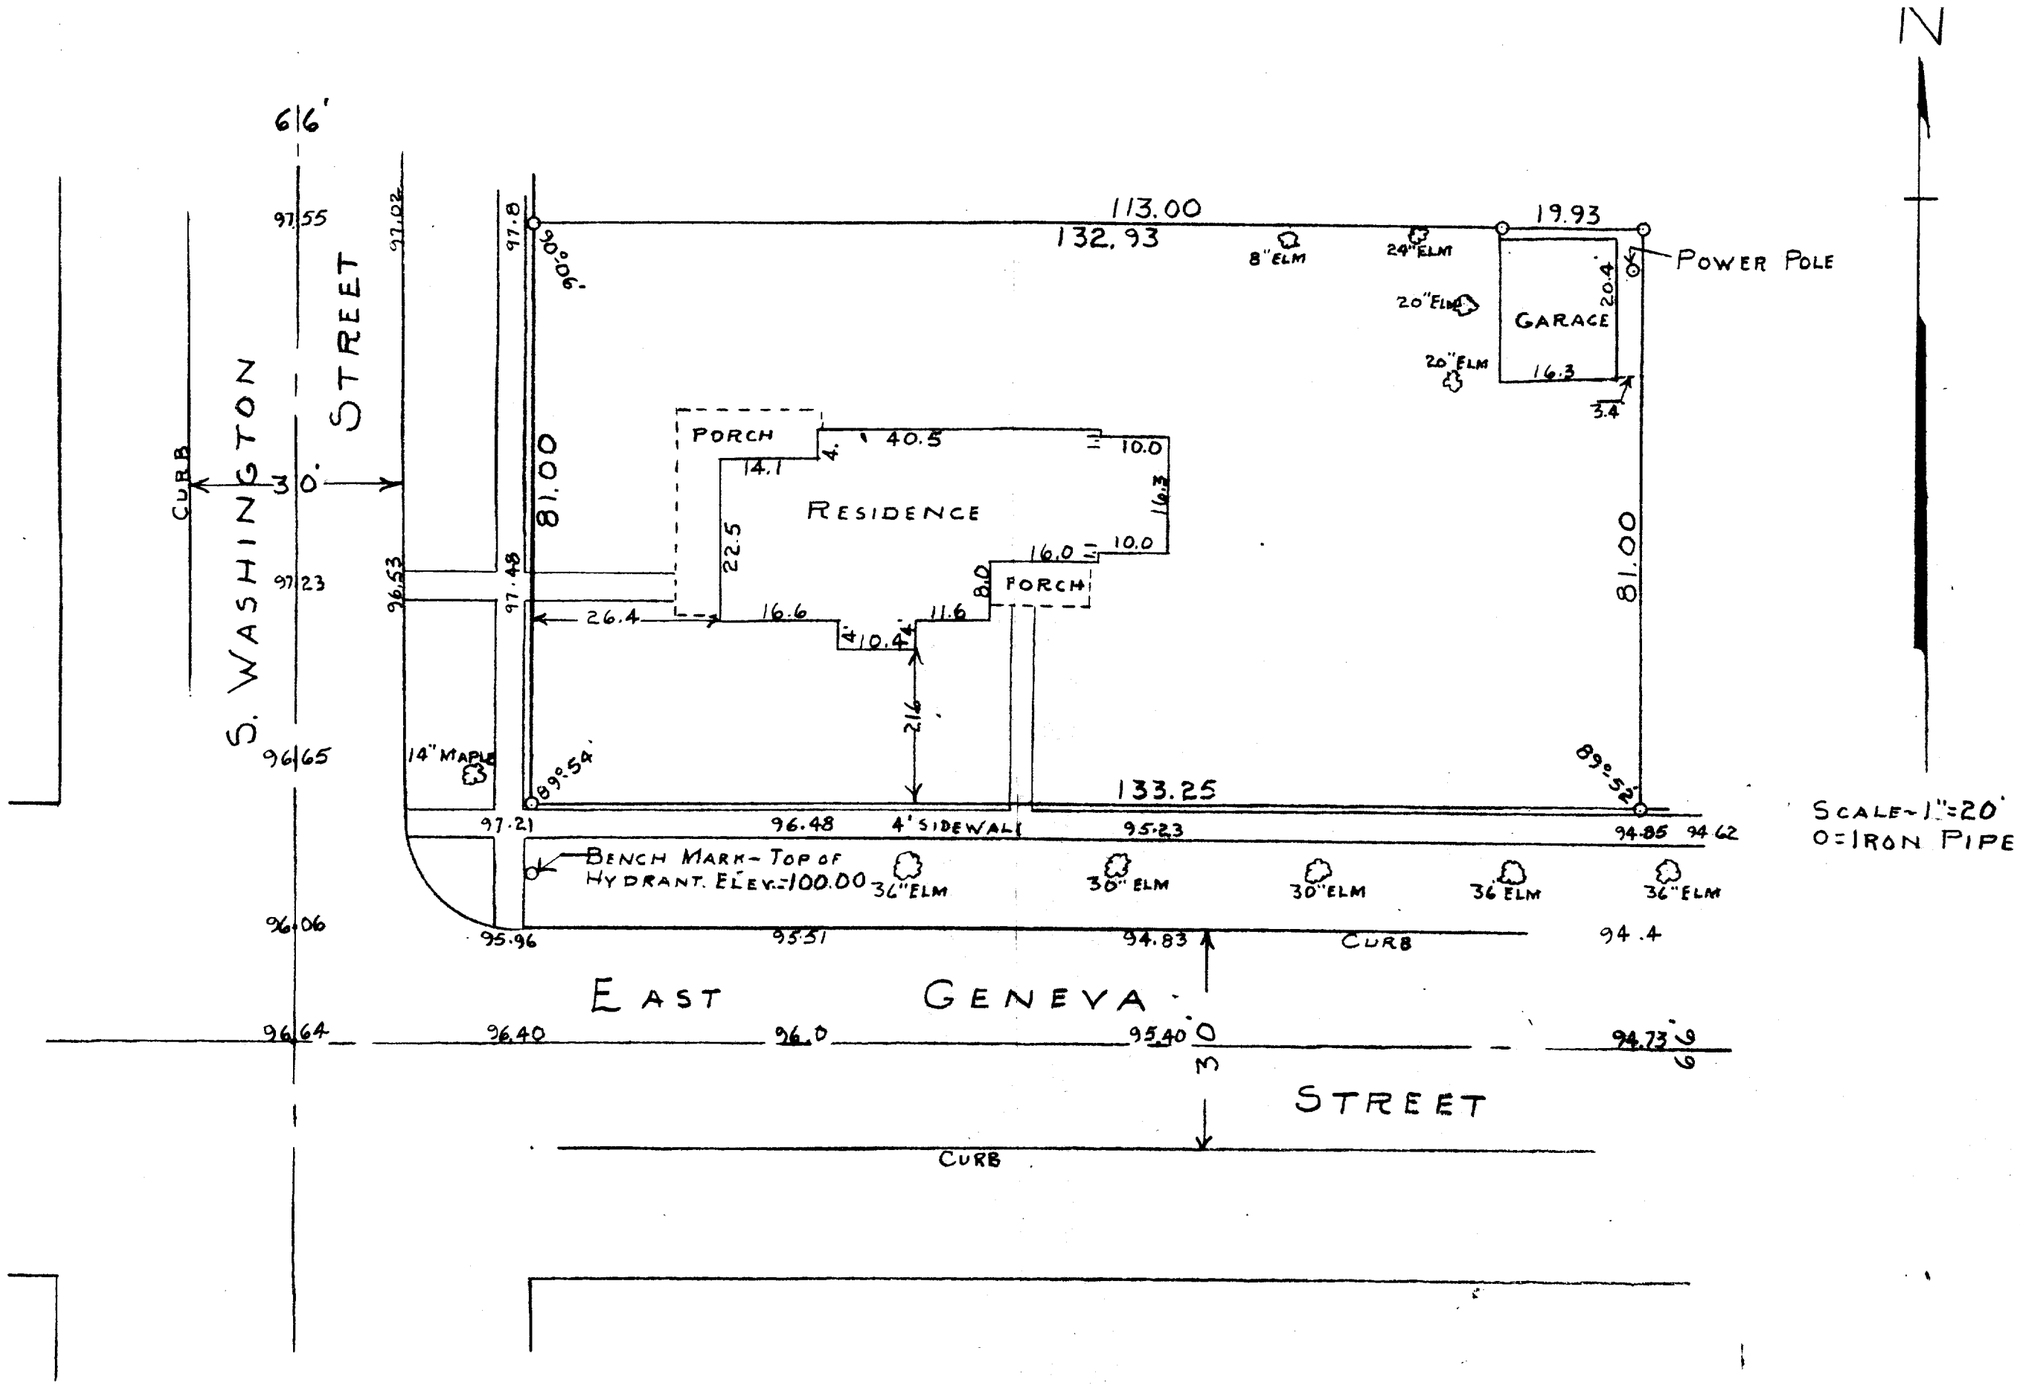

NOTE - ELEV. SHOWN ALONG CURB ARE AT FLOW LINE OF GUTTER.

OP- 191

PLAT OF SURVEY OF PART OF LOTS 7 AND 8, BLOCK 24 OF THE CITY OF ELKHORN, WALWORTH COUNTY, WISCONSIN
DECEMBER 14, 1956

George T. Dunham
GEORGE T. DUNHAM, SURVEYOR
DELAVAN, WISCONSIN

OP- 191

4-9