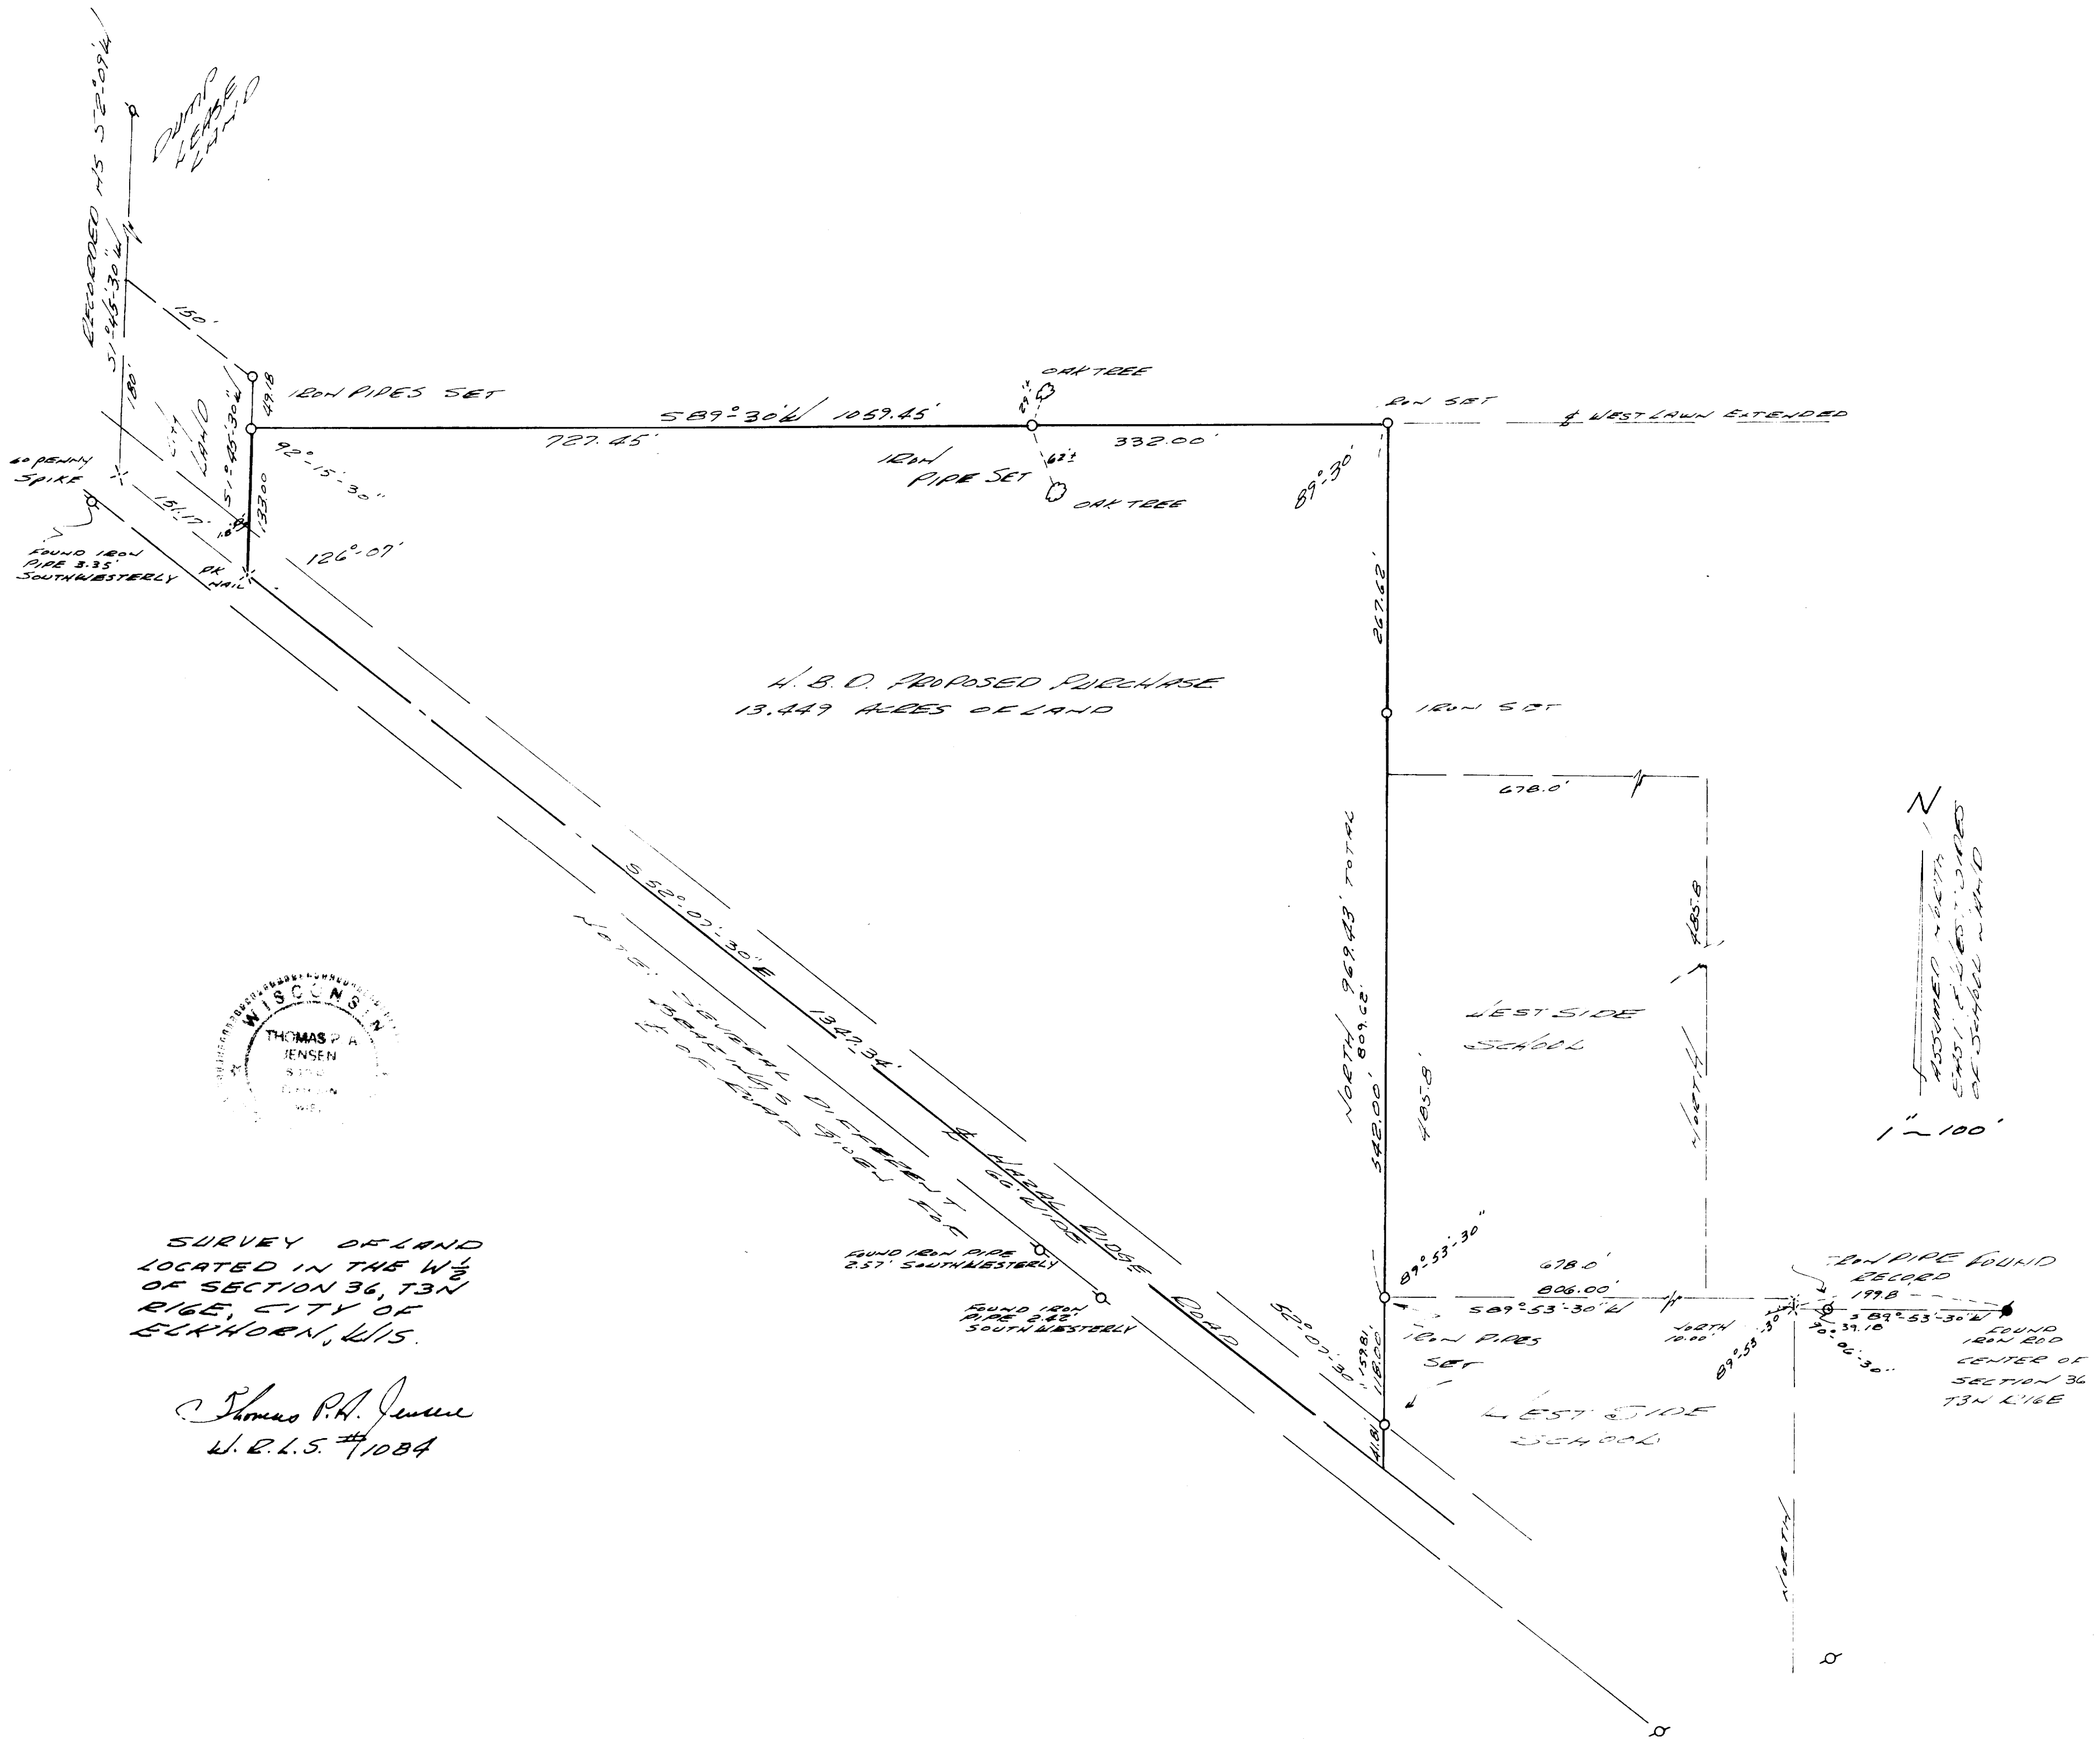

SURVEY OF LAND LOCATED IN THE W½ OF SECTION 36, T3N R16E, CITY OF ELKHORN, WIS.

Thomas P.A. Jensen
W.R.L.S. #1084

U-NW-58A

4-95 J