
#97-72

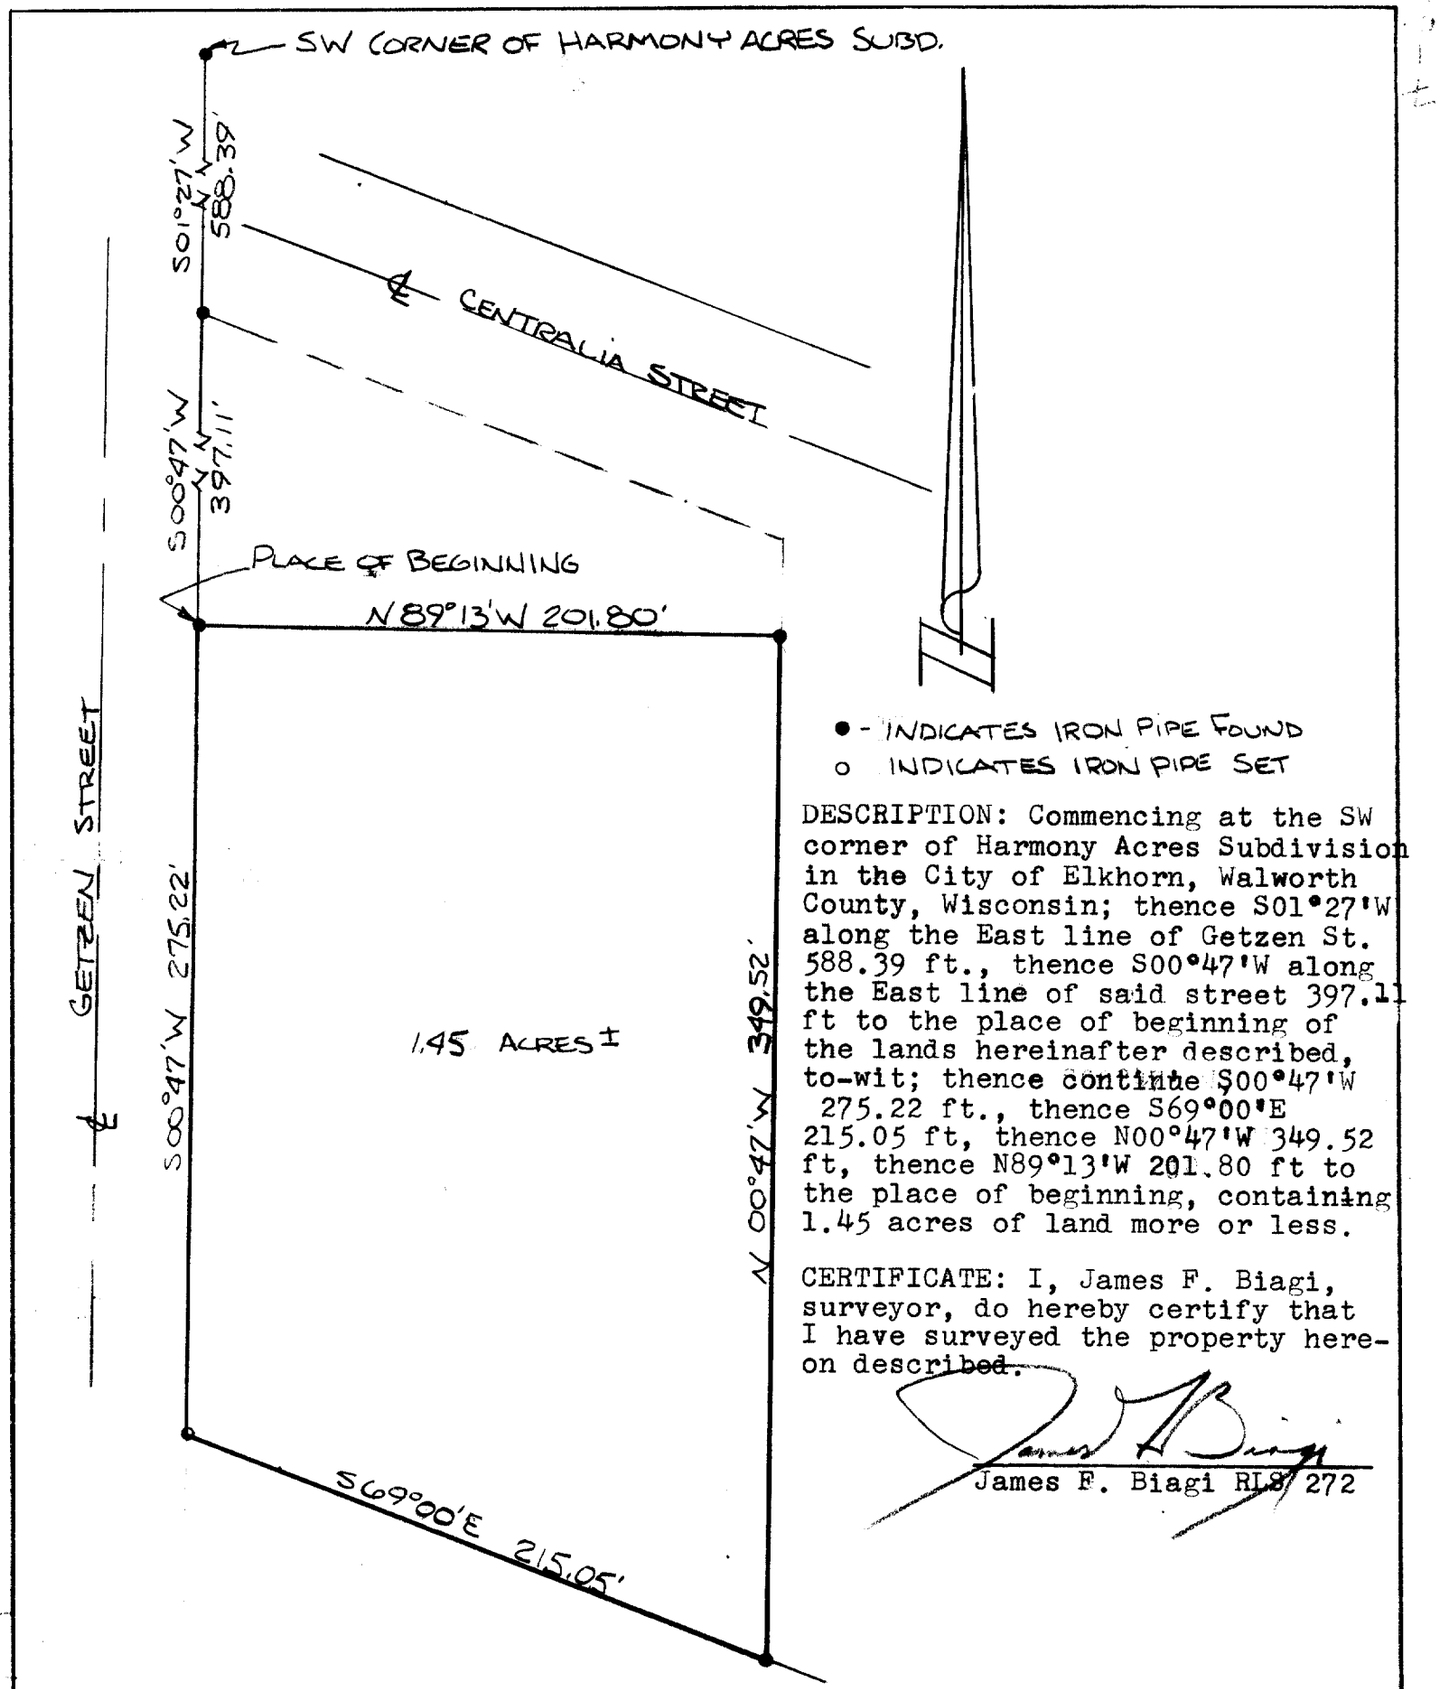

● - INDICATES IRON PIPE FOUND
o INDICATES IRON PIPE SET

DESCRIPTION: Commencing at the SW corner of Harmony Acres Subdivision in the City of Elkhorn, Walworth County, Wisconsin; thence S01°27'W along the East line of Getzen St. 588.39 ft., thence S00°47'W along the East line of said street 397.11 ft to the place of beginning of the lands hereinafter described, to-wit; thence continue S00°47'W 275.22 ft., thence S69°00'E 215.05 ft, thence N00°47'W 349.52 ft, thence N89°13'W 201.80 ft to the place of beginning, containing 1.45 acres of land more or less.

CERTIFICATE: I, James F. Biagi, surveyor, do hereby certify that I have surveyed the property hereon described.

James F. Biagi RLS 272

4-97B

V-SE-9F