Jensen Surveying & Mapping S.C.
45 S. Wisconsin St. P.O. Box 322
Elkhorn, Wisconsin. 53121
(414) 723-3434

TREE LOCATION

UNIT 3 of CLEAR SKY LODGE, a Condominium located in Government Lot 4, Section 18, T 1 N, R 17 E, Village of Fontana-on-Geneva Lake, Walworth County, Wisconsin

ORDERED BY: Scott Lowell
150 N. Walworth Av.
Williams Bay, WI
245-6868

Mapping Date: Nov. 2, 1989


N

Bearings referenced to Condominium Plat

Scale: 1" = 40'

LEGEND

- ○ Found iron pipe
- ● Found iron rod
- ( ) Recorded dimension
- Deciduous tree
  - W - Willow
  - O - Oak
  - M - Maple
  - E - Elm
  - B - Birch
  - L - Linden or Basswood
- ⊗ Manhole

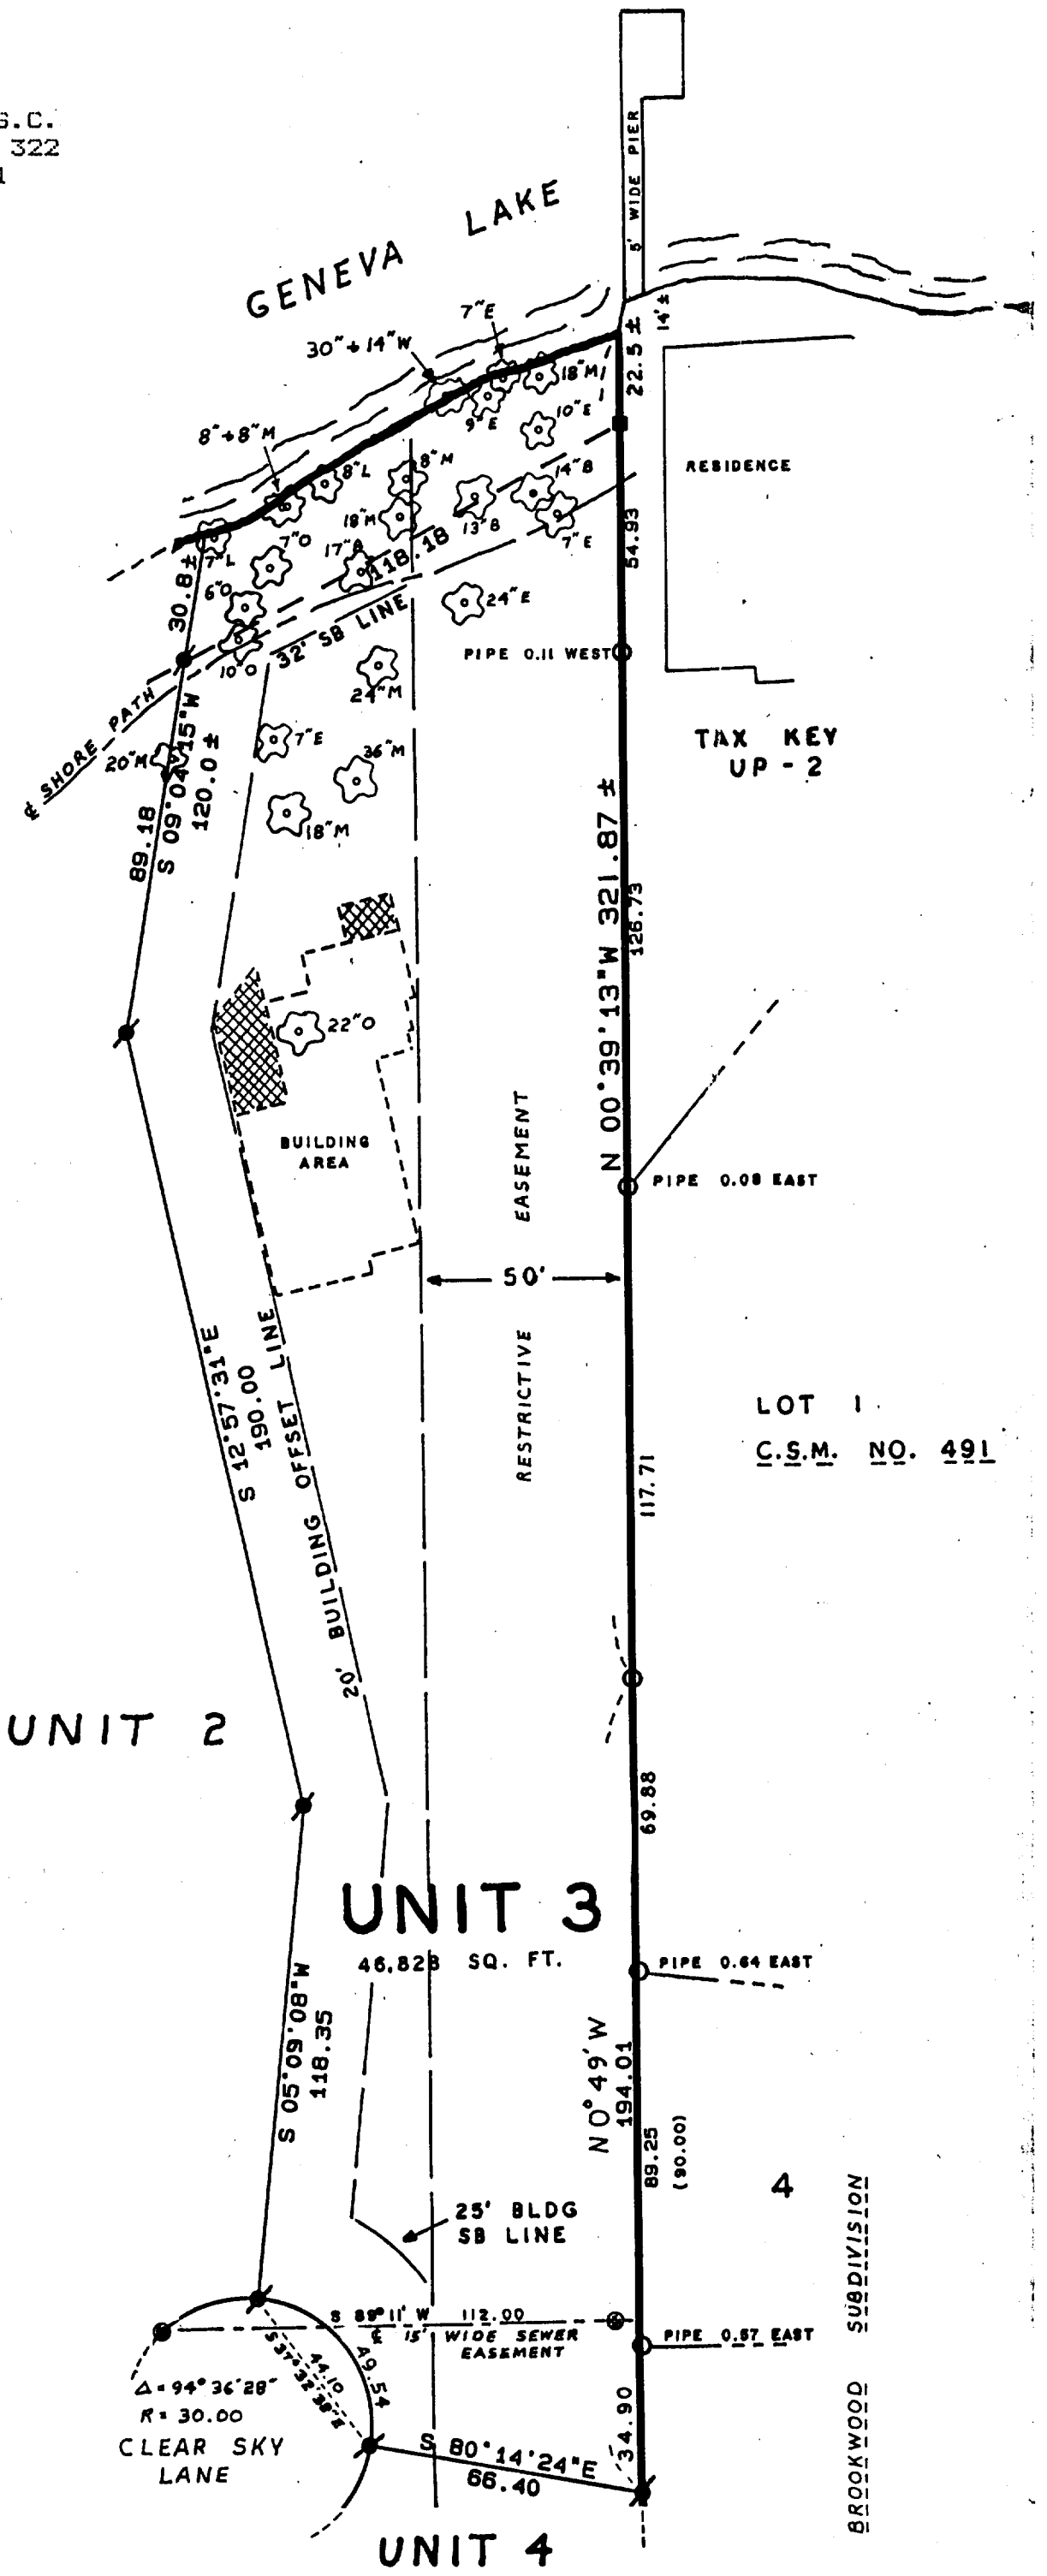

RECEIVED
JUL 16 1990

Copyright © 1989 by Jensen Surveying & Mapping S.C.

All rights reserved. No part of this survey plat may be reproduced or transmitted in any form by any means - graphic, electronic, or mechanical, including photocopying, tracing, or information storage and retrieval systems - without permission in writing from Thomas P.A. Jensen, Jensen Surveying & Mapping S.C.

Note: This survey plat is not certified unless signed and sealed in red ink.

TAX # SCL-3

1989.079

5-1020