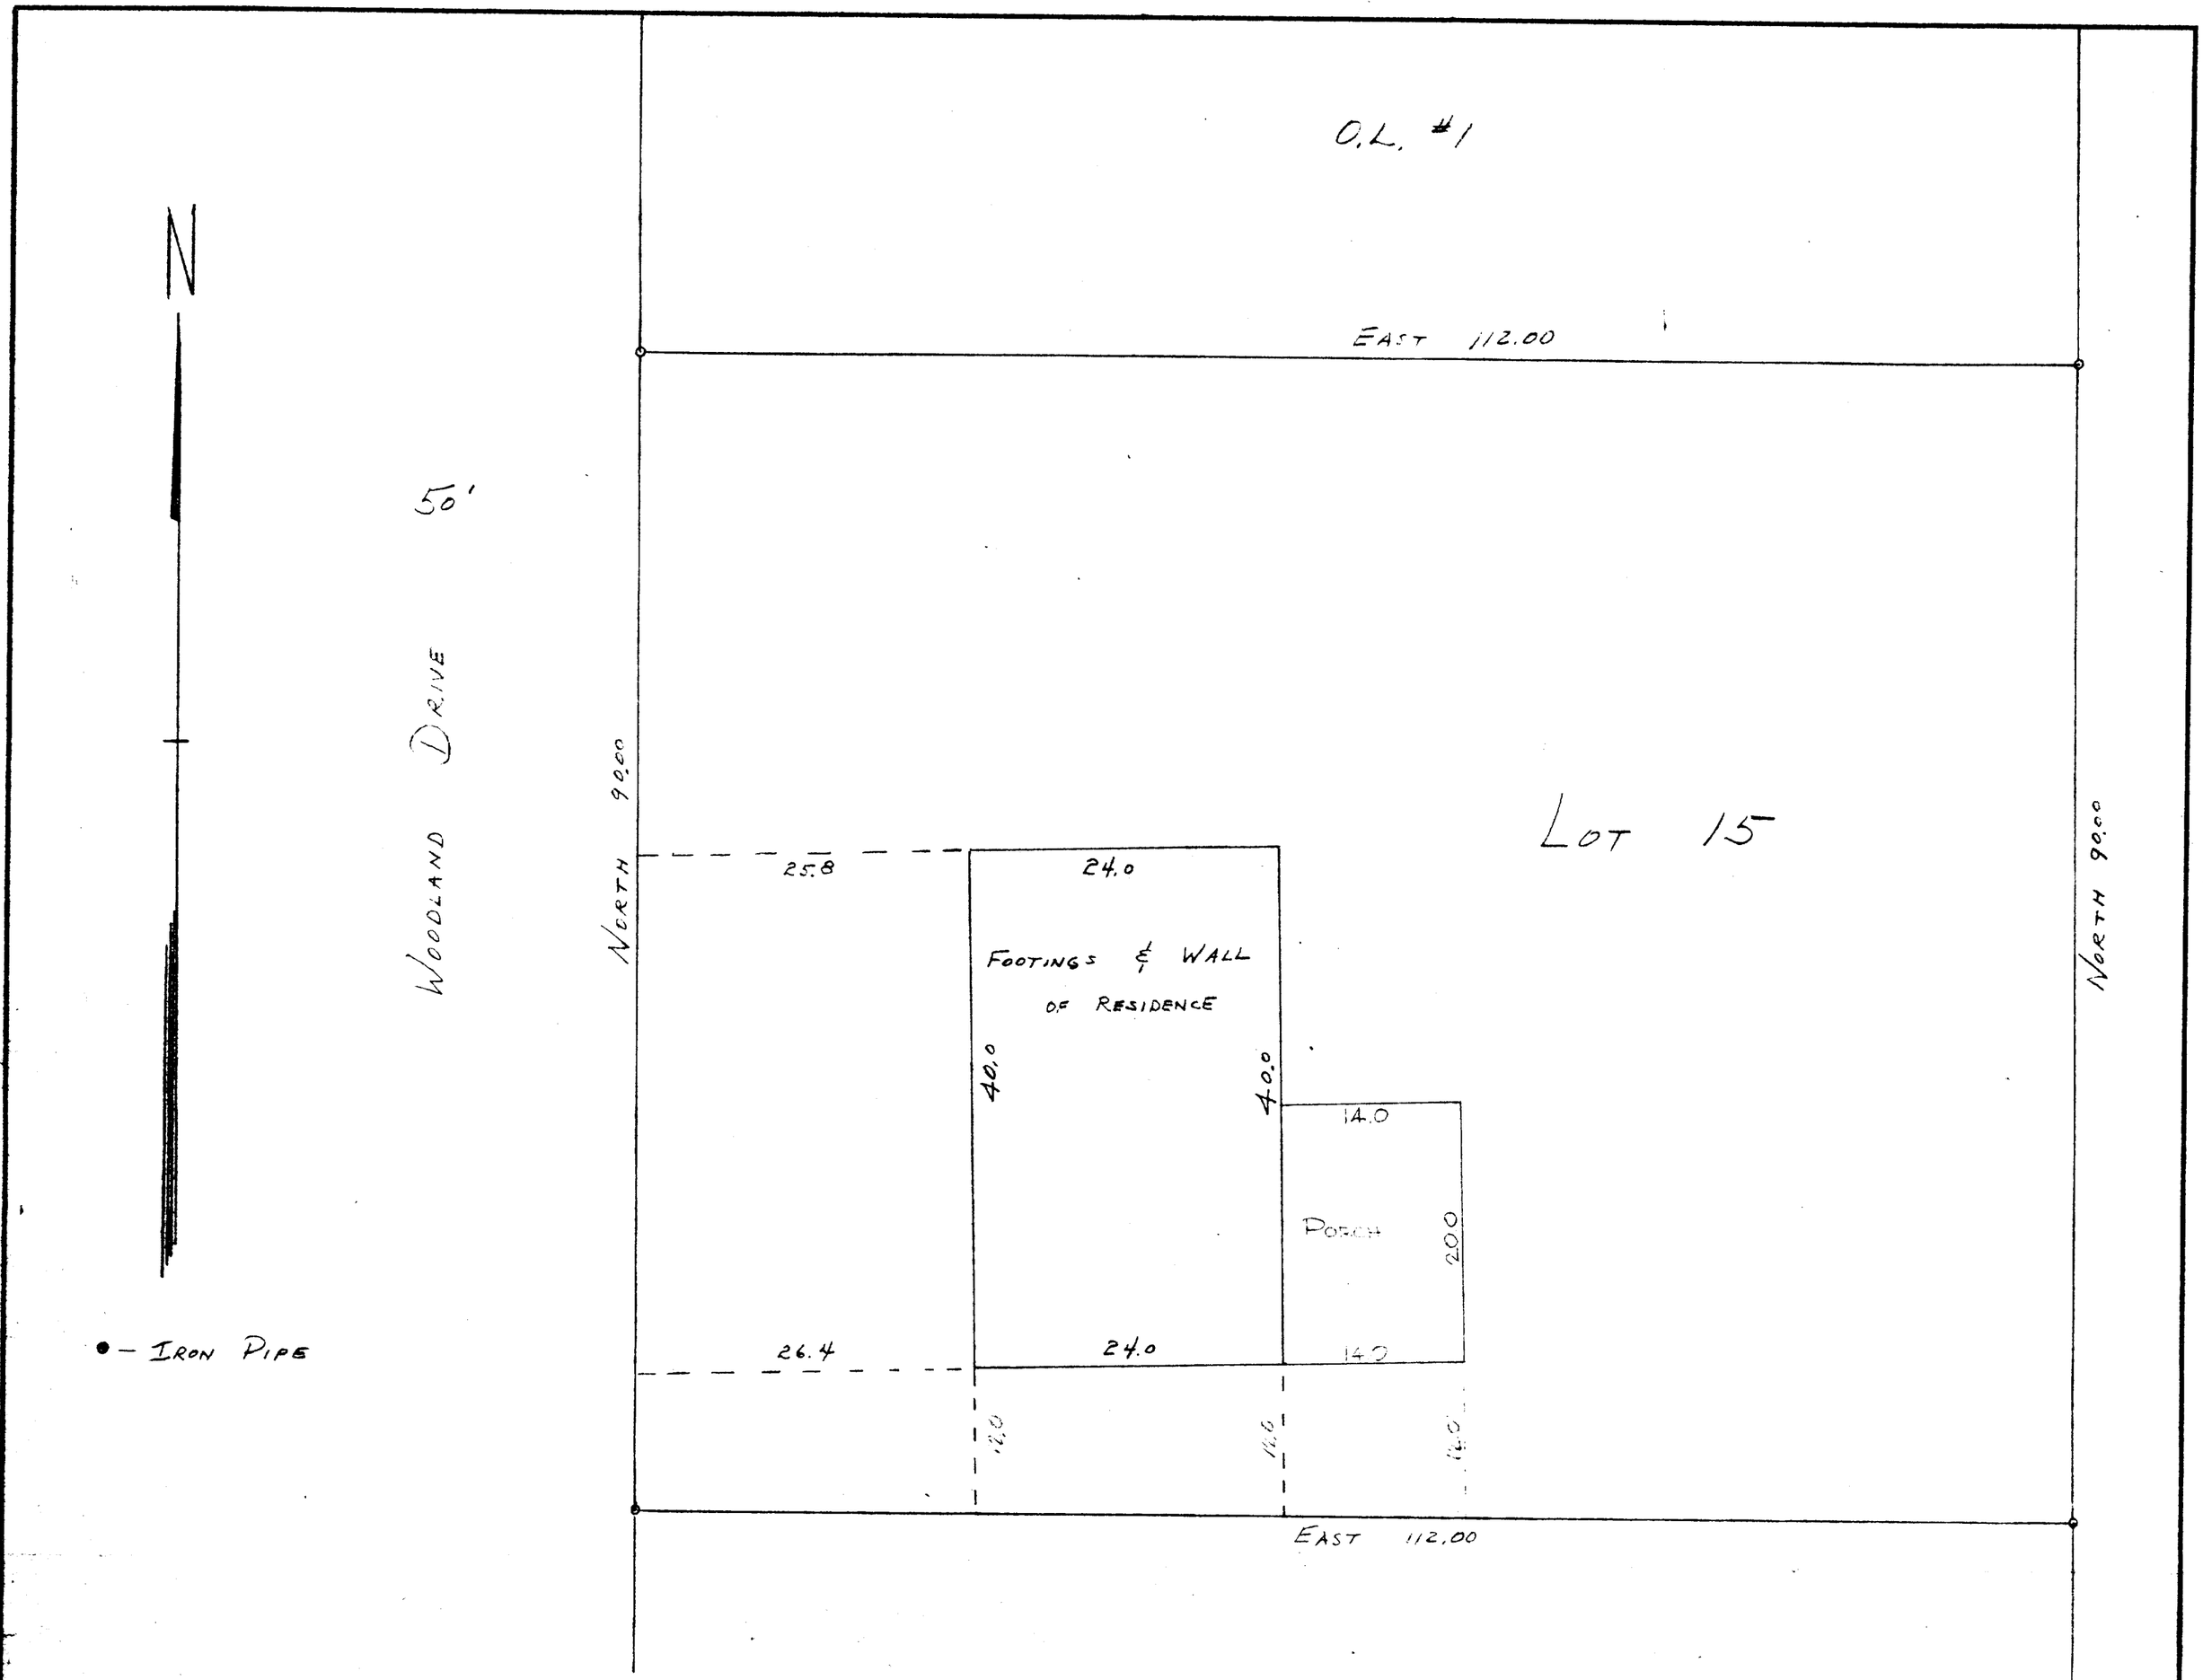


16

STATE OF WISCONSIN) SS
COUNTY OF WALWORTH)

I, LLOYD L. JENSEN, DO HEREBY CERTIFY THAT I HAVE SURVEYED THE PROPERTY DESCRIBED HEREON ACCORDING TO THE OFFICIAL RECORDS, AND THAT THE PLAT HEREON IS A CORRECT REPRESENTATION OF THE LOT LINES AND PRINCIPAL LINES OF BUILDINGS THEREON.

ELKHORN, WISCONSIN MAY 3, 1955

Lloyd L. Jensen
SURVEYOR

PLAT OF SURVEY
OF
LOT 15 OF ADDITION D
TO COUNTRY CLUB ESTATES
LOCATED IN THE
VILLAGE OF FONTANA-ON-GENEVA LAKE
WALWORTH COUNTY, WISCONSIN

Lloyd L. Jensen
SURVEYOR

SCALE 1" = 10'

DATE MAY 1955

SCTD-16

NO. 177H—400—3-10-53

5-103 J