


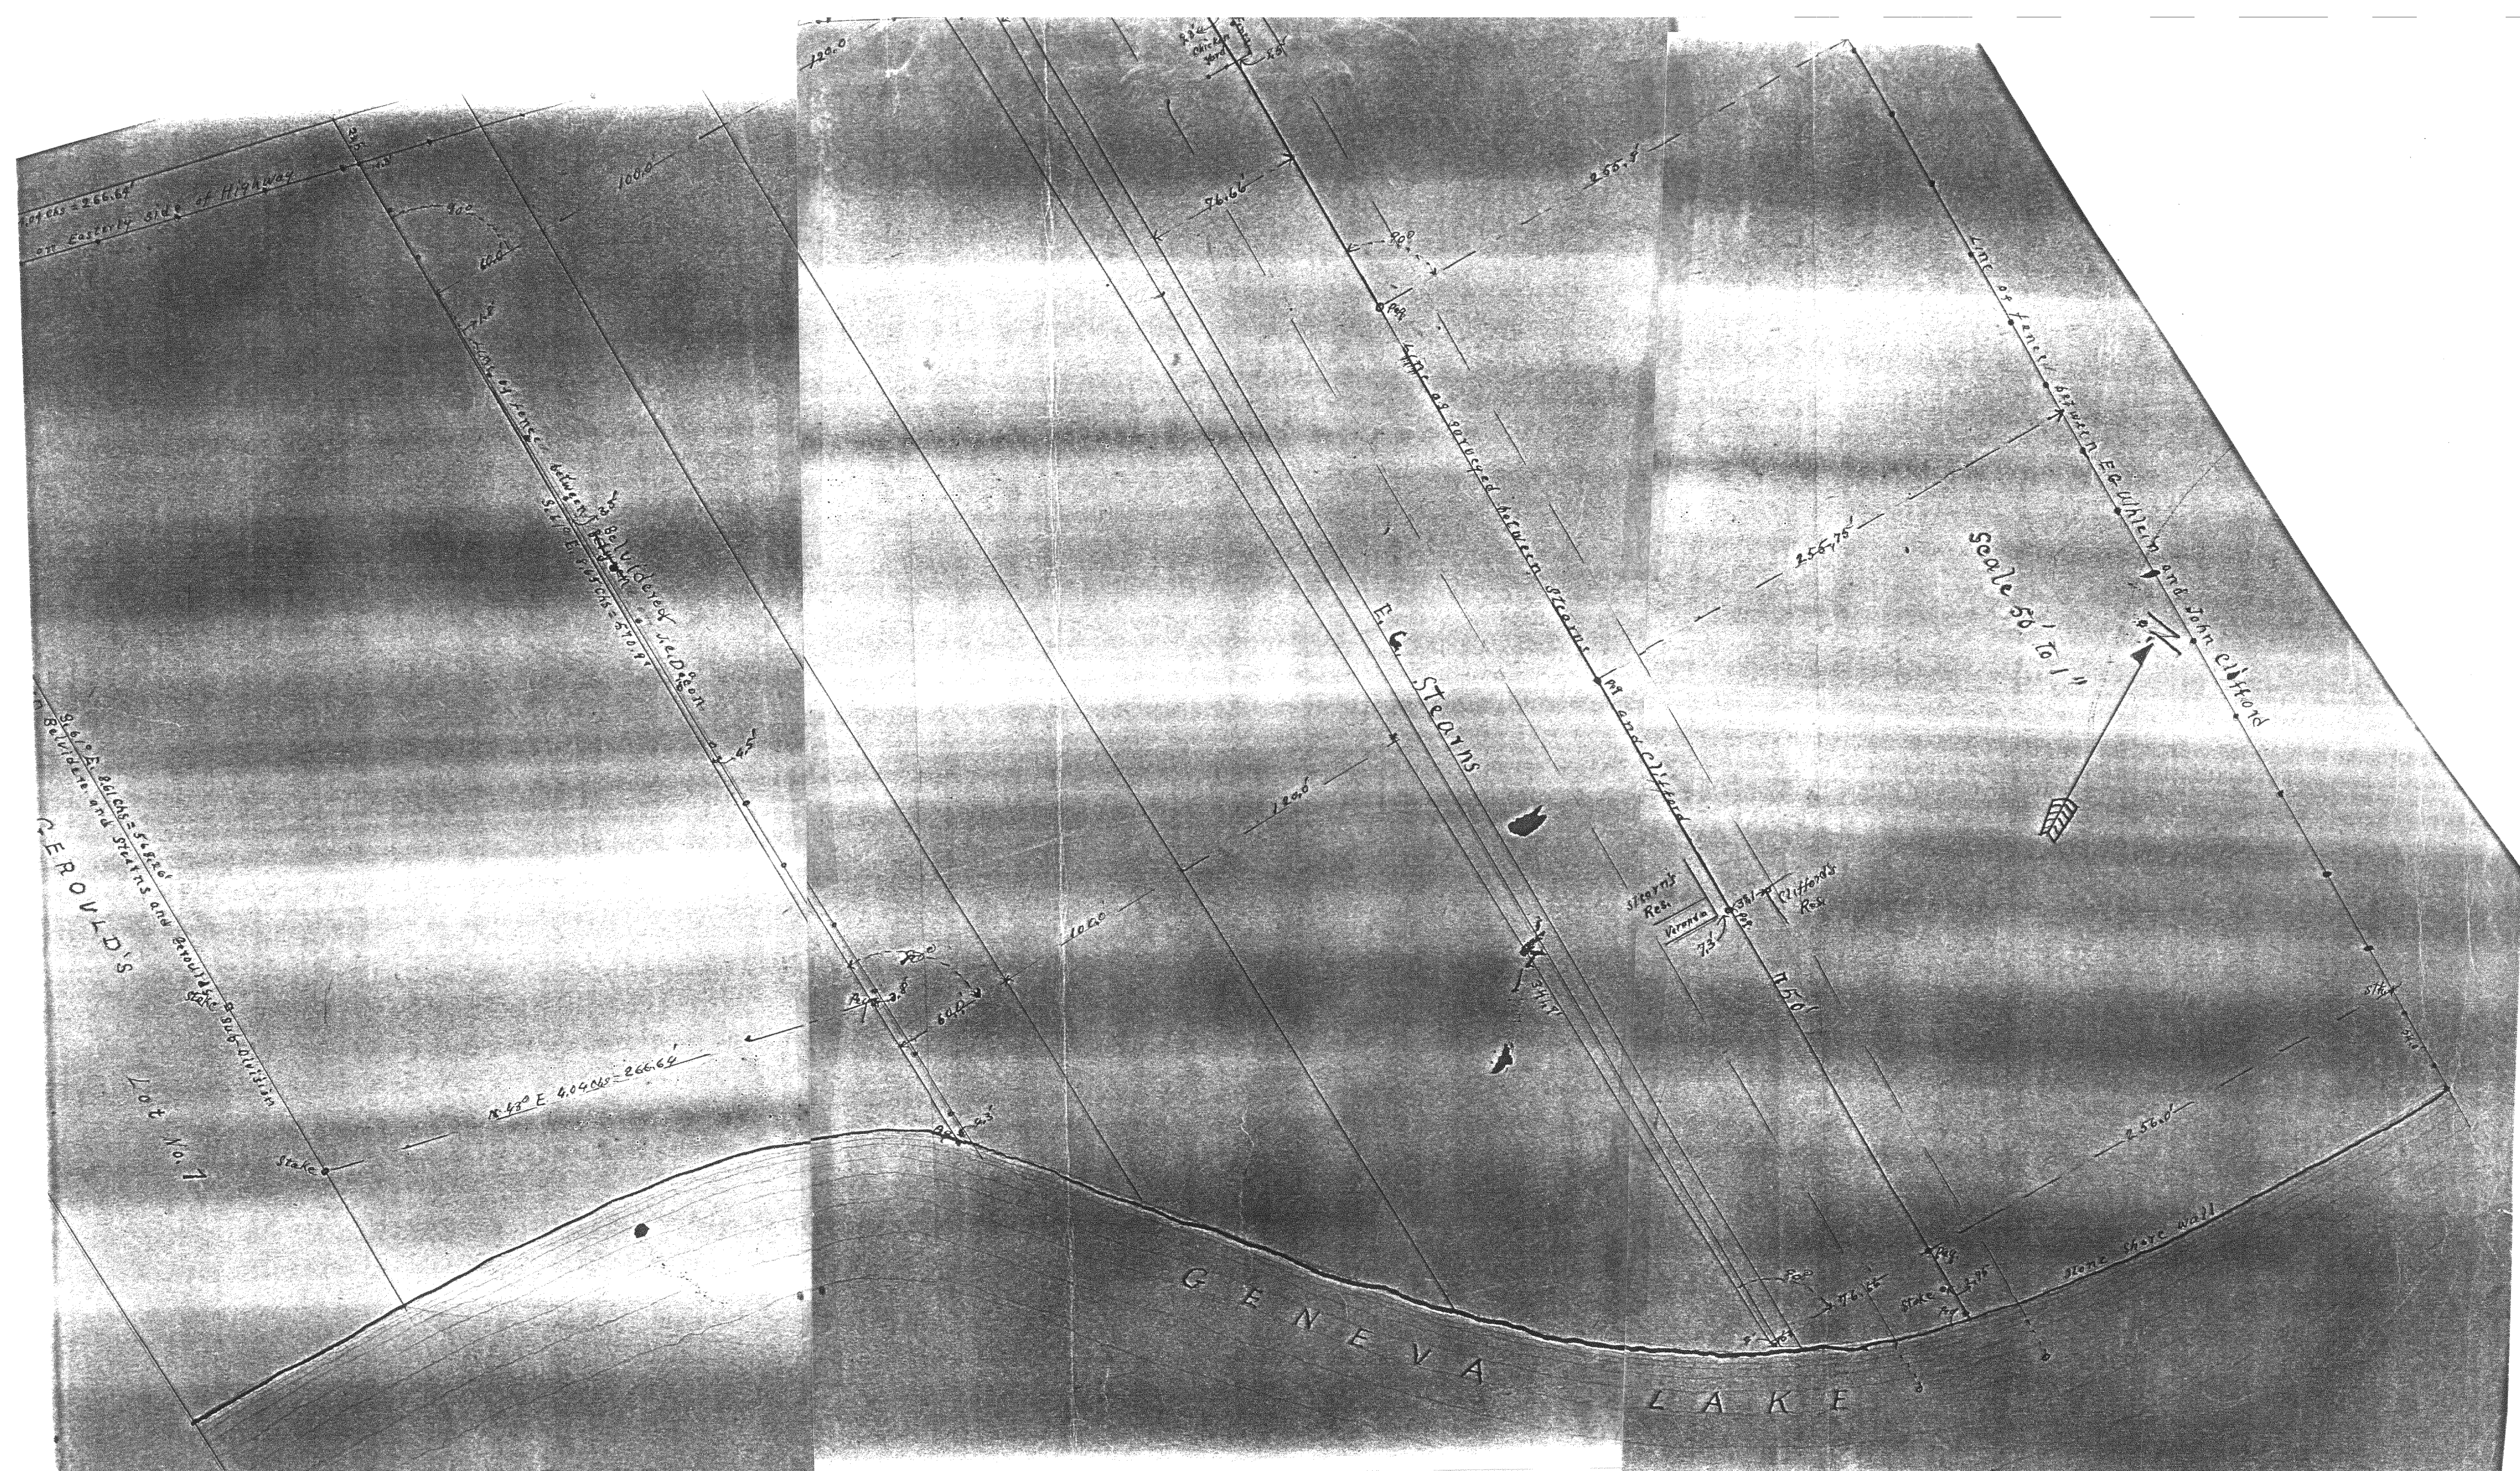

John Clifford



[illegible]



