'lat of Survey


of

THE EAST 47 FEET OF THE WEST 97 FEET OF LOT 4 IN BLOCK 2 OF D. A. REID'S ADDITION TO REID'S PARK IN THE VILLAGE OF FONTANA-ON-GENEVA LAKE WALWORTH COUNTY, WISCONSIN

Surveyed for: PIERCE TYRRELL
ROUTE 1, BOX 562A
FONTANA, WI 53125

Note: Proposed house to fit in footprint of existing house except in the northwest corner as noted on plat.

BEARINGS REFERENCED TO THE NORTH LINE OF BAYVIEW AVENUE ASSUMED AS N89^48'00"W TO MATCH EXISTING SURVEY RECORDS

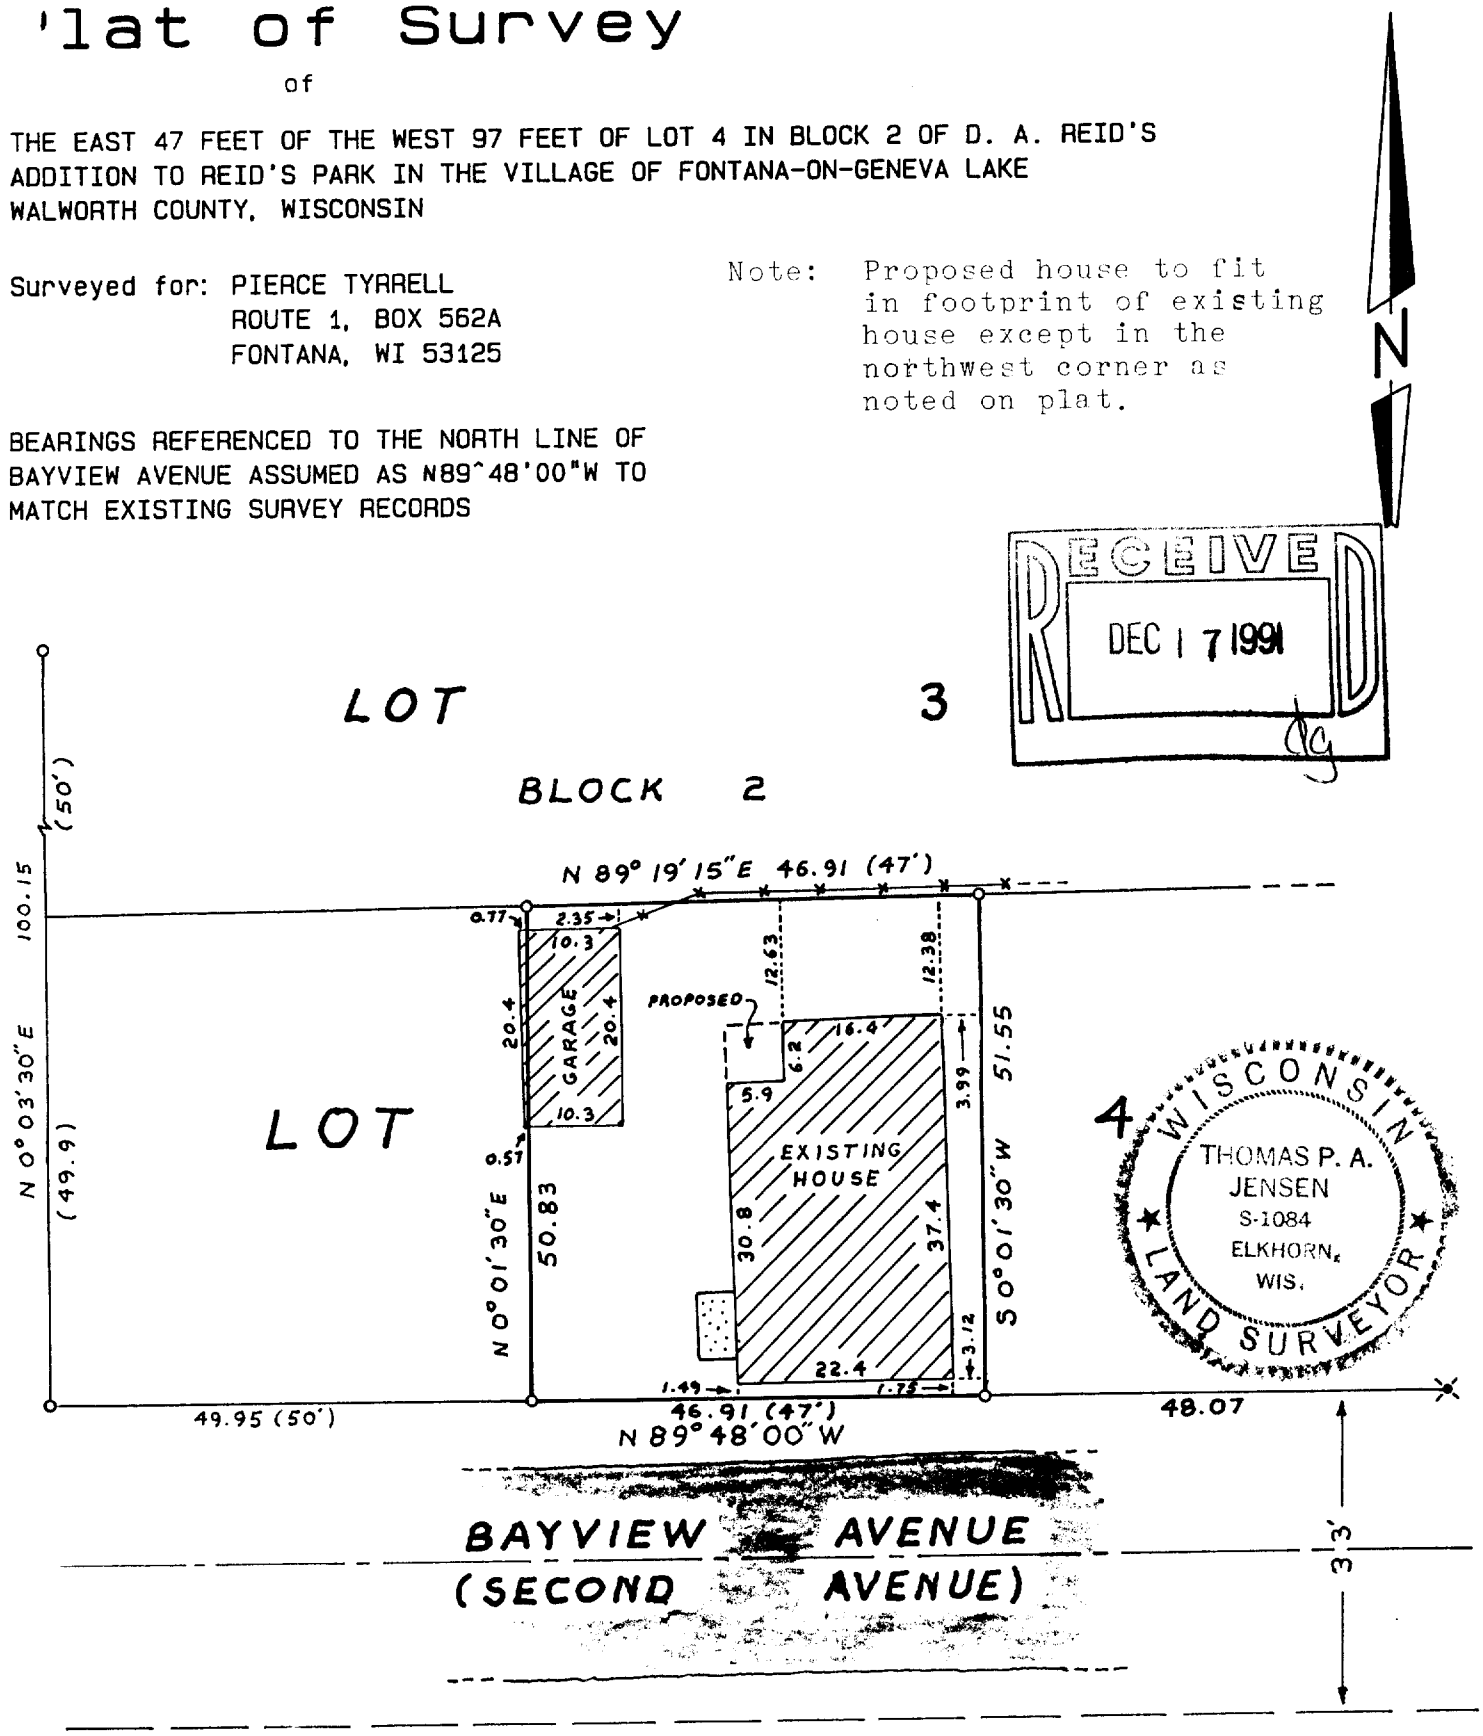

Copyright © 1990 by Jensen Surveying & Mapping S.C.
All rights reserved. No part of this survey plat may be reproduced or transmitted in any form by any means - graphic, electronic, or mechanical, including photocopying, tracing, or information storage and retrieval systems - without permission in writing from Thomas P.A. Jensen.

I, Thomas P.A. Jensen, Wisconsin Registered Land Surveyor, do hereby certify that this survey was performed by me, or under my direction, in full compliance with the owner's/agent's instructions and Chapter A-E 7 of the Wisconsin Administrative Code ' Minimum Standards For Property Surveys ', and that this map is an accurate representation thereof to the best of my knowledge and belief.

Note: This survey plat is not certified unless signed and sealed in red ink.

Thomas P.A. Jensen R.L.S. 1084

Legend

- o Found iron pipe
- X Found spike
- -x-x- Fence - Wood
- ( ) Recorded as dimension
- Blactop
- Concrete Surface

005-1133

Jensen Surveying & Mapping S.C.
45 South Wisconsin Street P.O. Box 322
Elkhorn, Wisconsin. 53121.
(414) 723-3434

Scale: 1 = 20'

0 10 20 40 60

Mapping date: OCTOBER 22, 1990
Revisions: _____
_____

Sheet 1 of 1 Sheets


Job reference number:
1990.157 A X
SRA 00012

lat of Survey

of the following described real estate, to-wit: Commencing at a point in the South line of Second Avenue where the same is intersected by the East line of Bigfoot Street produced Southerly in Dorliska A. Reid's Addition to Reid's Park, being a subdivision of Section 14, Township 1, North, Range 18 East, in the Village of Fontana on Lake Geneva; thence East on the South line of said Second Avenue 45 feet for a place of beginning; thence South on a line parallel with the South line of said Bigfoot Street produced Southerly 74 feet; thence East parallel with the South line of said Second Avenue 45 feet; thence North parallel with the aforesaid South line of Bigfoot Street 74 feet to the South line of said Second Avenue; thence West along the South line of said Second Avenue to the Place of Beginning, all of the above situated in the Village of Fontana (now Fontana on Geneva Lake), in the County of Walworth and State of Wisconsin.

Surveyed for: PIERCE TYRRELL
ROUTE 1, BOX 562A
FONTANA, WI 53125

Note: See attached surveyor's report.

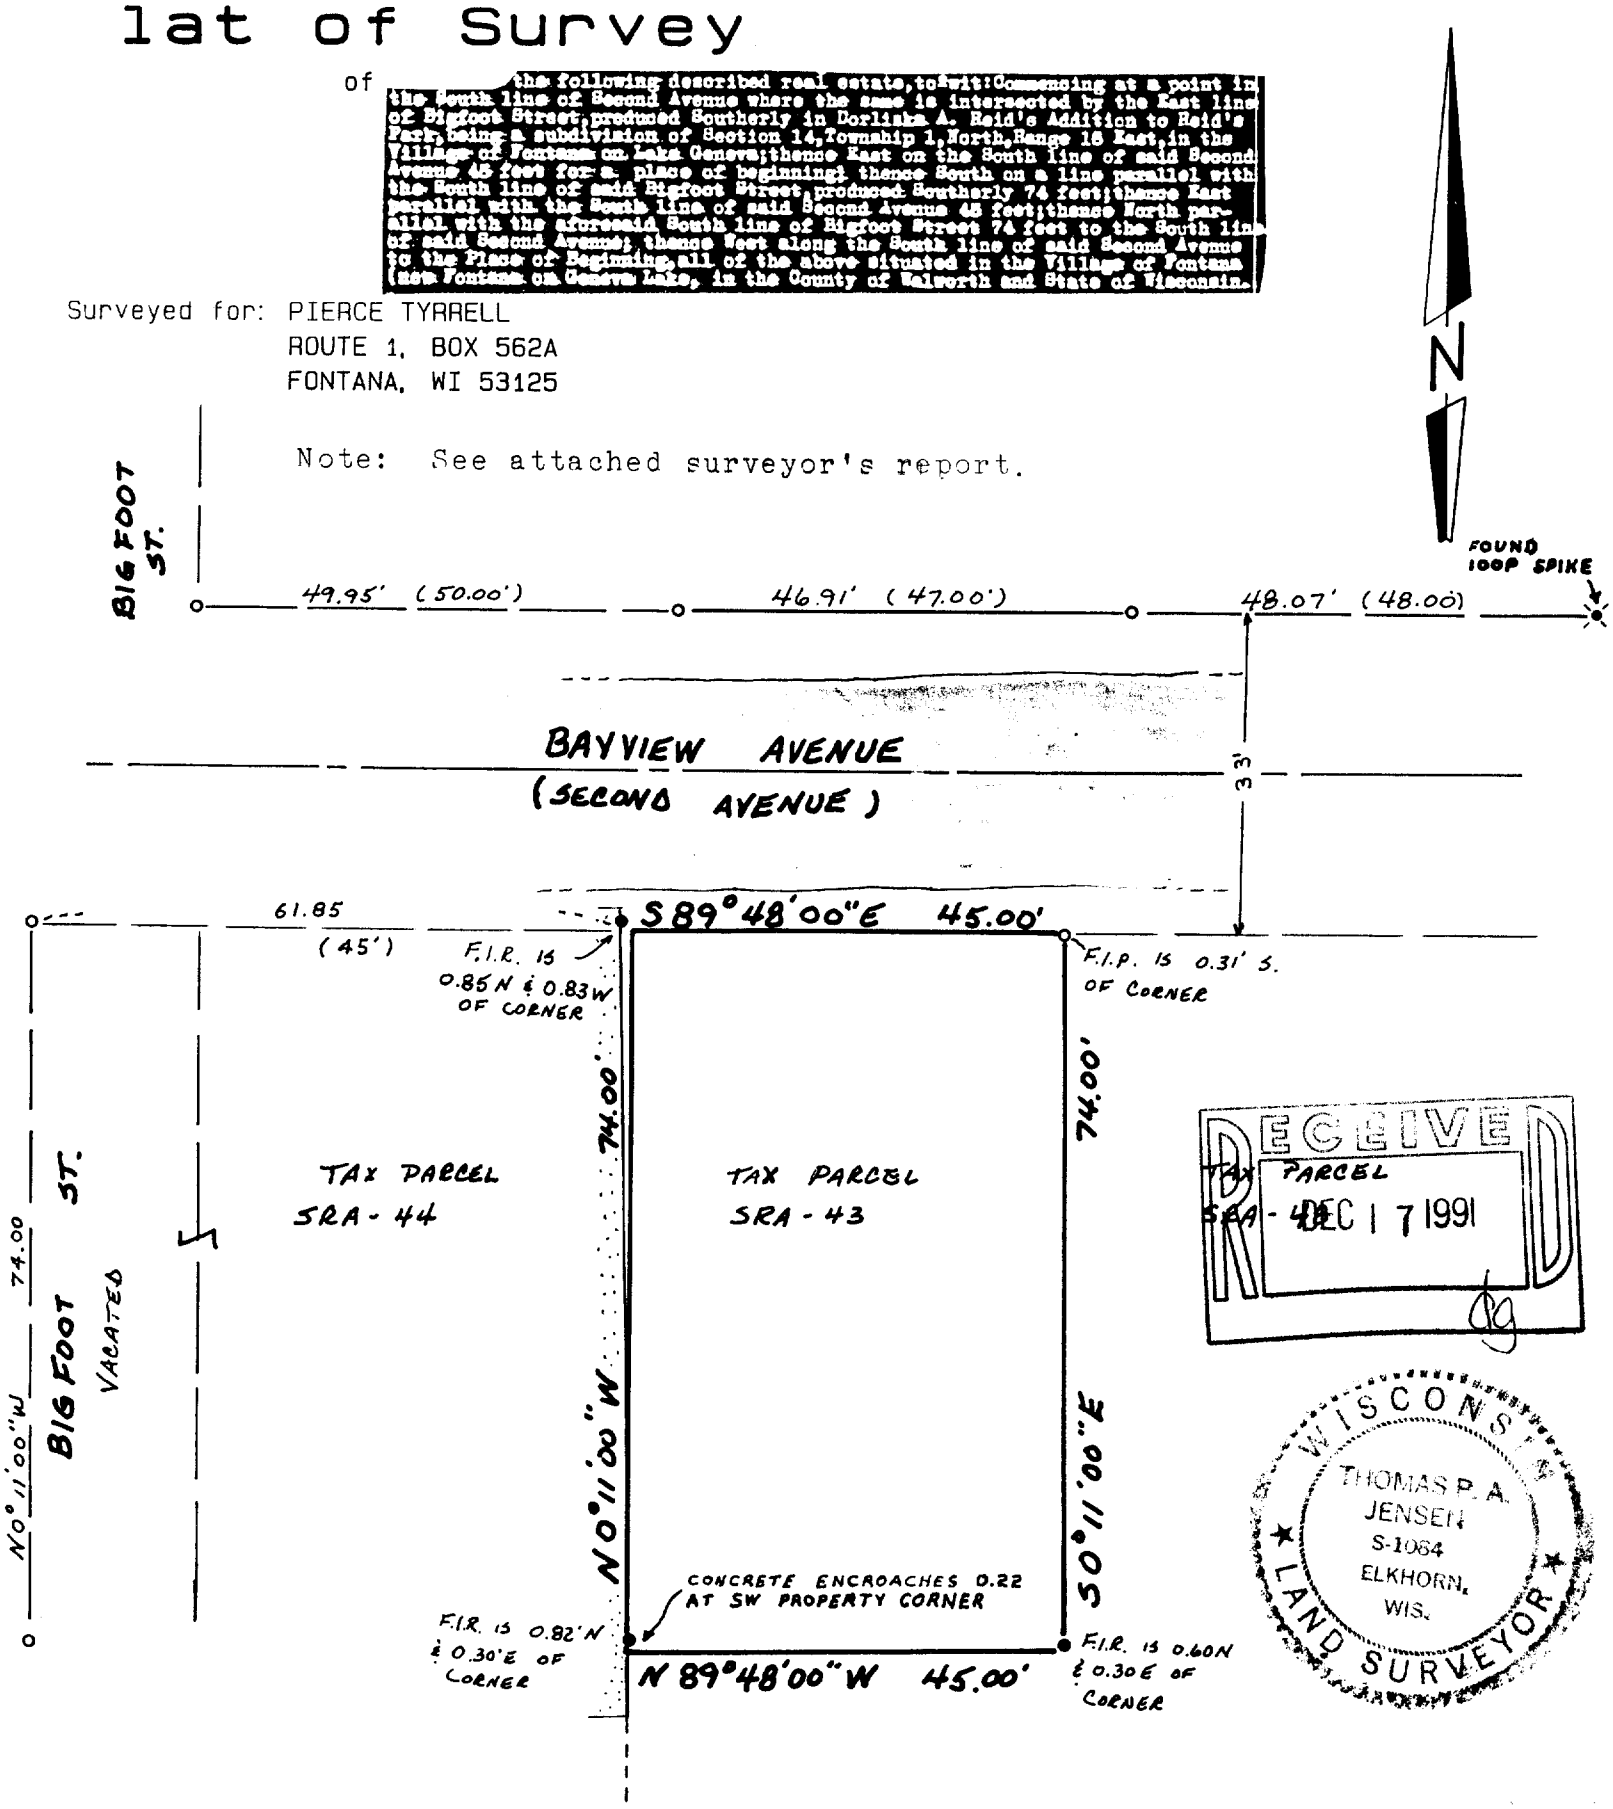

RECEIVED
DEC 17 1991

WISCONSIN
THOMAS P.A. JENSEN
S-1064
ELKHORN, WIS.
LAND SURVEYOR

Copyright © 1990 by Jensen Surveying & Mapping S.C.
All rights reserved. No part of this survey plat may be reproduced or transmitted in any form by any means - graphic, electronic, or mechanical, including photocopying, tracing, or information storage and retrieval systems - without permission in writing from Thomas P.A. Jensen.

I, Thomas P.A. Jensen, Wisconsin Registered Land Surveyor, do hereby certify that this survey was performed by me, or under my direction, in full compliance with the owner's/agent's instructions and Chapter A-E 7 of the Wisconsin Administrative Code ' Minimum Standards For Property Surveys ', and that this map is an accurate representation thereof to the best of my knowledge and belief.

Note: This survey plat is not certified unless signed and sealed in red ink.

Thomas P.A. Jensen R.L.S. 1084

Legend
- ○ Found iron pipe
- ● Found iron rod
- Concrete surface
- Blacktop surface

Jensen Surveying & Mapping S.C.
45 South Wisconsin Street P.O. Box 322
Elkhorn, Wisconsin. 53121.
(414) 723-3434

Scale: 1 = 20'

0 10 20 40 60

Mapping date: OCTOBER 22, 1990
Revisions: _____

Sheet 1 of 1 Sheets

Job reference number:
1990.157B