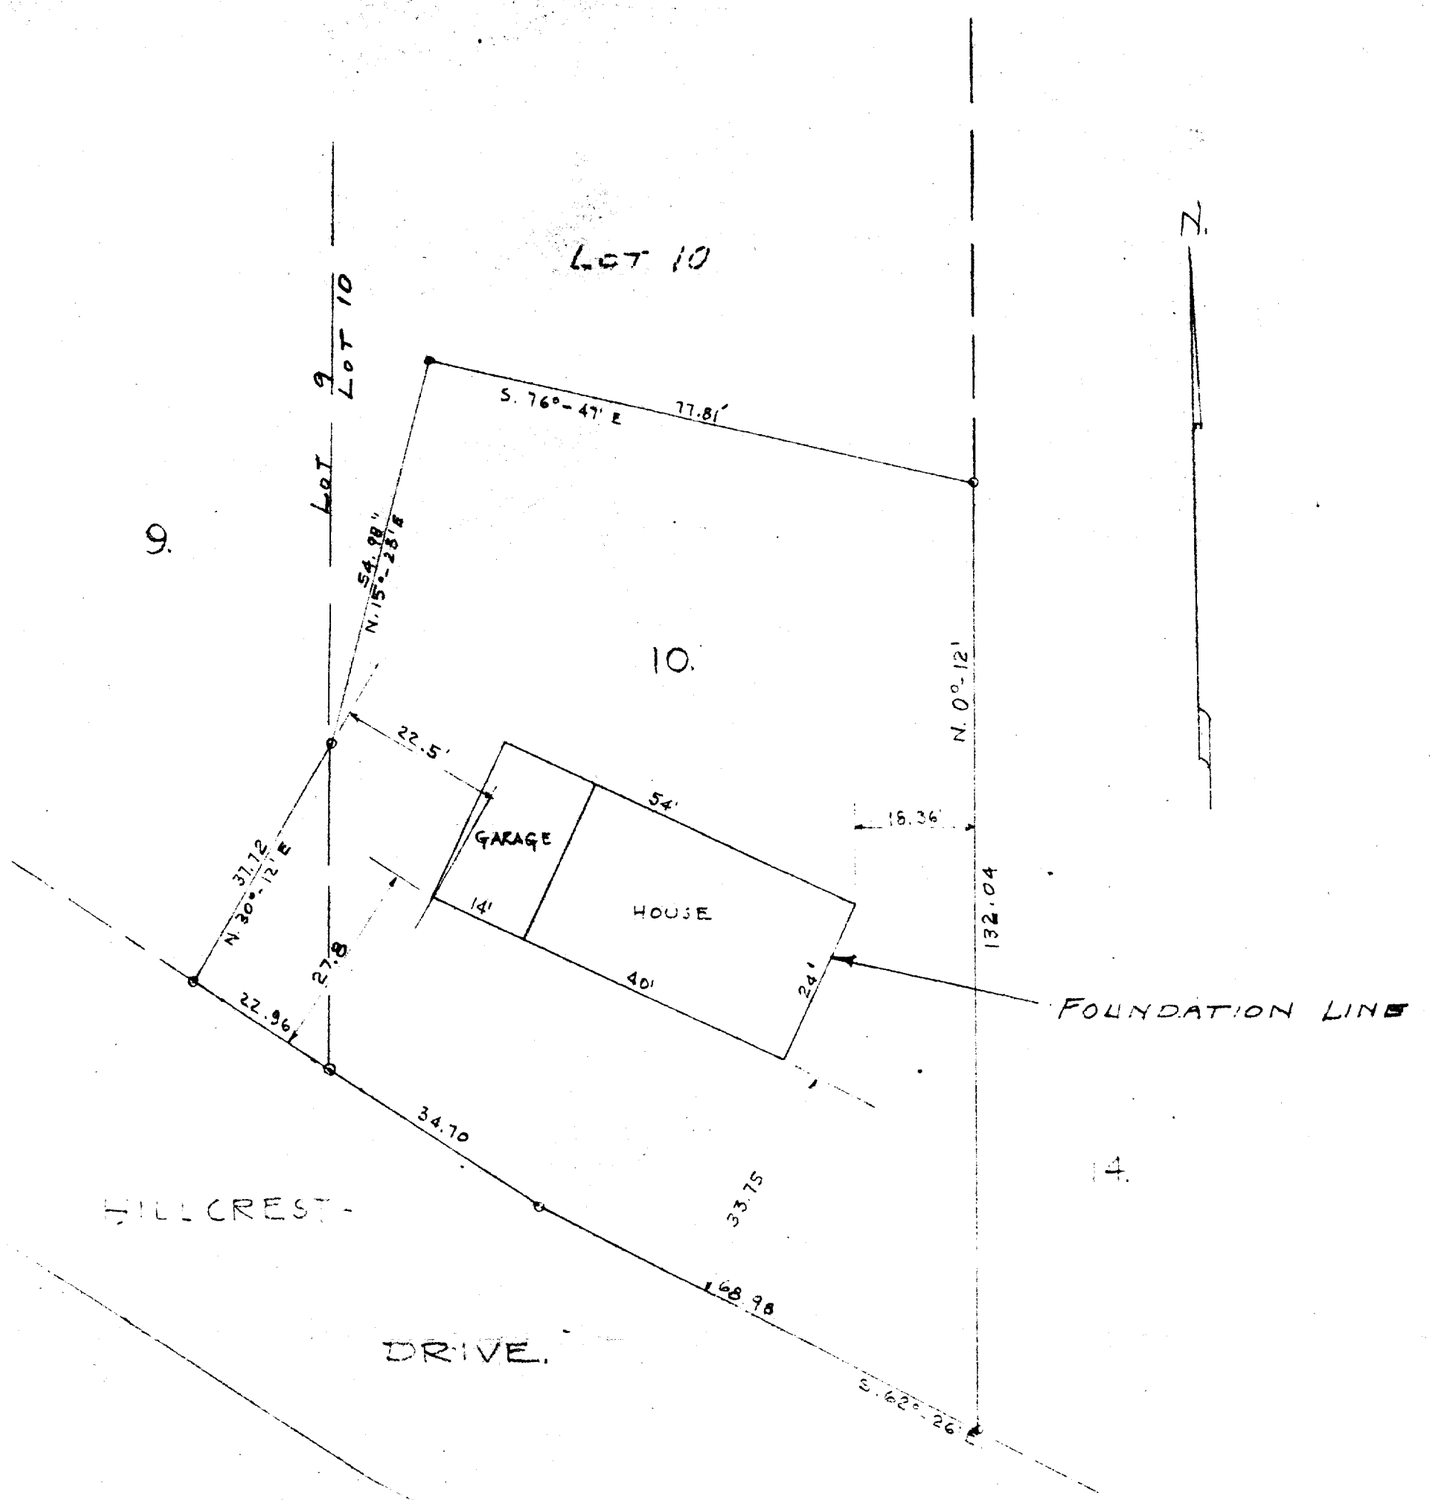


WISCONSIN
LLOYD L. JENSEN
S-211
ELKHORN, WIS.
LAND SURVEYOR

PLAT OF SURVEY

OF

PART OF LOT 9 AND
LOT 10 OF ADDITION "D"
TO COUNTRY CLUB ESTATES
LOCATED IN THE
VILLAGE OF FONTANA ON GENEVA LAKE
WALWORTH COUNTY, WIS.

Lloyd L. Jensen
SURVEYOR

SCALE 1" - 20

DATE 11-1-56.

J.H.W

SEC 17-11

5-114 J.