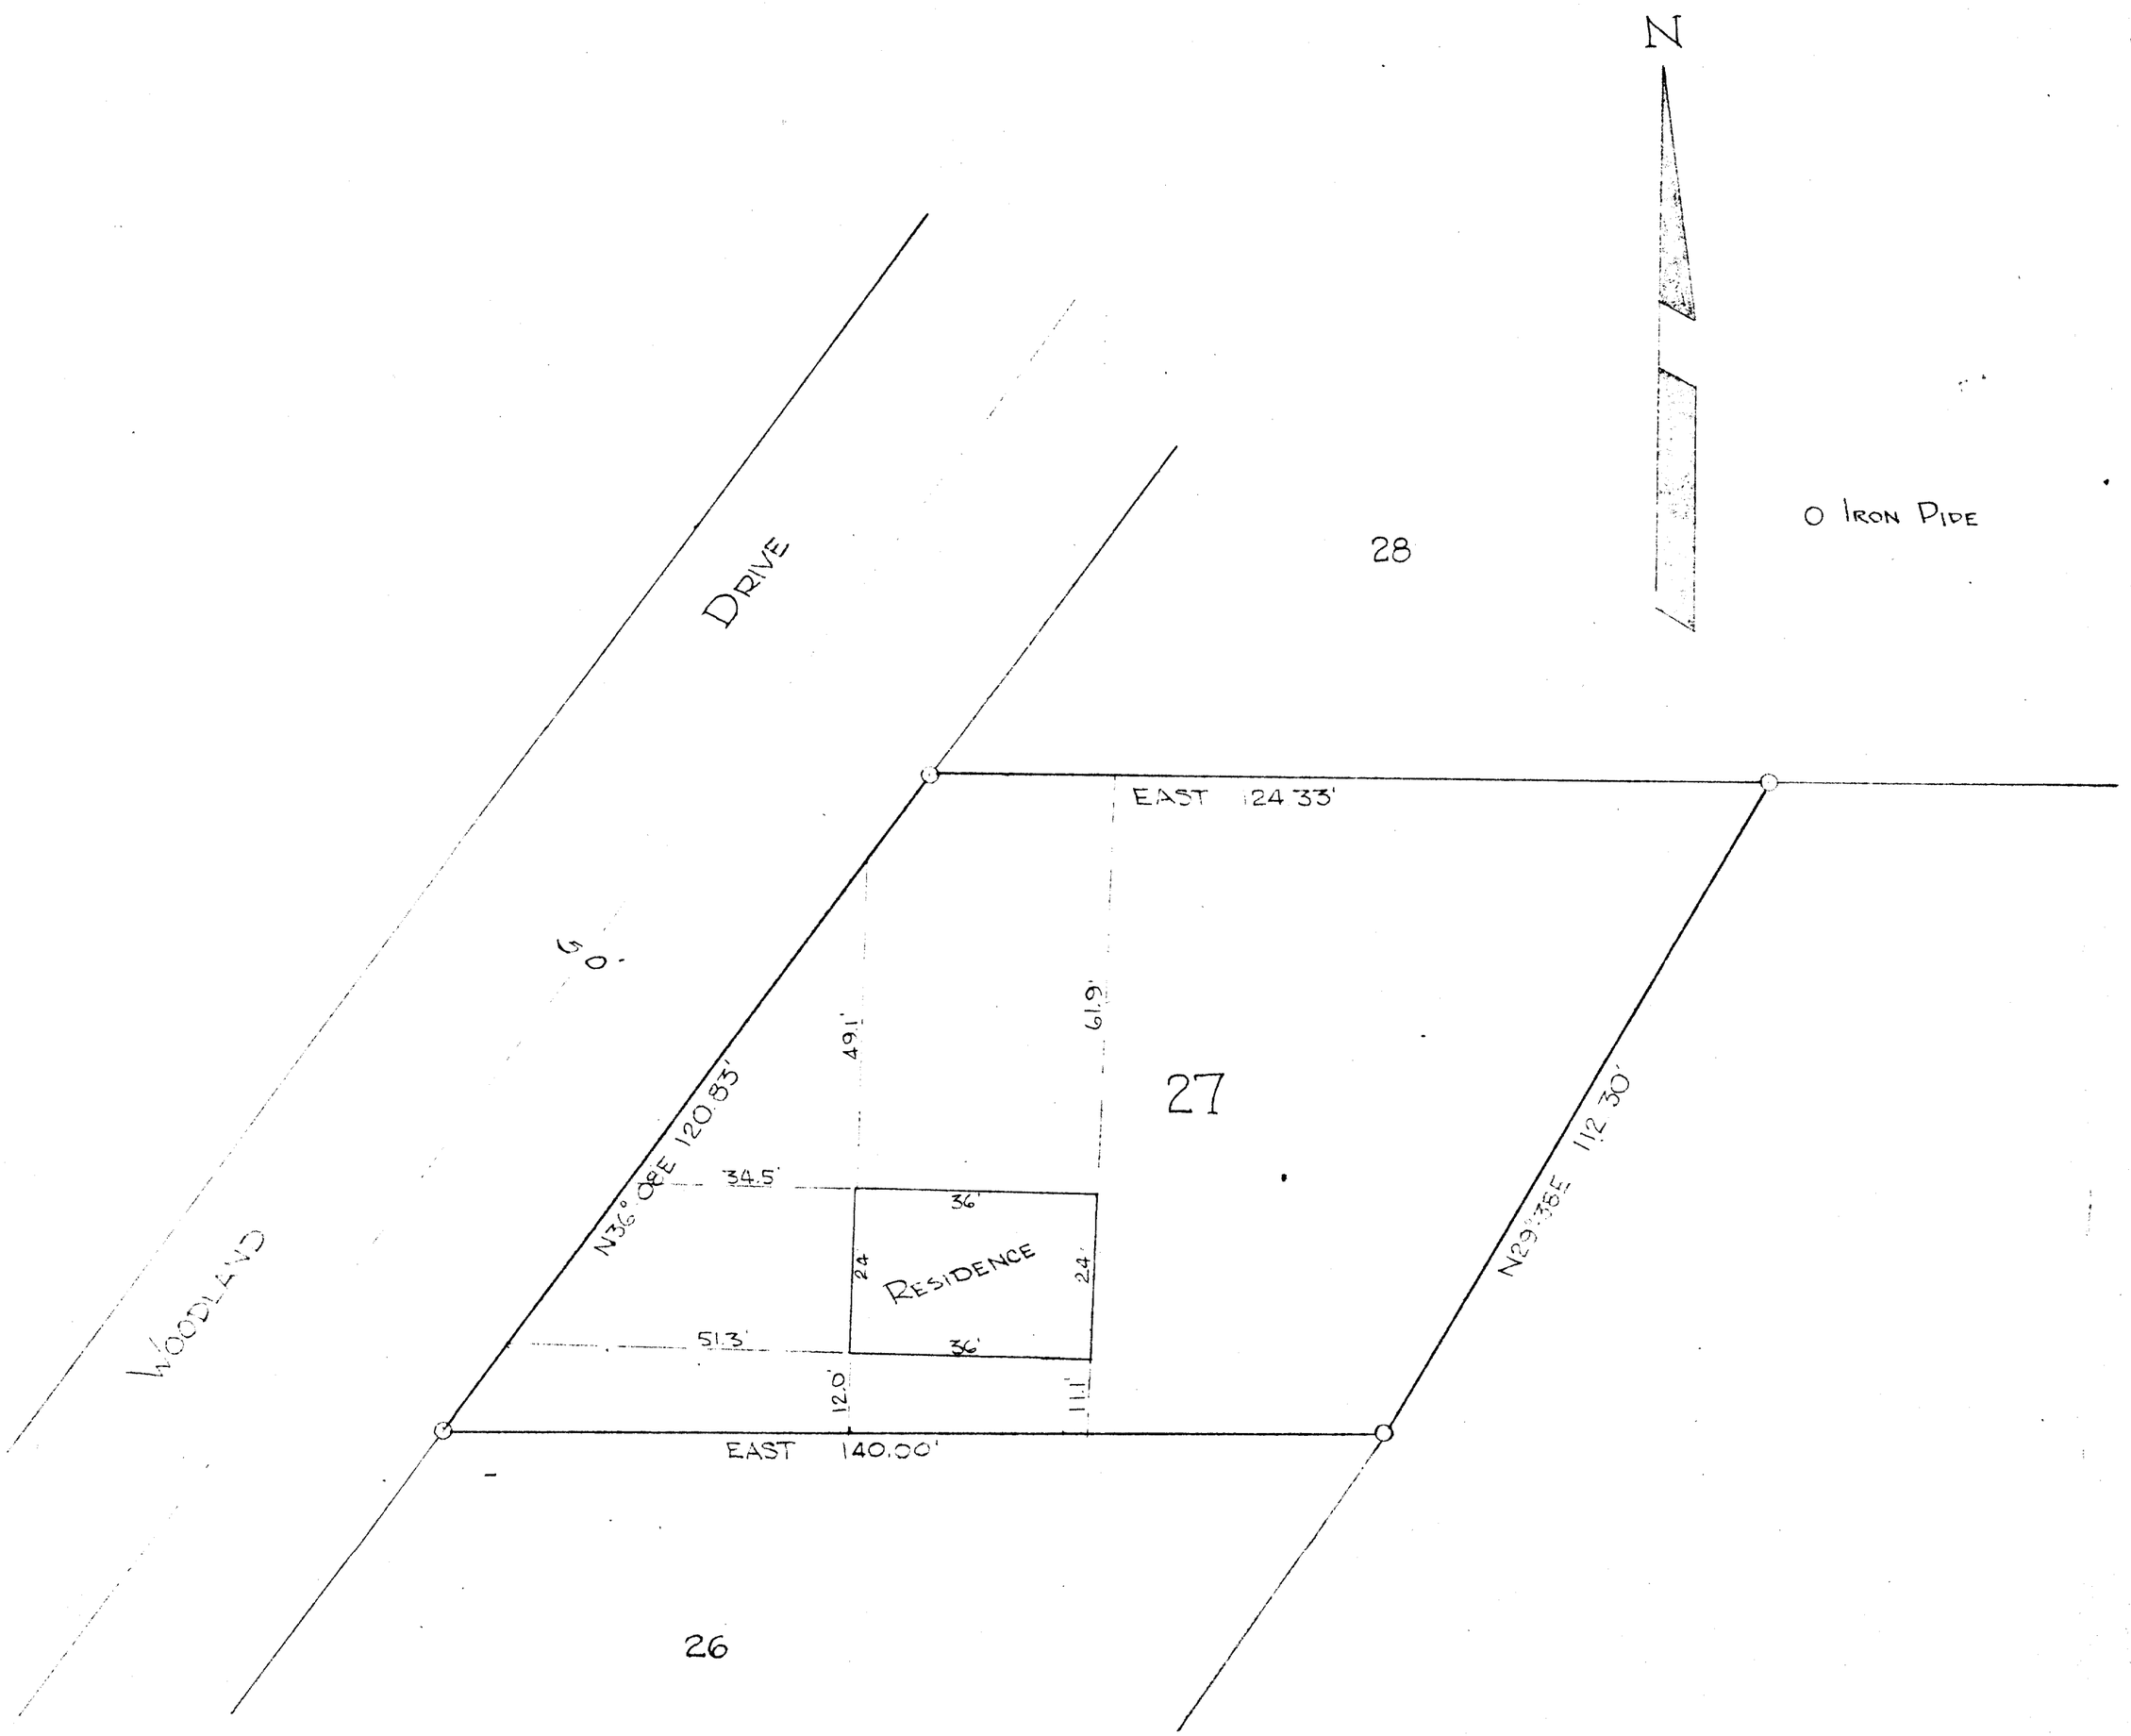


STATE OF WISCONSIN
COUNTY OF WALWORTH

I, LLOYD L. JENSEN, DO HEREBY CERTIFY THAT I HAVE SURVEYED THE PROPERTY DESCRIBED HEREON ACCORDING TO THE OFFICIAL RECORDS, AND THAT THE PLAT HEREON IS A CORRECT REPRESENTATION OF THE LOT LINES AND PRINCIPAL LINES OF BUILDINGS THEREON

ELKORN, WISCONSIN JULY 1955

Lloyd L Jensen
SURVEYOR

JULY 1955

PLAT OF SURVEY
OF
LOT 27
ADDITION E TO COUNTRY CLUB ESTATES
LOCATED IN
VILLAGE OF FONTANA, WALWORTH COUNTY, WIS.

Lloyd L Jensen
SURVEYOR

SCALE 1" = 60'

DATE July 1955

SCTE-27

NO. 17214—400—3-10-53

5-118