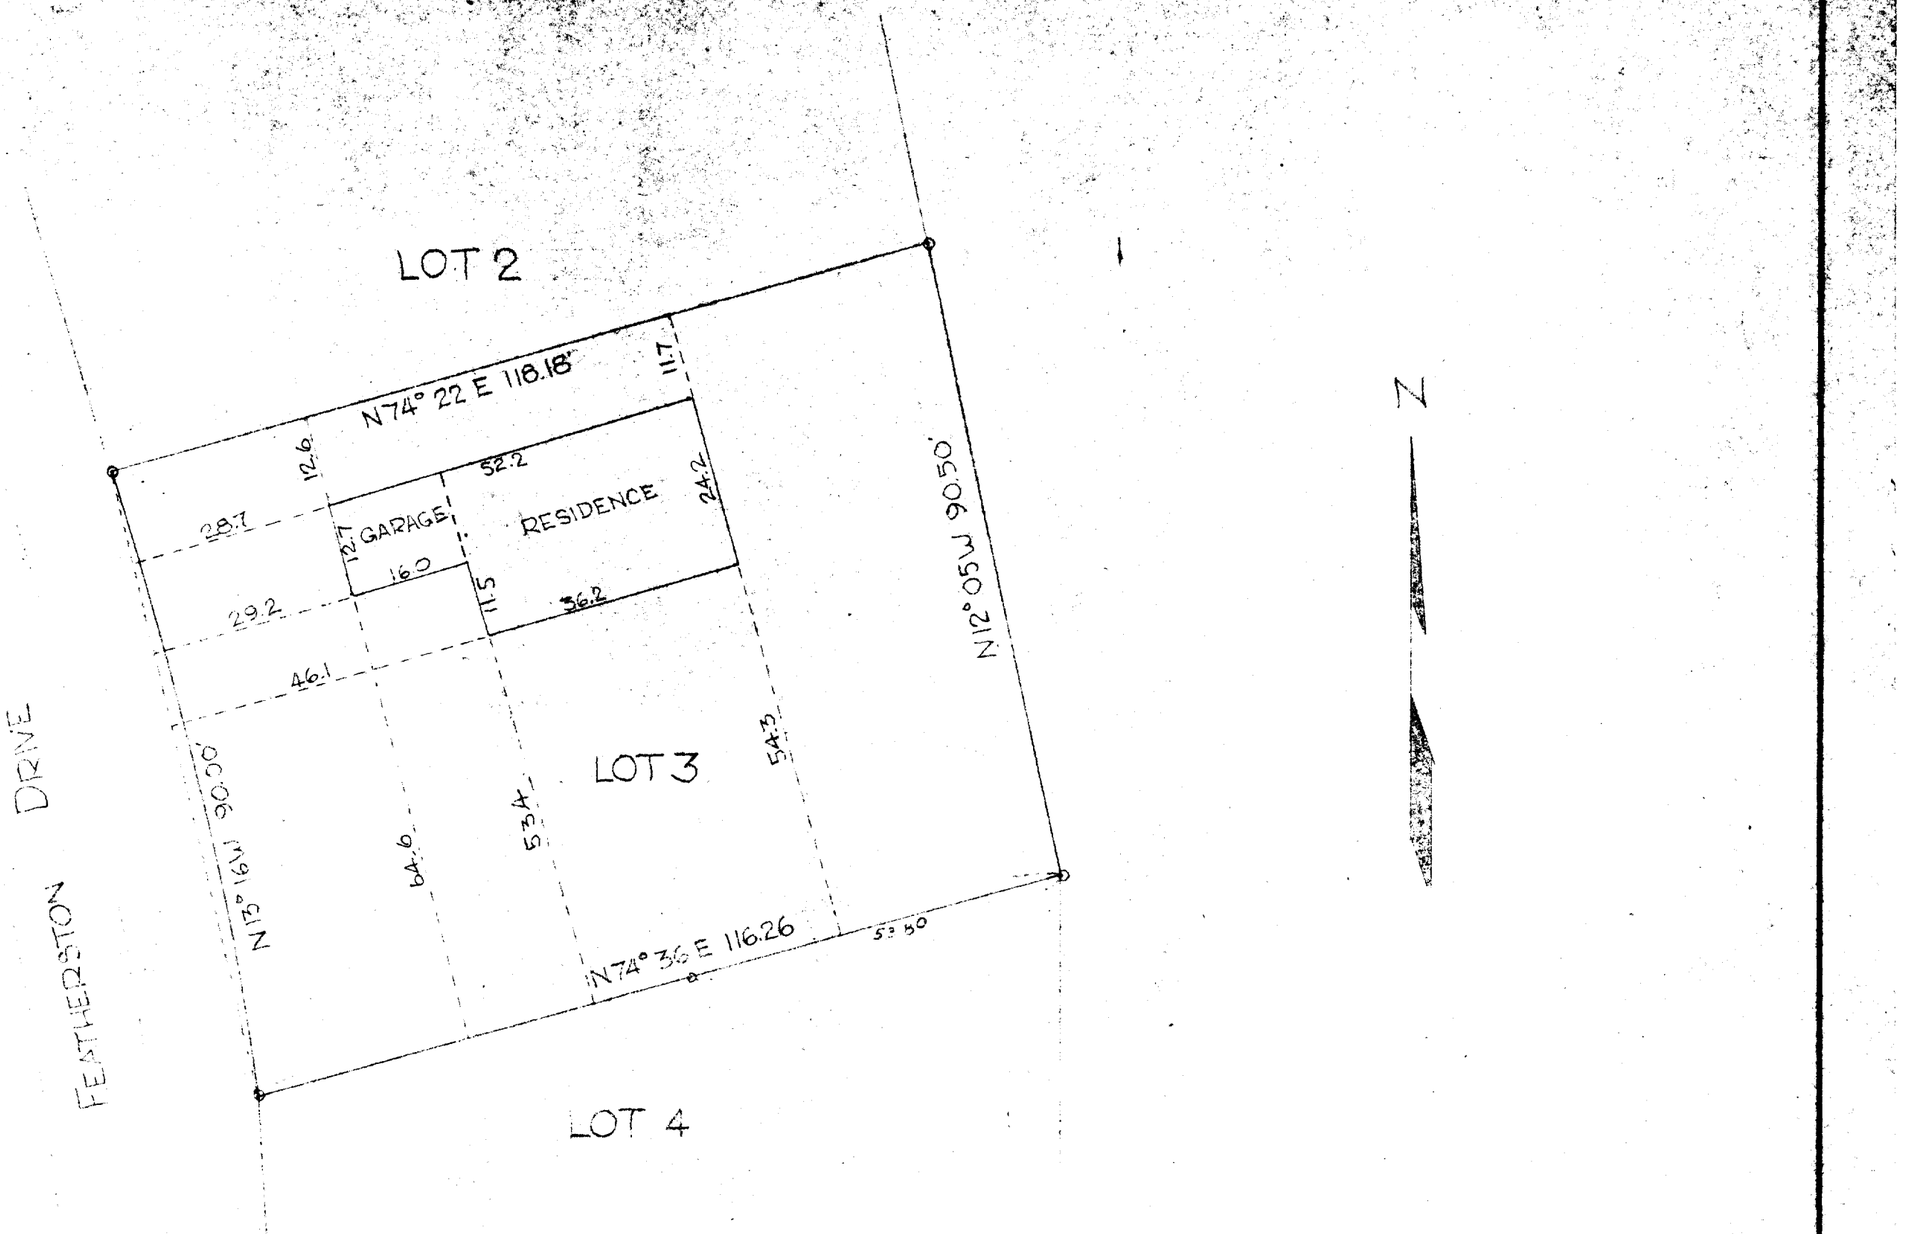


STATE OF WISCONSIN
COUNTY OF WALWORTH

I, LLOYD L. JENSEN, DO HEREBY CERTIFY THAT I HAVE SURVEYED THE PROPERTY HEREON DESCRIBED ACCORDING TO THE OFFICIAL RECORDS, AND THAT THE PLAT HEREON IS A CORRECT REPRESENTATION OF THE LOT LINES AND PRINCIPAL LINES OF BUILDINGS THEREON

ELKORN, WISCONSIN MAY 4 1955

Lloyd L. Jensen
SURVEYOR

I HEREBY CERTIFY THAT THE PLAT SHOWN HEREON IS A CORRECT REPRESENTATION OF THE LOT LINES AND PRINCIPAL LINES OF BUILDINGS THERE ON AS OF THIS DATE.
JULY 12, 1958

Lloyd L. Jensen
COUNTY SURVEYOR

PLAT OF SURVEY
OF
LOT 3 OF ADDITION 'A'
TO COUNTRY CLUB ESTATES
LOCATED IN THE
VILLAGE OF FONTANA-ON-GENEVA LAKE
WALWORTH COUNTY WISCONSIN

Lloyd L Jensen
SURVEYOR

SCALE 1" = 20'

DATE MAY 4 1955
REVISED JULY 1958

SCTA-3

5-120J