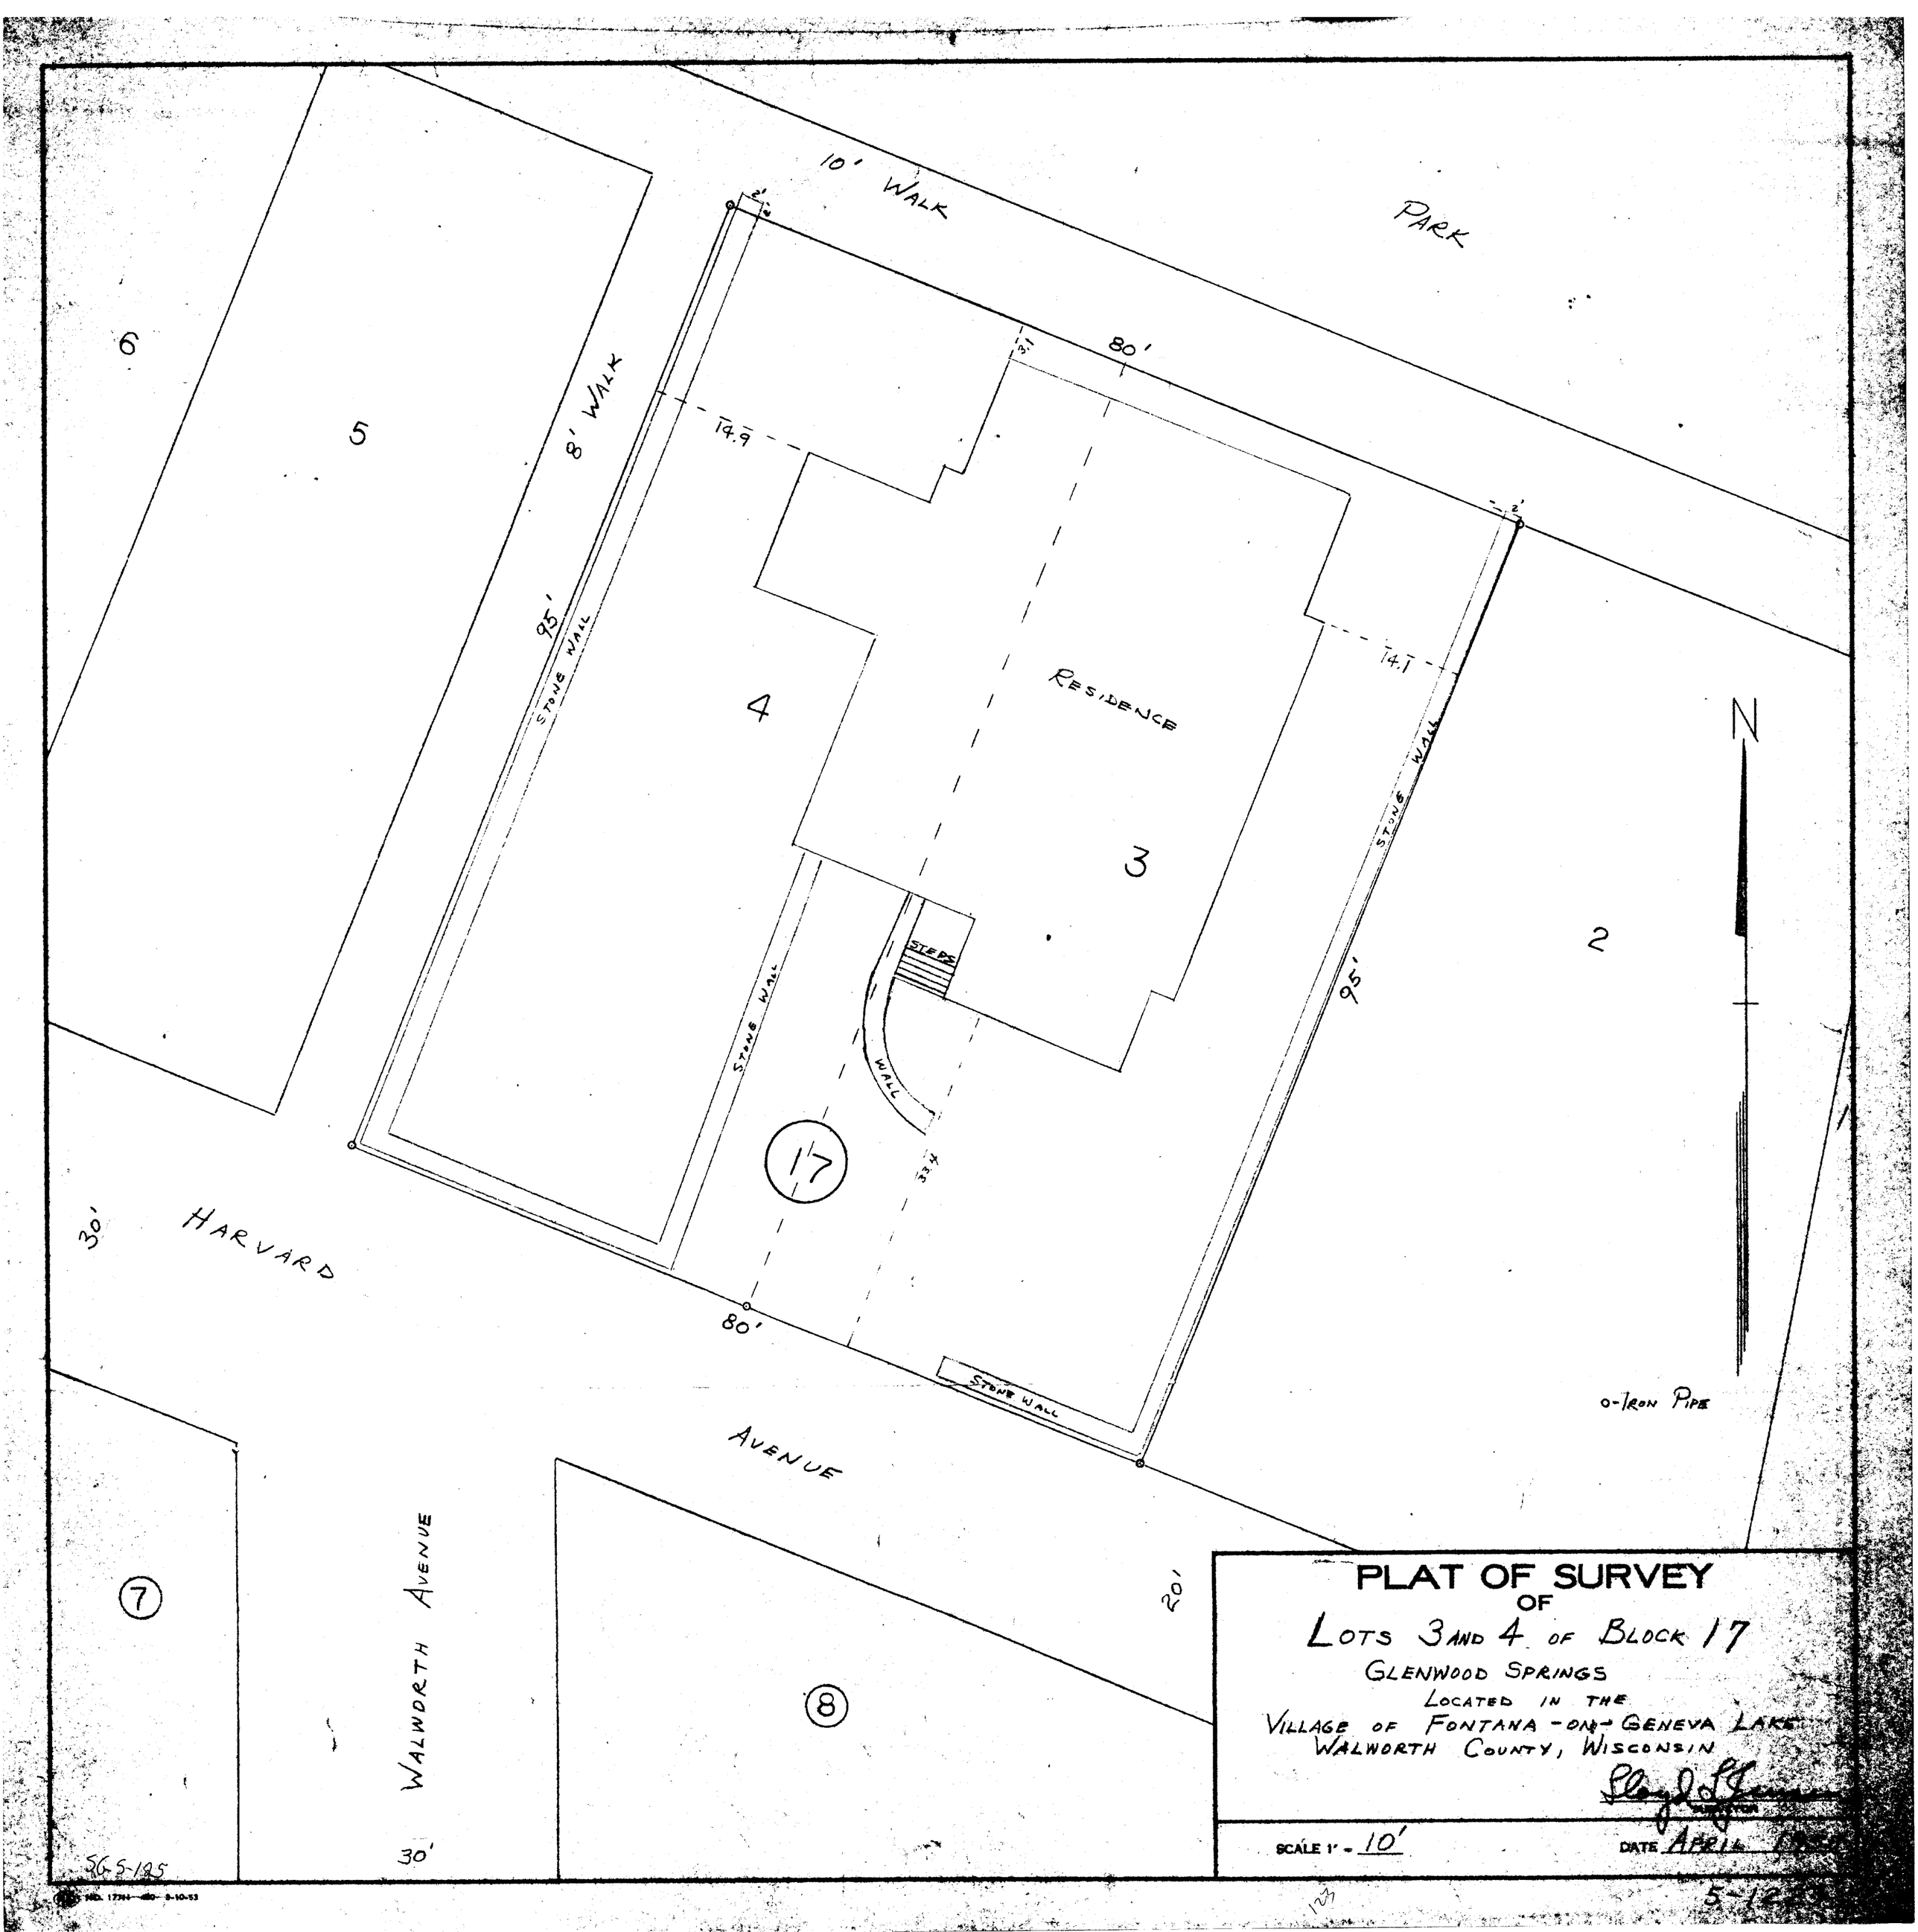


PLAT OF SURVEY
OF
LOTS 3 AND 4 OF BLOCK 17
GLENWOOD SPRINGS
LOCATED IN THE
VILLAGE OF FONTANA-ON-GENEVA LAKE
WALWORTH COUNTY, WISCONSIN

SCALE 1" = 10'

DATE APRIL

56-5-125

5-16