
WALWORTH COUNTY
SURVEYING & MAPPING
727 HENRY STREET
LAKE GENEVA, WISCONSIN
414-248-0505

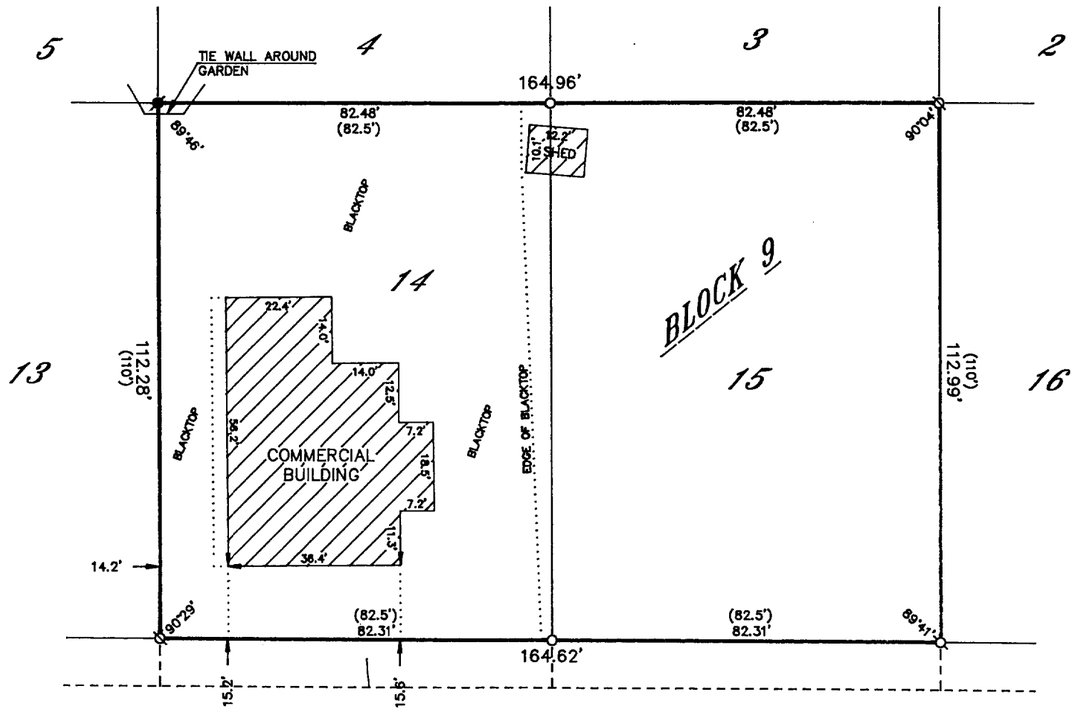

FONTANA BOULEVARD

GRAPHIC SCALE

30 0 15 30 60 120

(IN FEET)
1 inch = 30 ft.

LEGEND

- ⌀–IRON PIPE FOUND
- ⌀–IRON ROD FOUND
- ●–CONCRETE MONUMENT FOUND
- o–IRON PIPE PLACED
- ()–RECORDED AS

ASSUMED

PLAT OF SURVEY OF

LOTS 14 AND 15 IN BLOCK 9 OF THE ORIGINAL PLAT OF THE VILLAGE OF FONTANA–ON–GENEVA LAKE, WALWORTH COUNTY, WISCONSIN, EXCEPTING THE SOUTH 10 FEET OF SAID LOTS.

ORDERED BY: COLDWELL BANKER
GENEVA LAKES AREA REALTORS
838 MAIN STREET
LAKE GENEVA, WISCONSIN
53147

RECEIVED
DEC 16 1992

I HEREBY CERTIFY THAT I HAVE SURVEYED THE ABOVE DESCRIBED PROPERTY AND THAT THE ABOVE MAP IS A TRUE REPRESENTATION THEREOF AND SHOWS THE SIZE AND LOCATION OF THE PROPERTY, ITS EXTERIOR BOUNDARIES, THE LOCATION OF ALL VISIBLE STRUCTURES AND DIMENSIONS OF ALL PRINCIPAL BUILDINGS THEREON, BOUNDARY FENCES, APPARENT EASEMENTS, ROADWAYS AND VISIBLE ENCROACHMENTS, IF ANY, TO THE BEST OF MY KNOWLEDGE AND BELIEF.

THIS SURVEY IS MADE FOR THE USE OF THE PRESENT OWNERS OF THE PROPERTY AND ALSO THOSE WHO PURCHASE, MORTGAGE OR GUARANTEE THE TITLE THERETO WITHIN ONE (1) YEAR FROM DATE HEREOF.

Robert M. Baerenwald

ROBERT M. BAERENWALD
WISCONSIN REGISTERED LAND SURVEYOR, S–1508

Oct. 27, 1992
DATE JOB NO. 3632

NOTE: THIS IS NOT A CERTIFIED COPY UNLESS SEALED.

005-1237

SOP-54