
3

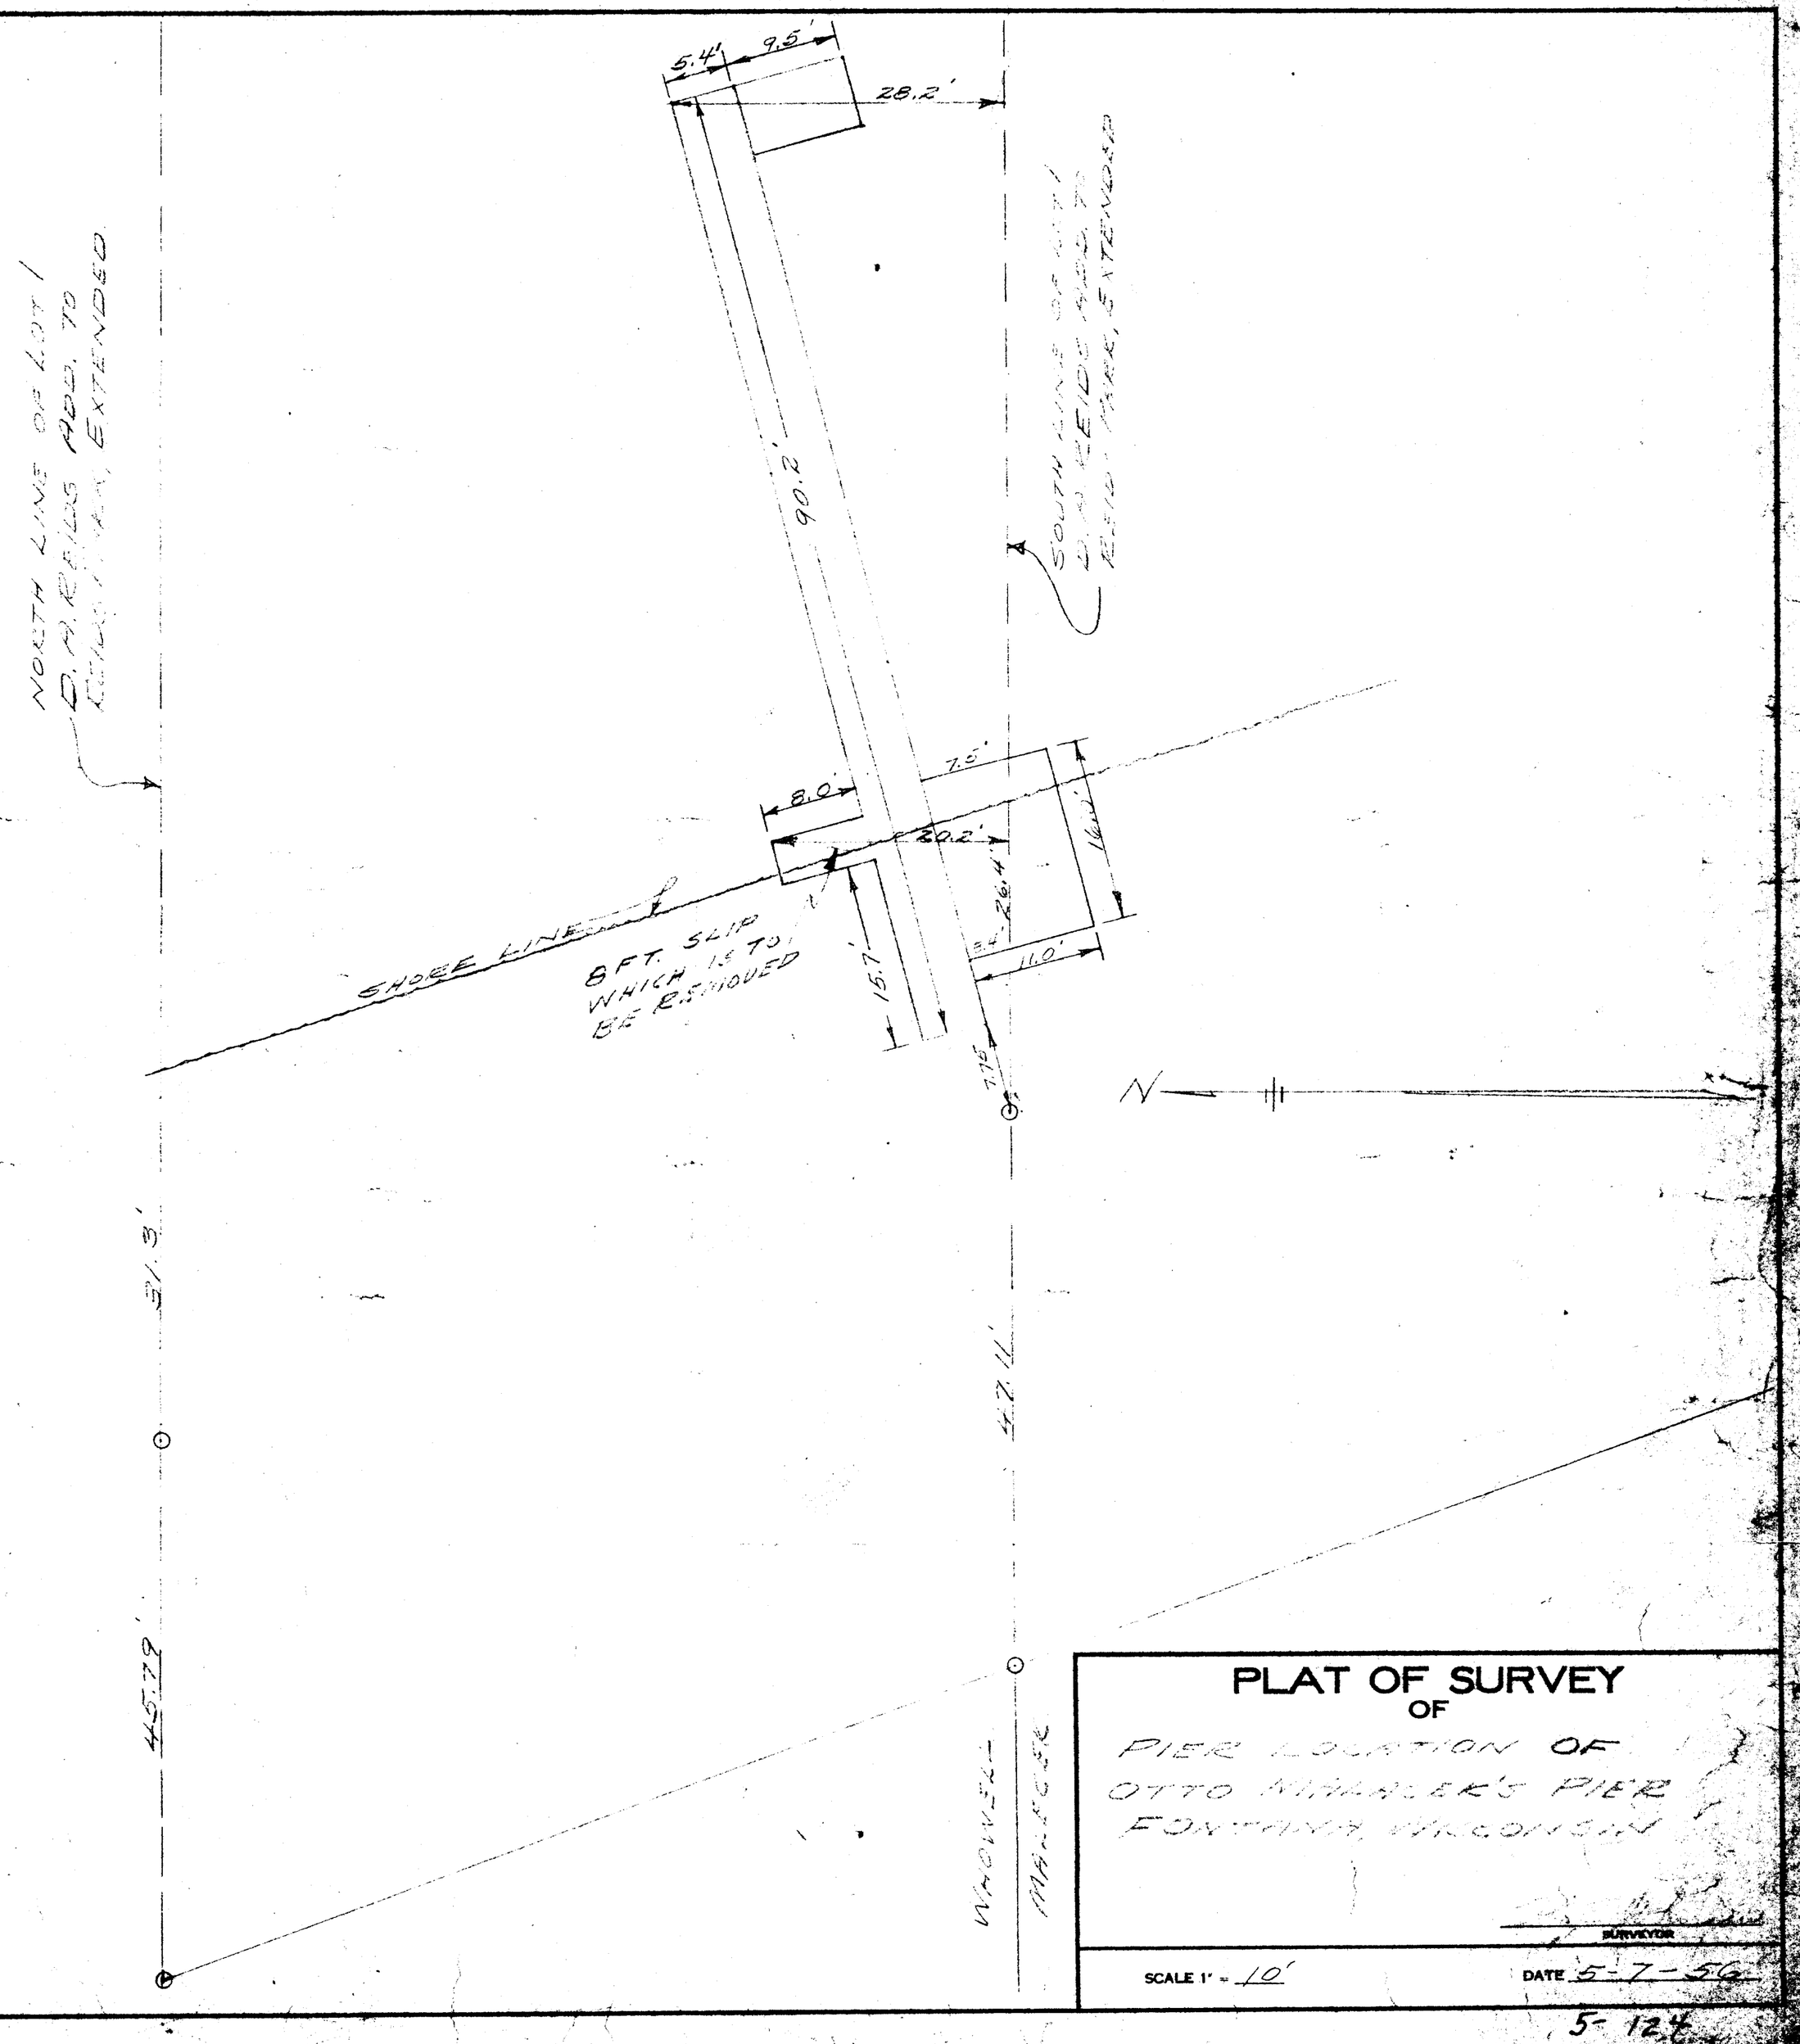

PLAT OF SURVEY
OF

PIER LOCATION OF

SURVEYOR

SCALE 1" = 10'

DATE 5-7-56

5-124

NO. 1784—400—3-10-53

RA-1