


DUNHAM SURVEYING, S.C.
SURVEYING & SUBDIVIDING
DELAVER, WISCONSIN 53115

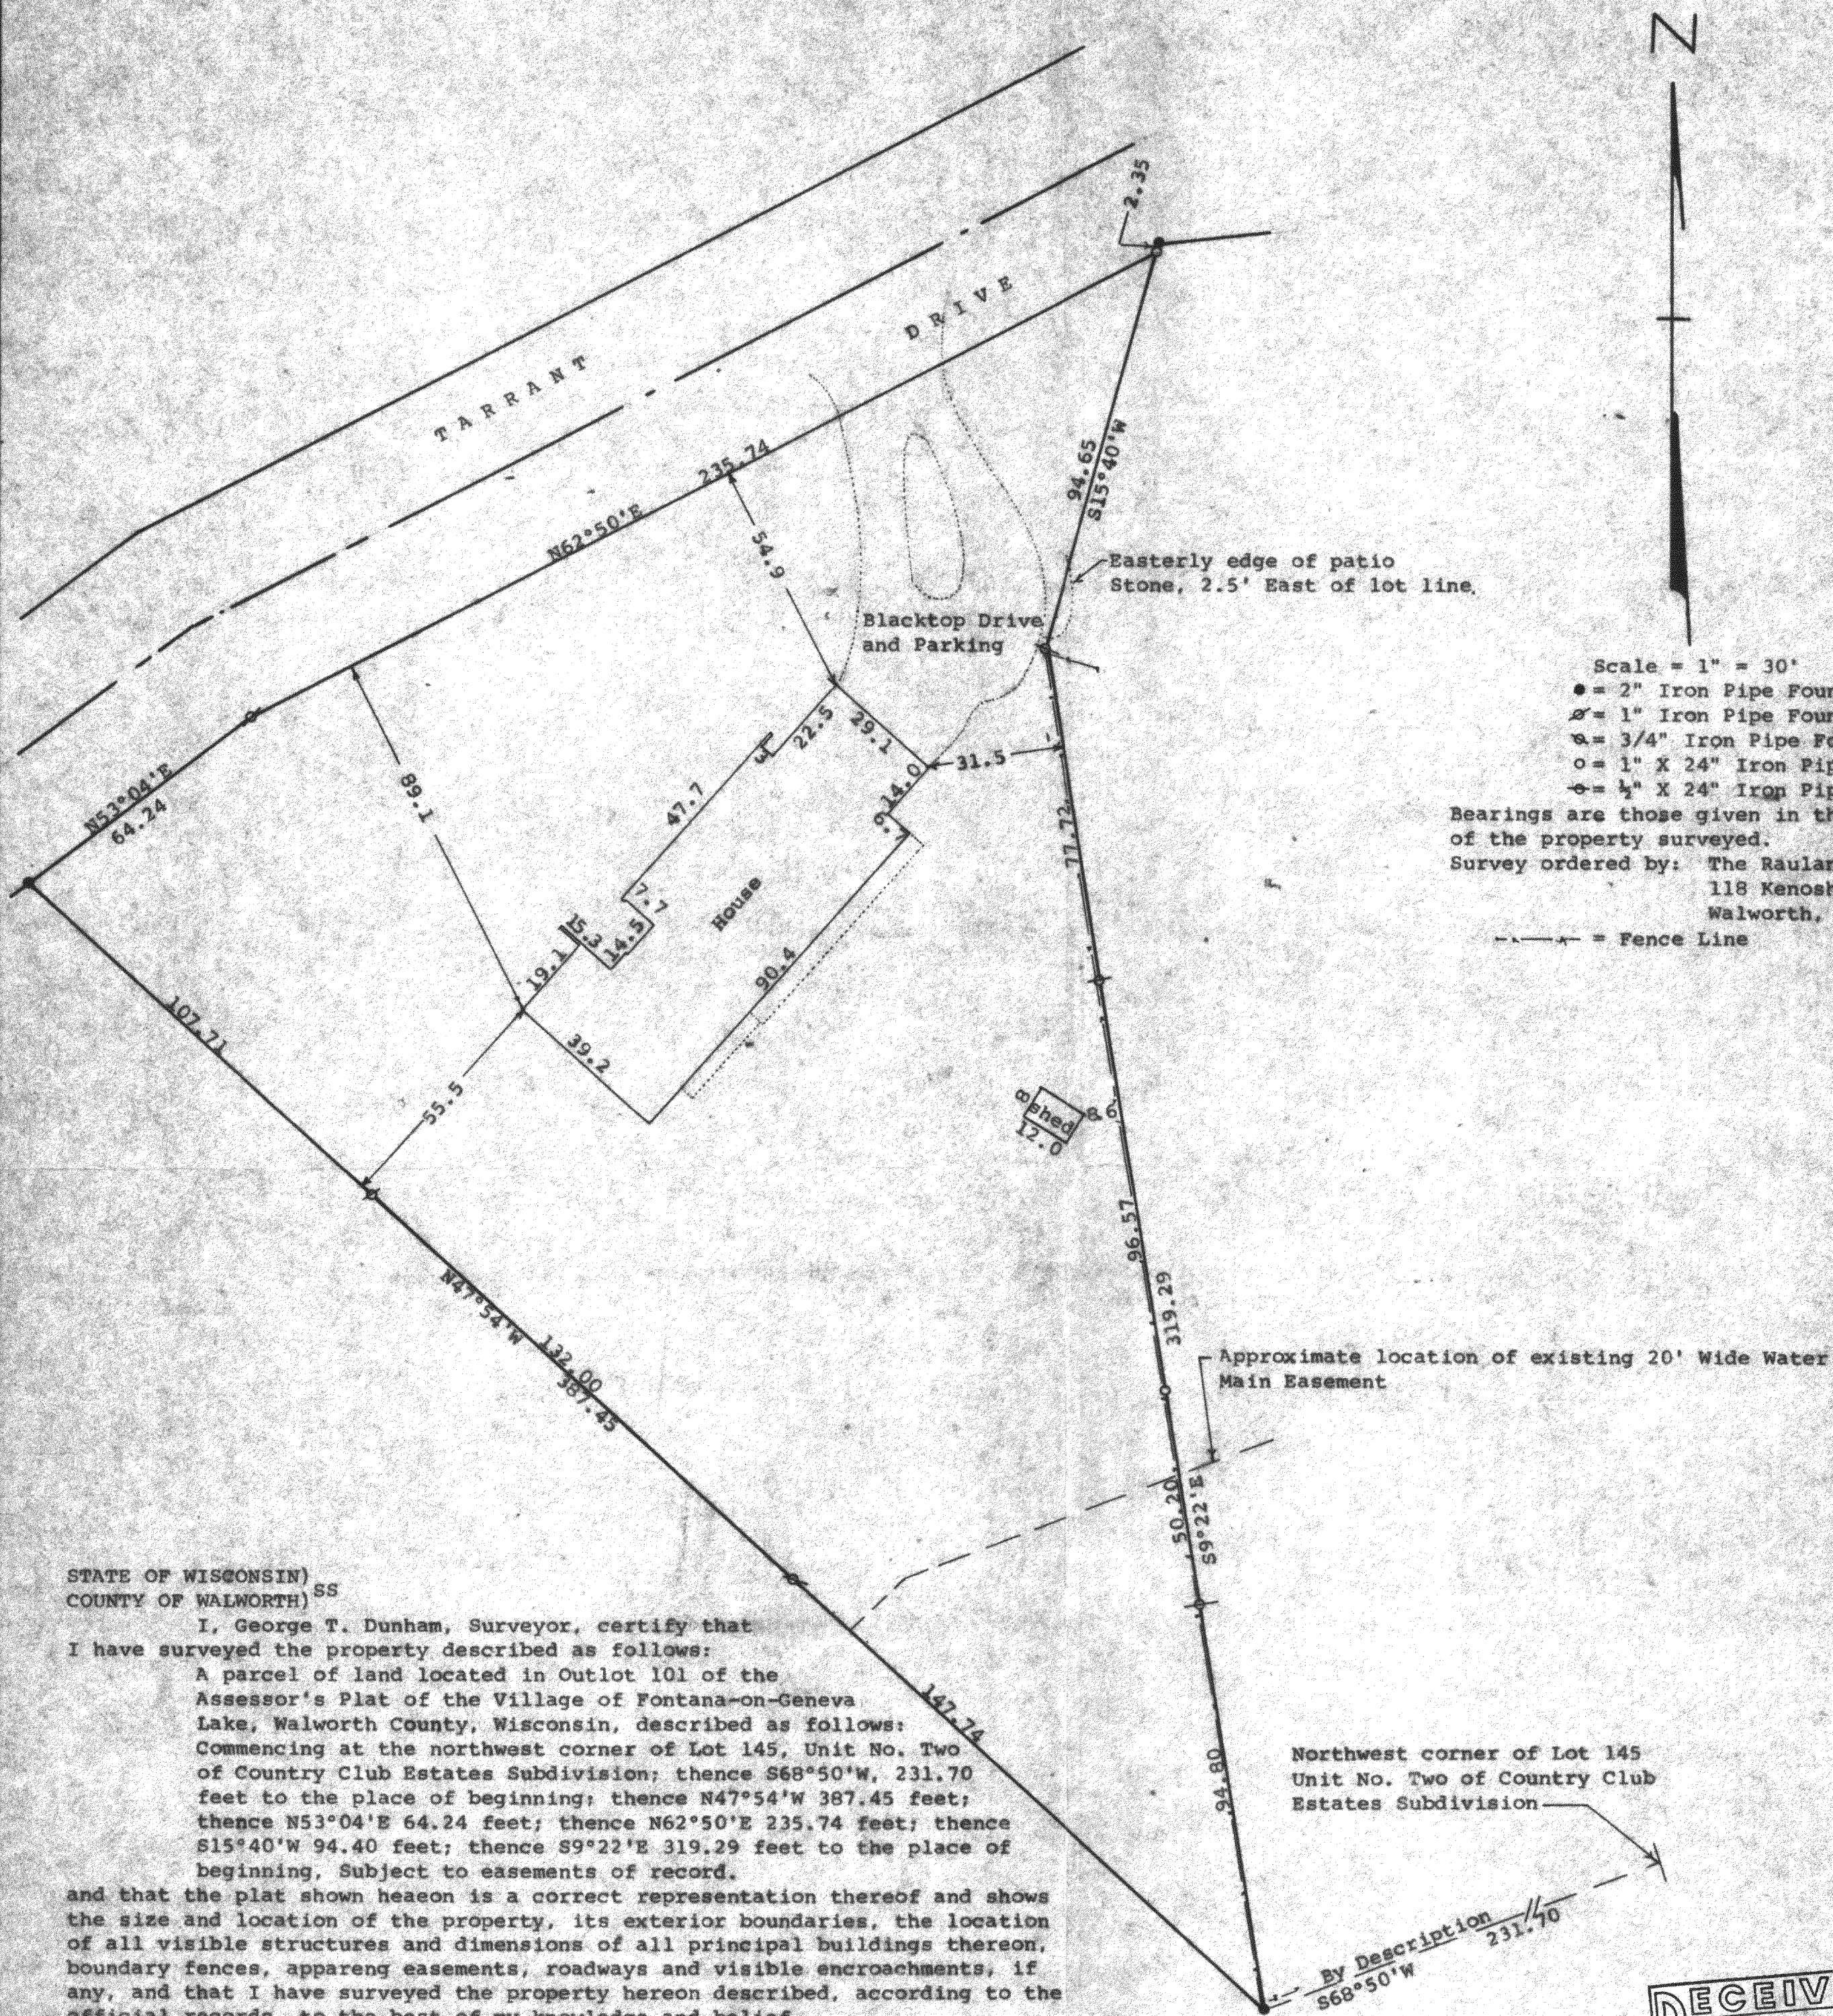

STATE OF WISCONSIN)
COUNTY OF WALWORTH) SS



I, George T. Dunham, Surveyor, certify that
I have surveyed the property described as follows:

A parcel of land located in Outlot 101 of the Assessor's Plat of the Village of Fontana-on-Geneva Lake, Walworth County, Wisconsin, described as follows:
Commencing at the northwest corner of Lot 145, Unit No. Two of Country Club Estates Subdivision; thence S68°50'W, 231.70 feet to the place of beginning; thence N47°54'W 387.45 feet; thence N53°04'E 64.24 feet; thence N62°50'E 235.74 feet; thence S15°40'W 94.40 feet; thence S9°22'E 319.29 feet to the place of beginning, Subject to easements of record.

and that the plat shown hereon is a correct representation thereof and shows the size and location of the property, its exterior boundaries, the location of all visible structures and dimensions of all principal buildings thereon, boundary fences, apparent easements, roadways and visible encroachments, if any, and that I have surveyed the property hereon described, according to the official records, to the best of my knowledge and belief.

May 6, 1992

George T. Dunham
George T. Dunham, Surveyor

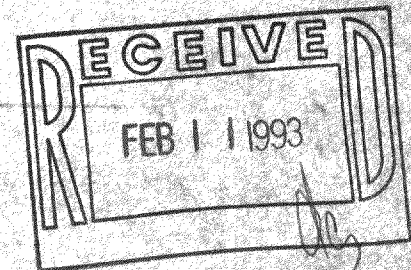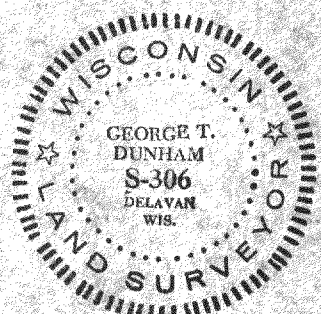

STFV-150A

005-1256