
HAROLD H. KOLB
REGISTERED PROFESSIONAL LAND SURVEYOR
LAKE GENEVA, WISCONSIN

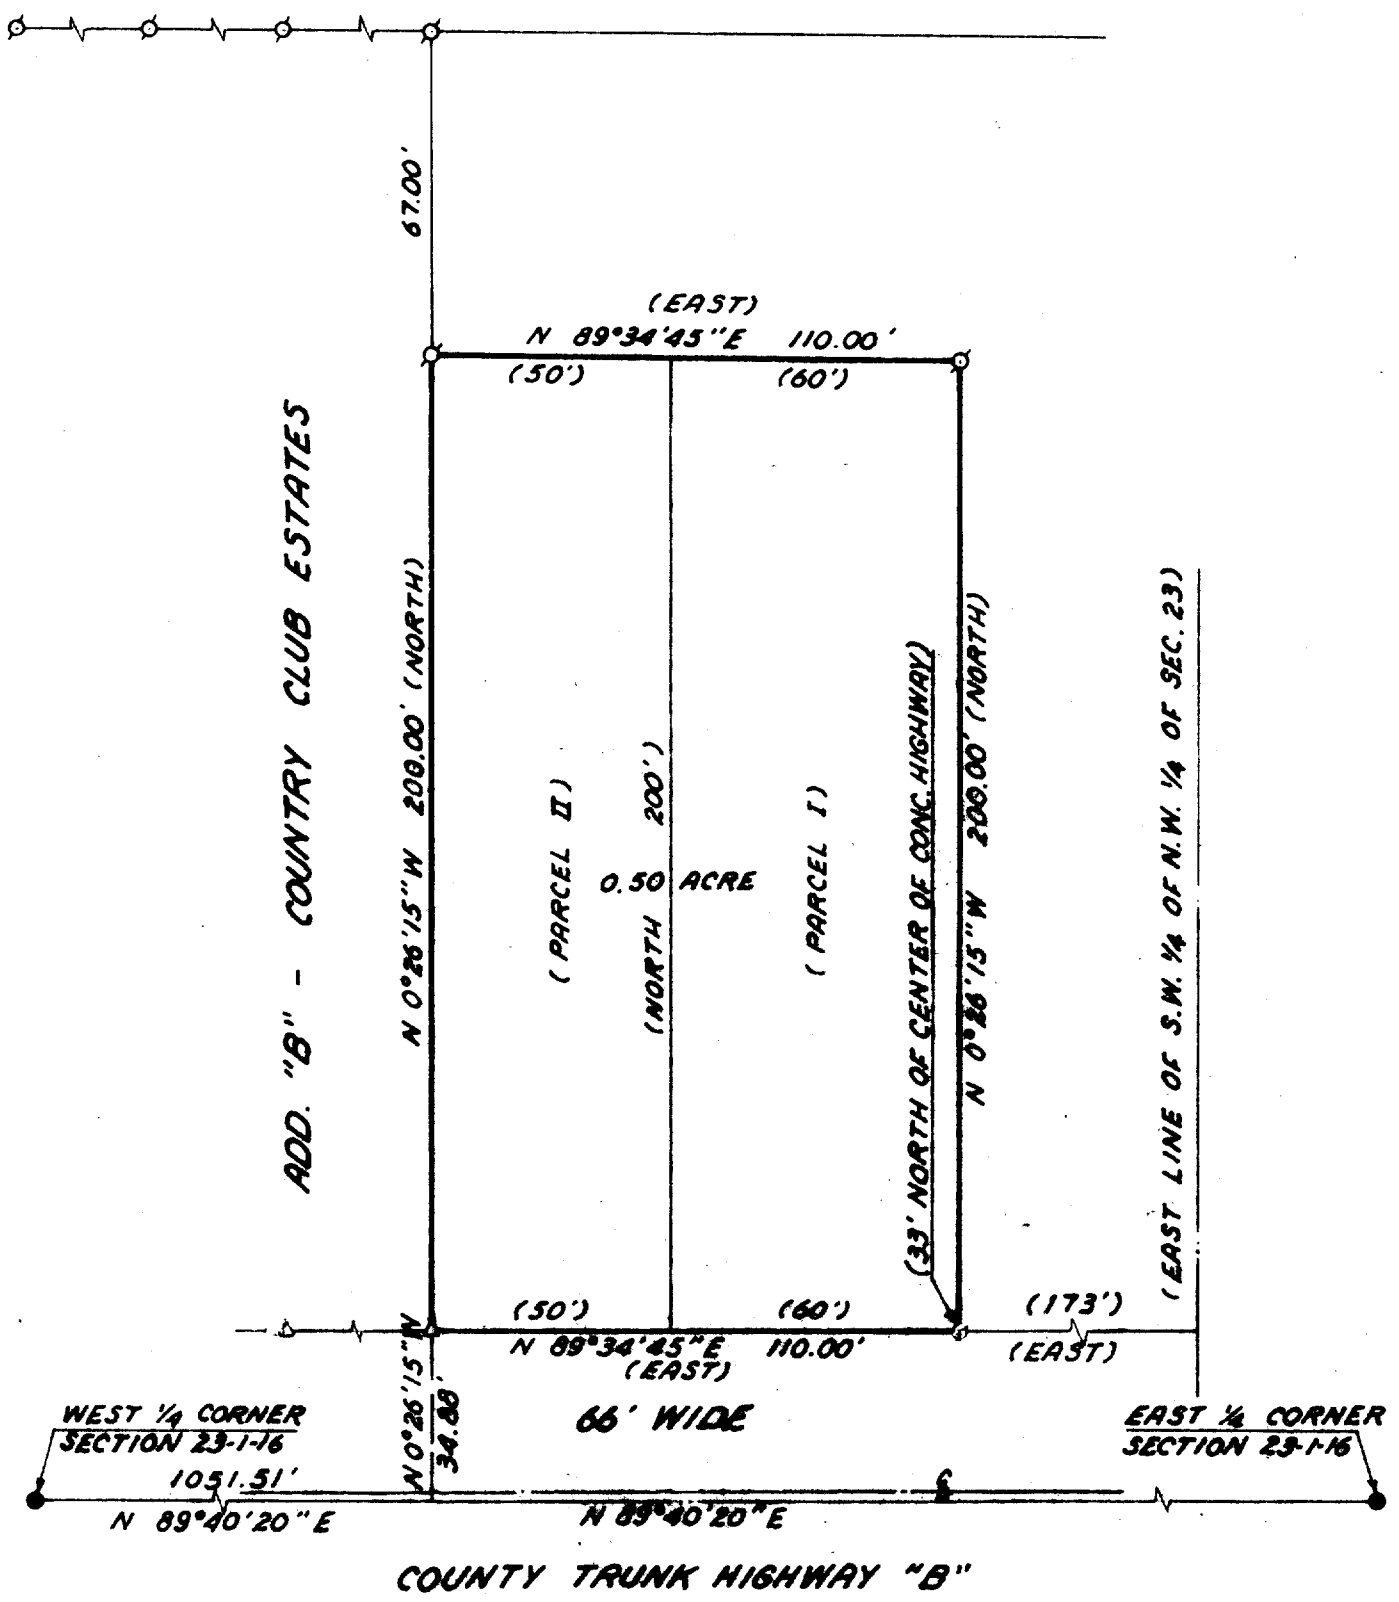

PLAT OF SURVEY OF

A parcel of land located in the Northwest 1/4 of Section 23, T 1 N, R 16 E, Walworth County, Wisconsin.

ORDERED BY: Lorraine Sullivan

ACCURACY: Distances ±0.01'
Angles ±05"
Error of Closure-less than one part in 3000

NOTE: The East-West ¼ line of Section 23, T1N, R16E, is assumed N 89°40'20" E from existing survey records.

N

SCALE: 1"=40'

LEGEND

- ϕ — IRON PIPE FOUND
- O — IRON PIPE PLACED
- ● — CONCRETE MONUMENT
- x — SPIKE
- Δ — IRON ROD FOUND
- ()- DESCRIBED AS

WISCONSIN HAROLD H. KOLB S-187 LAKE GENEVA, WIS. LAND SURVEYOR

I. HAROLD H. KOLB, DO HEREBY CERTIFY THAT I HAVE SURVEYED THE PROPERTY HEREON DESCRIBED ACCORDING TO THE OFFICIAL RECORDS AND THAT THE PLAT HEREON IS A CORRECT REPRESENTATION OF THE LOT LINES.

HAROLD H. KOLB
WISCONSIN REGISTERED LAND SURVEYOR, S-187
DATE July 21, 1976

STFV-161 (O.L.-107)

#5137/H

BRUNING 40-108 500-6-71