
ROBERS & FISCHER, INC.
CONSULTING ENGINEERS & LAND SURVEYORS
PHONE (414) 763-2652 116 E. CHESTNUT ST. BURLINGTON, WIS. 53105

Plat of Survey
of

The South 30.43 feet of LOT 1, Block 1, D.A. Reid's Addition Reid's Park, except South 15 feet, Fontana-on-Geneva, Walworth County, Wisconsin.

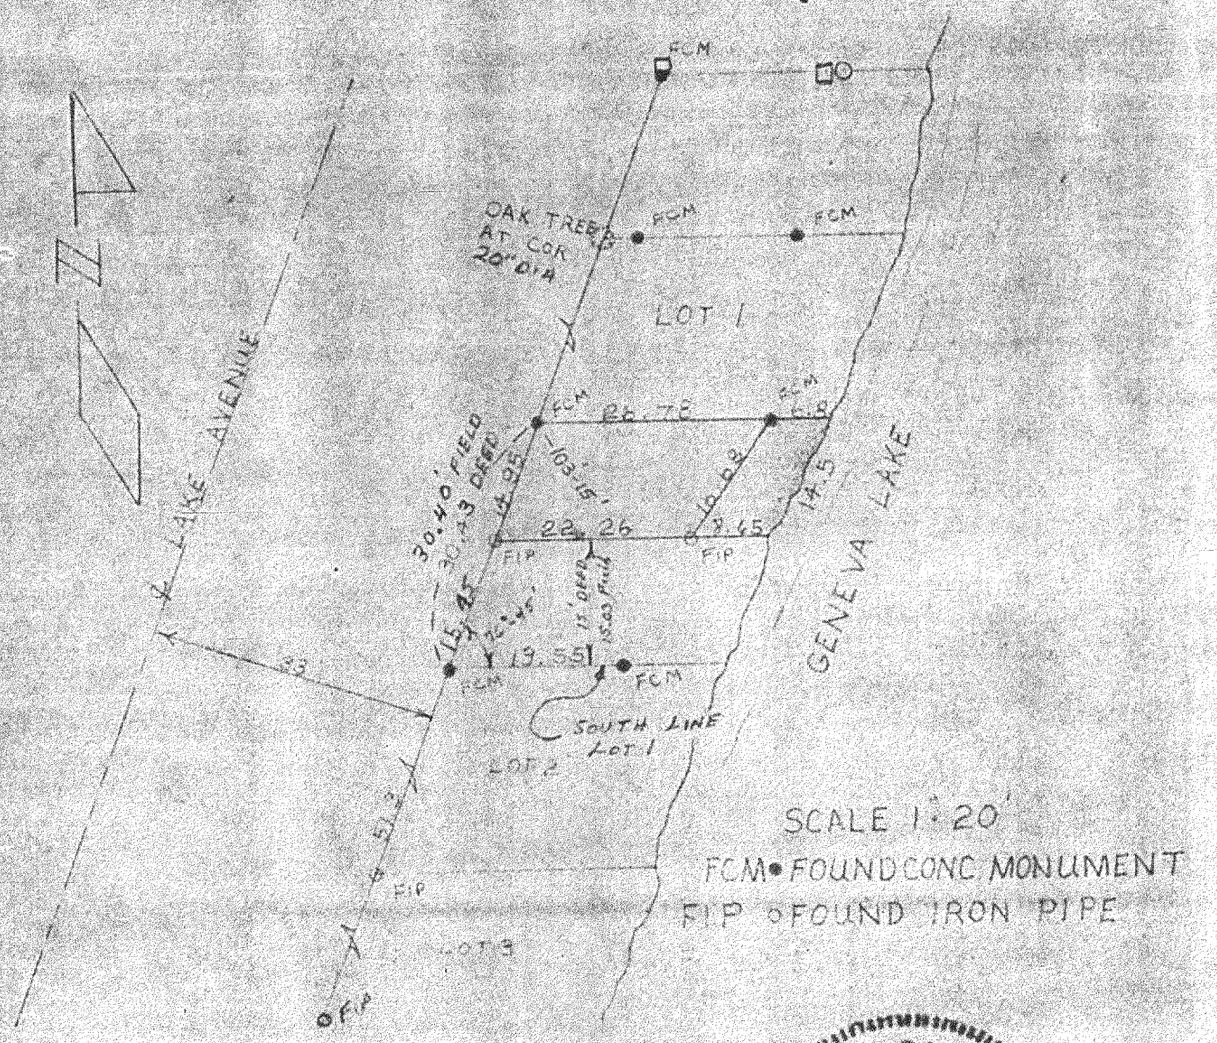

WISCONSIN
CHARLES R. FISCHER
FONTANA, WISCONSIN
LAND SURVEYOR

I HEREBY CERTIFY THAT WE HAVE SURVEYED THE LANDS DESCRIBED ABOVE ACCORDING TO OFFICIAL RECORDS AND THAT THE PLAT DRAWN HEREON IS A CORRECT REPRESENTATION OF SAID SURVEY.

Charles R. Fischer
WIS. REG. LAND SURVEYOR S-821

DATE July 30, 1970

5-149

JOB NO. 70109

SRA-2