
ROBERS & FISCHER, INC.

~~HOGANSON & ROBERS, INC.~~

CONSULTING ENGINEERS & LAND SURVEYORS

PHONE (414) 763-2652 116 E. CHESTNUT ST. BURLINGTON, WIS. 53105

LOT 6, BLOCK 5, C. L. DOUGLAS SUB. (ASSESSOR PLAT NO. 1), VILLAGE OF FONTANA, WALWORTH CO, WIS.

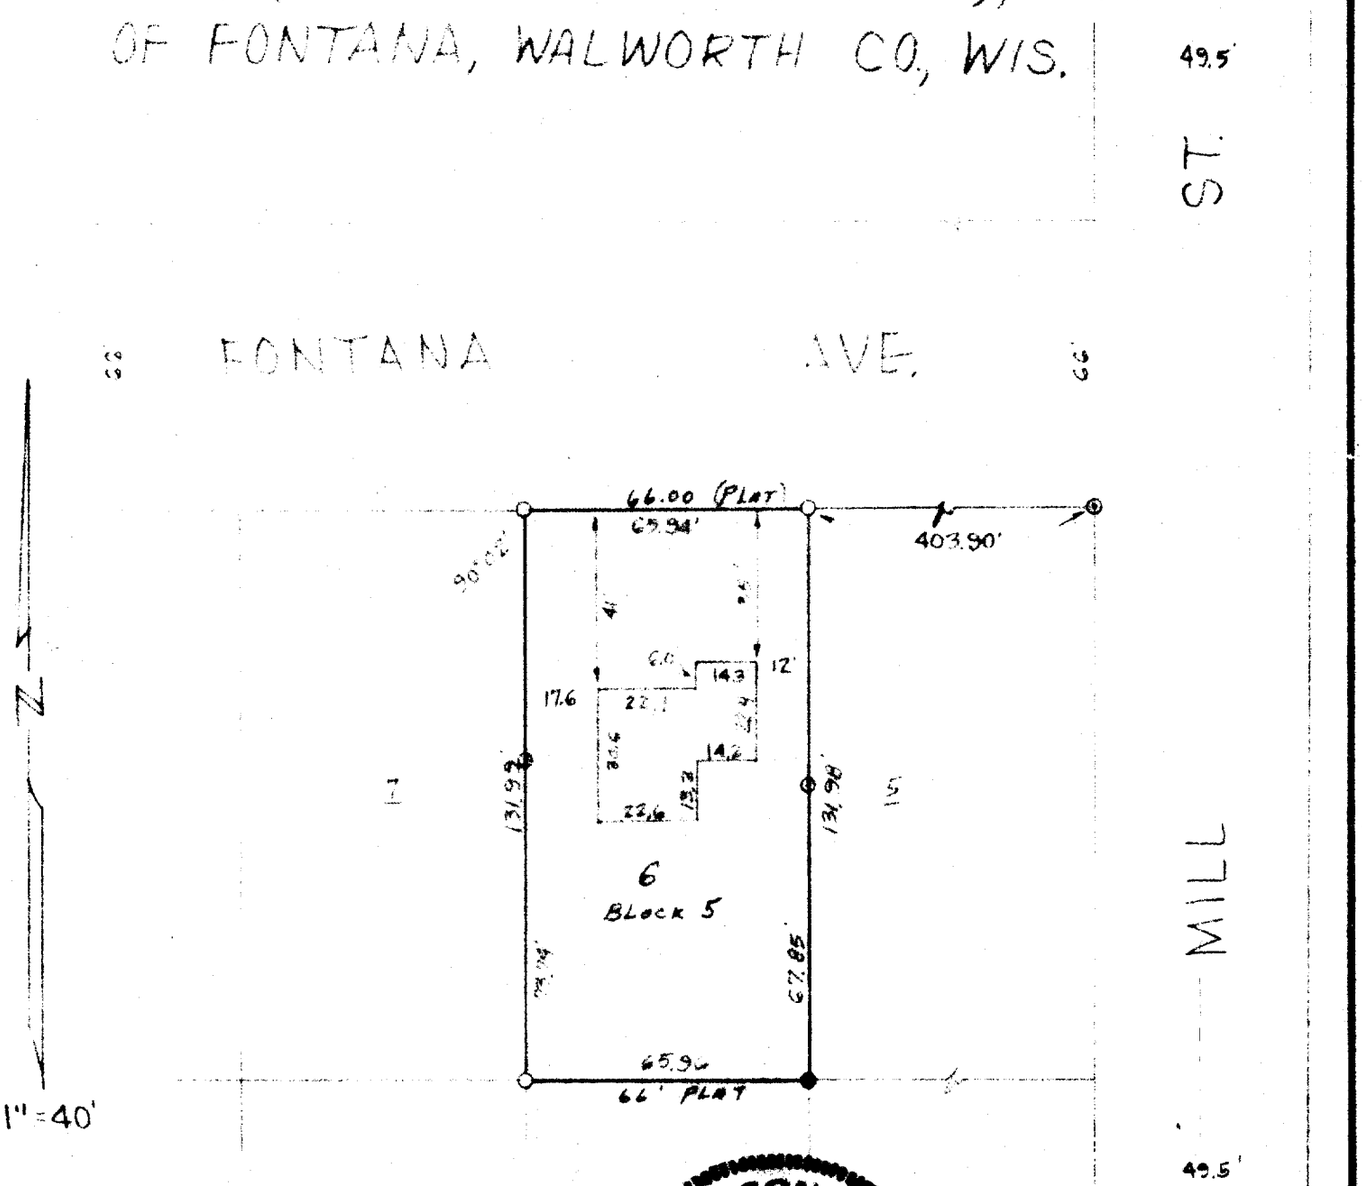

BLOCK 5 NORTH LINE 0.95' SHORT OR 0.00086 FT/FT

66' LOT = 65.94'

WISCONSIN
CHARLES R. FISCHER
FONTANA, WISCONSIN
LAND SURVEYOR

MONUMENT KEY

- ○ IRON PIPE SET
- ⊙ CONC. MON. FOUND
- ● IRON PIPE FOUND

I HEREBY CERTIFY THAT WE HAVE SURVEYED THE LANDS DESCRIBED ABOVE ACCORDING TO OFFICIAL RECORDS AND THAT THE PLAT DRAWN HEREON IS A CORRECT REPRESENTATION OF SAID SURVEY.

Charles R. Fischer
WIS. REG. LAND SURVEYOR S-821

DATE 7-8-70 5-151 JOB NO. 70092

STFU-233